
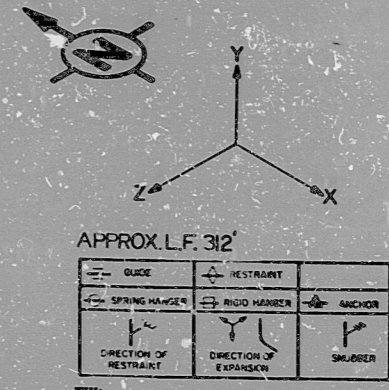


H-603 SH.2 (Q)

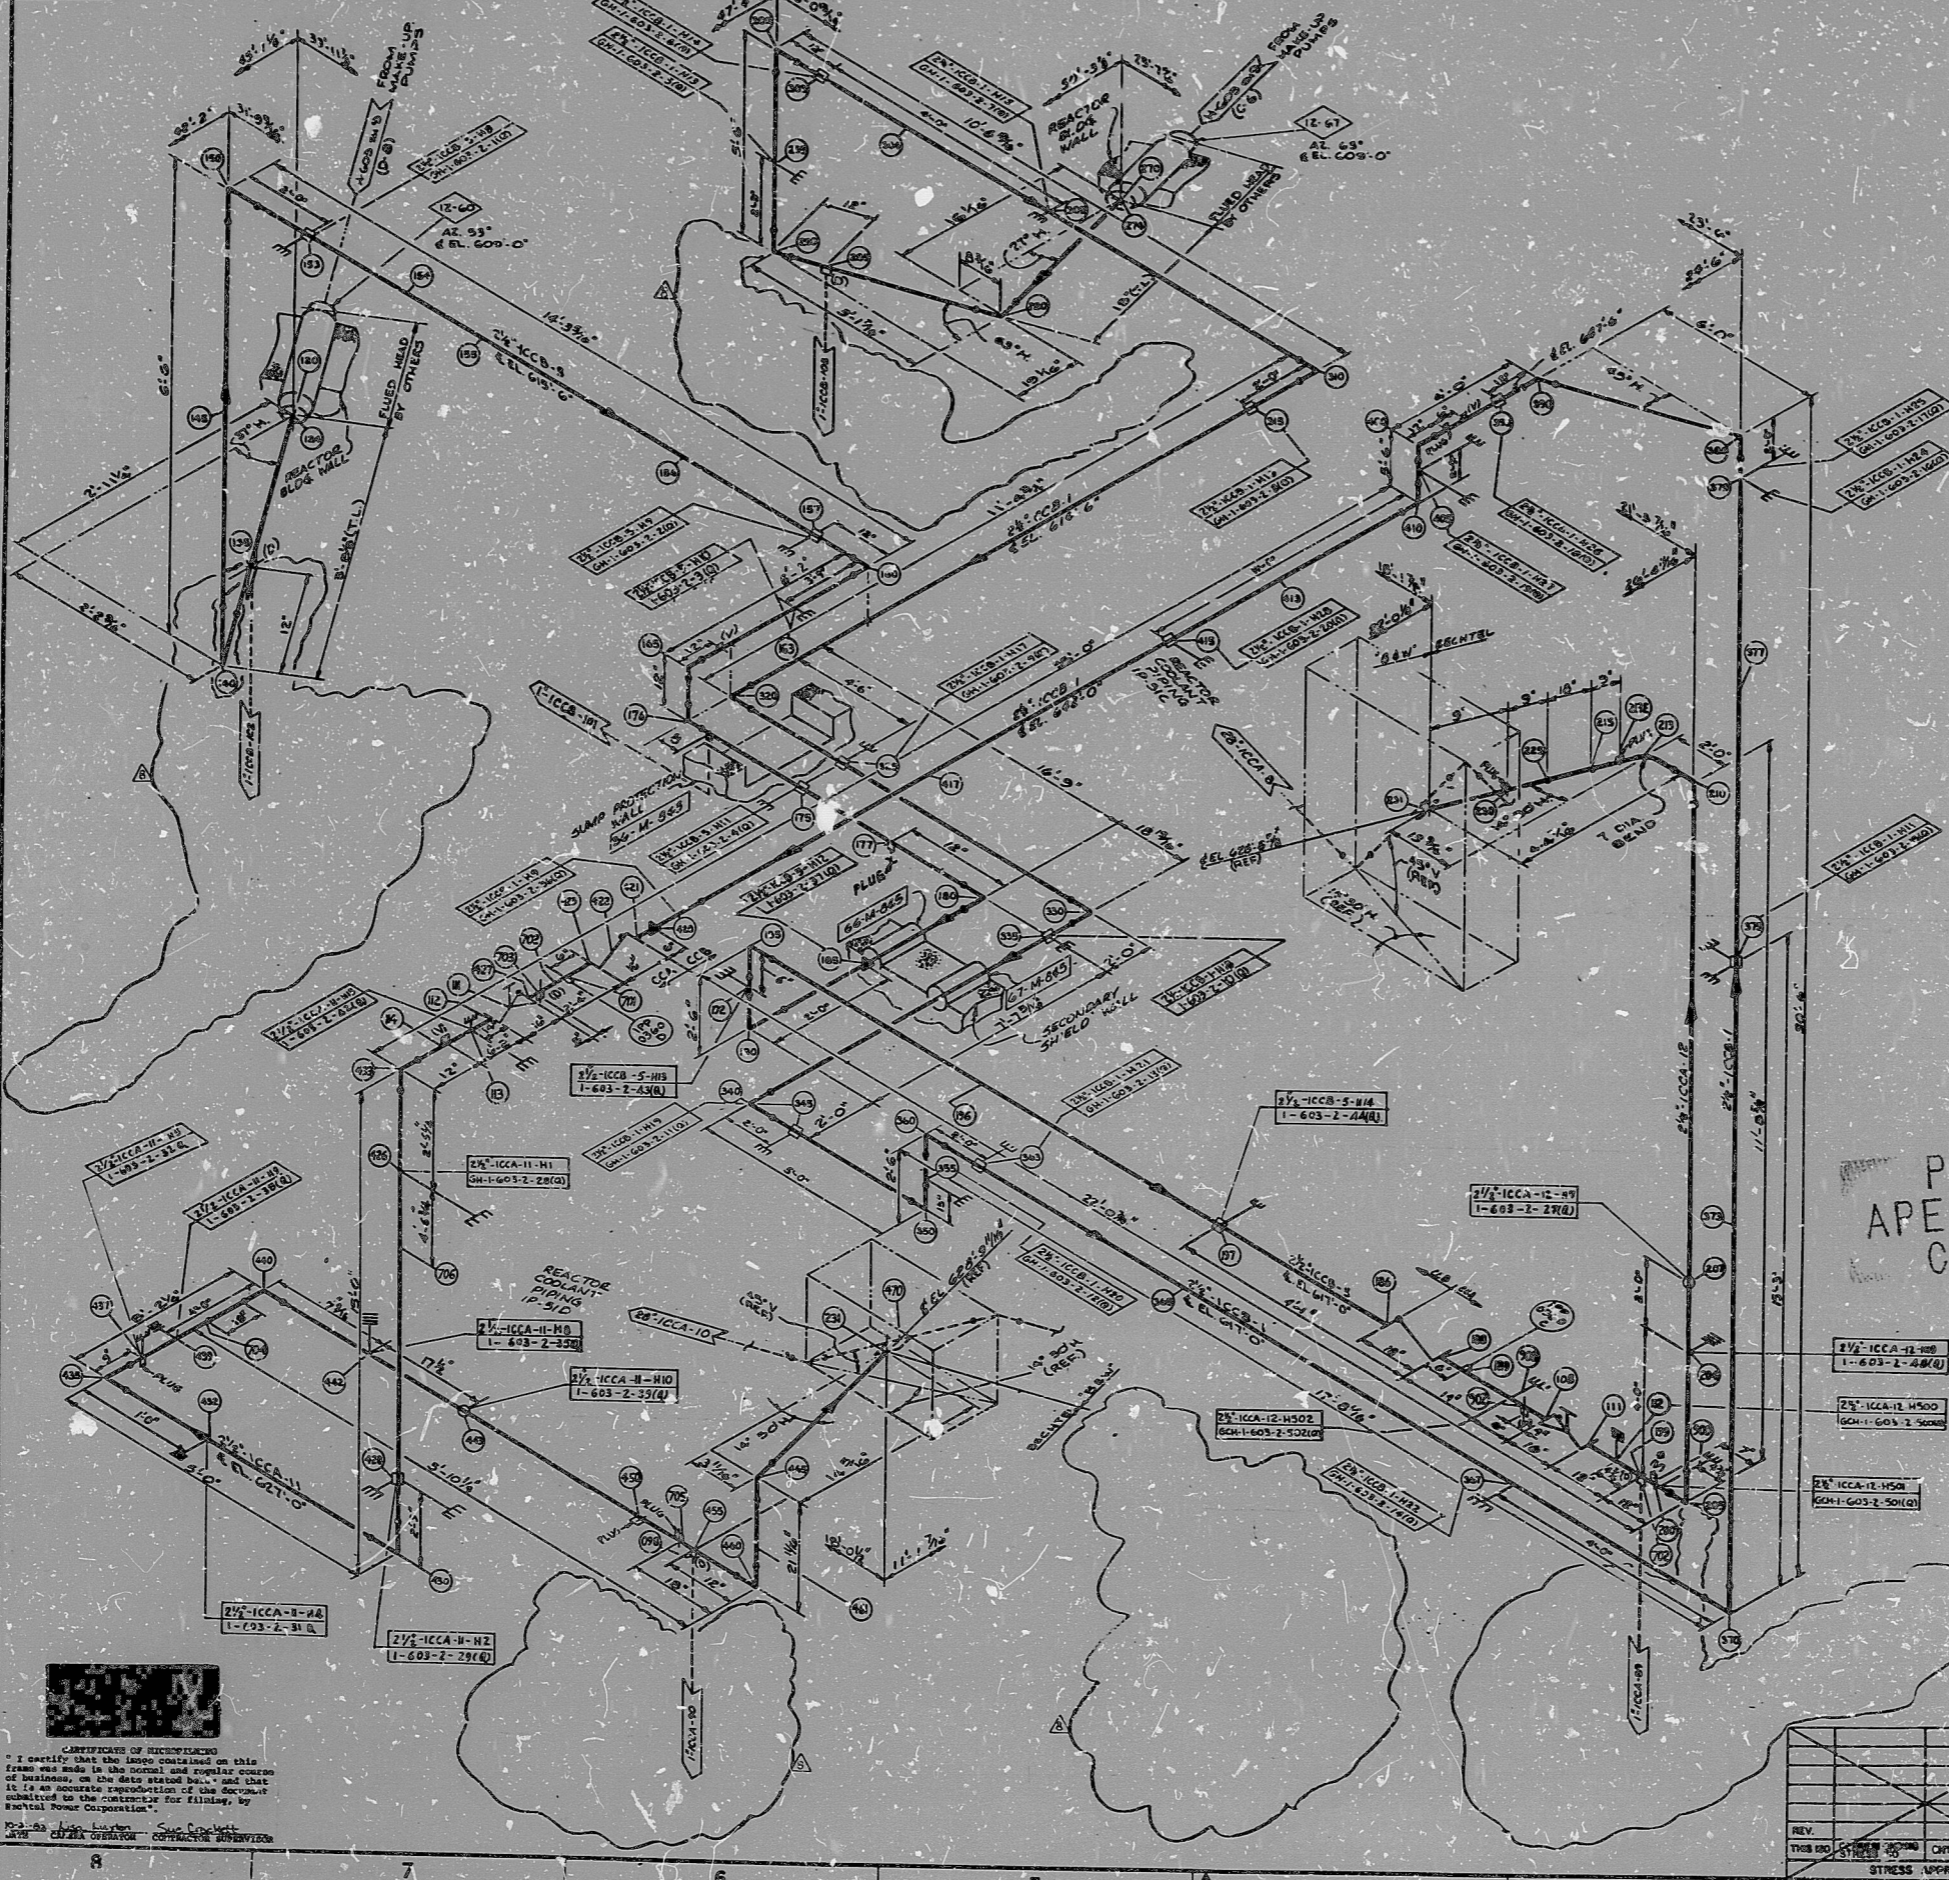

- NOTES:
1. ALL PIPING TO BE FABRICATED AND ERECTED IN ACCORDANCE WITH SPECIFICATIONS 7210-M-208.
 2. FOR MATERIAL SPECIFICATION OF PIPE, VALVES AND FITTINGS, SEE PIPING CLASS SPECIFICATIONS, DIVISION 5, PART 5.4.0.
 3. FOR PIPING AND FITTINGS DIMENSIONS, SEE DIVISION 5, PART 5.4.0.
 4. FOR EQUIPMENT LIST, SEE M-403.
 5. FOR INSTRUMENT CONNECTIONS, SEE DRAWING M-403.

REFERENCES DWGS:
 M-300 TYPES OF FLUED HEAD FITTINGS FOR CONTAINMENT PIPING PENETRATIONS.
 M-501 REACTOR BLDG. MECHANICAL PENETRATION SCHEDULE.

PRC APERTURE CARD

DESIGN CALCULATION REFERENCE:

REV	NO	DESCRIPTION
1	1	SC-3603-100
2	1	SC-3603-100
POOR ORIGINAL

REV	NO	DESCRIPTION	DATE
1	1	ISSUE FOR SUPPORT FAB	11/1/52
2	1	ISSUE FOR SUPPORT FAB	11/1/52


HANGER SYSTEM
 MAKE UP AND PURIFICATION
 SYSTEM UNIT-1
 (REACTOR BLDG. W.P. HANGERS)

REV	NO	DESCRIPTION	DATE
1	1	ISSUE FOR SUPPORT FAB	11/1/52
2	1	ISSUE FOR SUPPORT FAB	11/1/52
CERTIFICATE OF REPRODUCTION

17"
 11"
 8.5"
 11"
 8.5"
 17"

17"
 11"
 8.5"
 11"
 8.5"
 17"

RIDS

8302140205

