
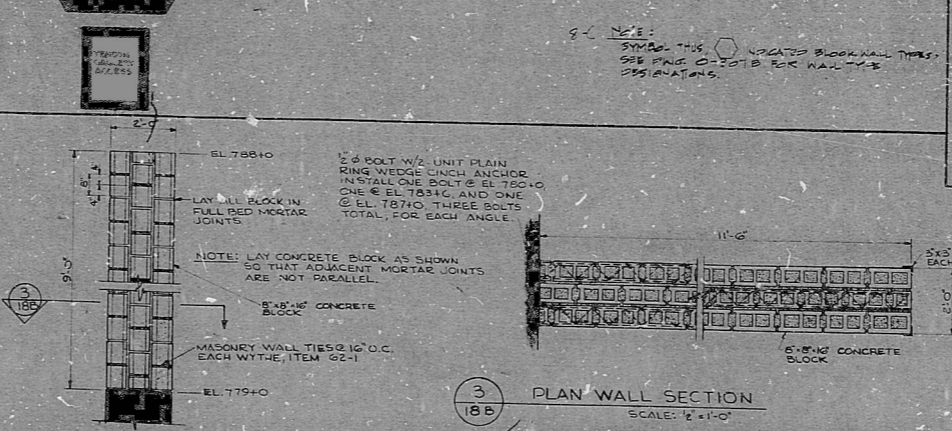
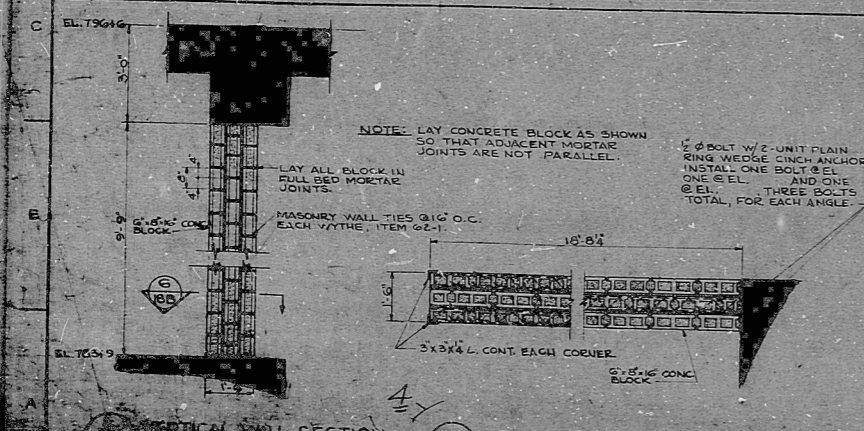


LEGEND
MECHANICAL SYSTEM
ELECTRICAL SYSTEM
LOAD BEARING AREA

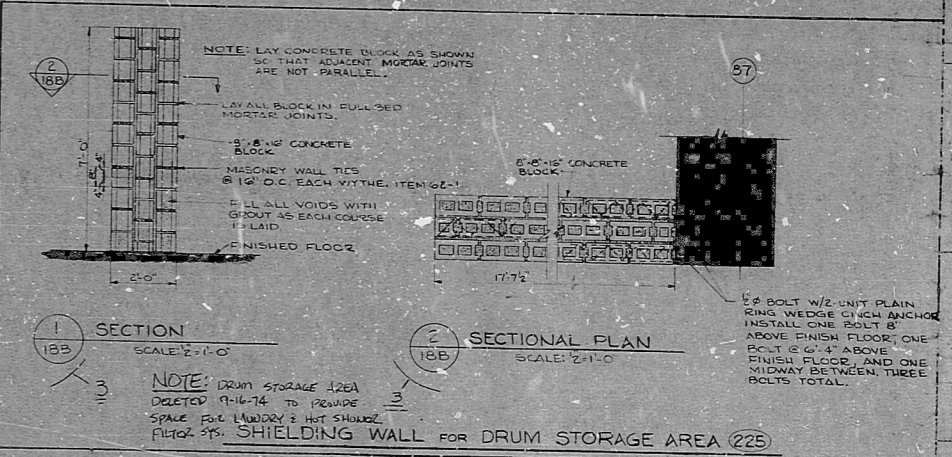

34"
22"
17"
11"
8.5"
11"
17"
22"
34"

34"
22"
17"
11"
8.5"
11"
17"
22"
34"

REFERENCE DWGS
SEE DWG. O-18A

NOTES
1. WOP THIS DWG. WITH DWG. O-18A
2. FOR LAYOUT SCHEDULE SEE DWG. O-18A

DUKE POWER COMPANY
OCONEE NUCLEAR STATION UNITS 1-3
GENERAL ARRANGEMENT
AUXILIARY BUILDING
PLAN AT EL. 783.9
SAFE LOAD PATHS

NO.	REVISIONS	CHG. APPR.	DATE	CIVIL ENG. INCH.	DATE

DRW. REL. TO STEAM FOR INFORMATION
DESIGNED BY: [] DATE: []
CHECKED BY: [] DATE: []
SCALE: 1/2"=1'-0"
DWG. NO. O-18B-SLP

RDS

8109220555

