

17"

11"

8.5"

8.5"

11"

17"

17"


11"

8.5"

8.5"

11"

17"

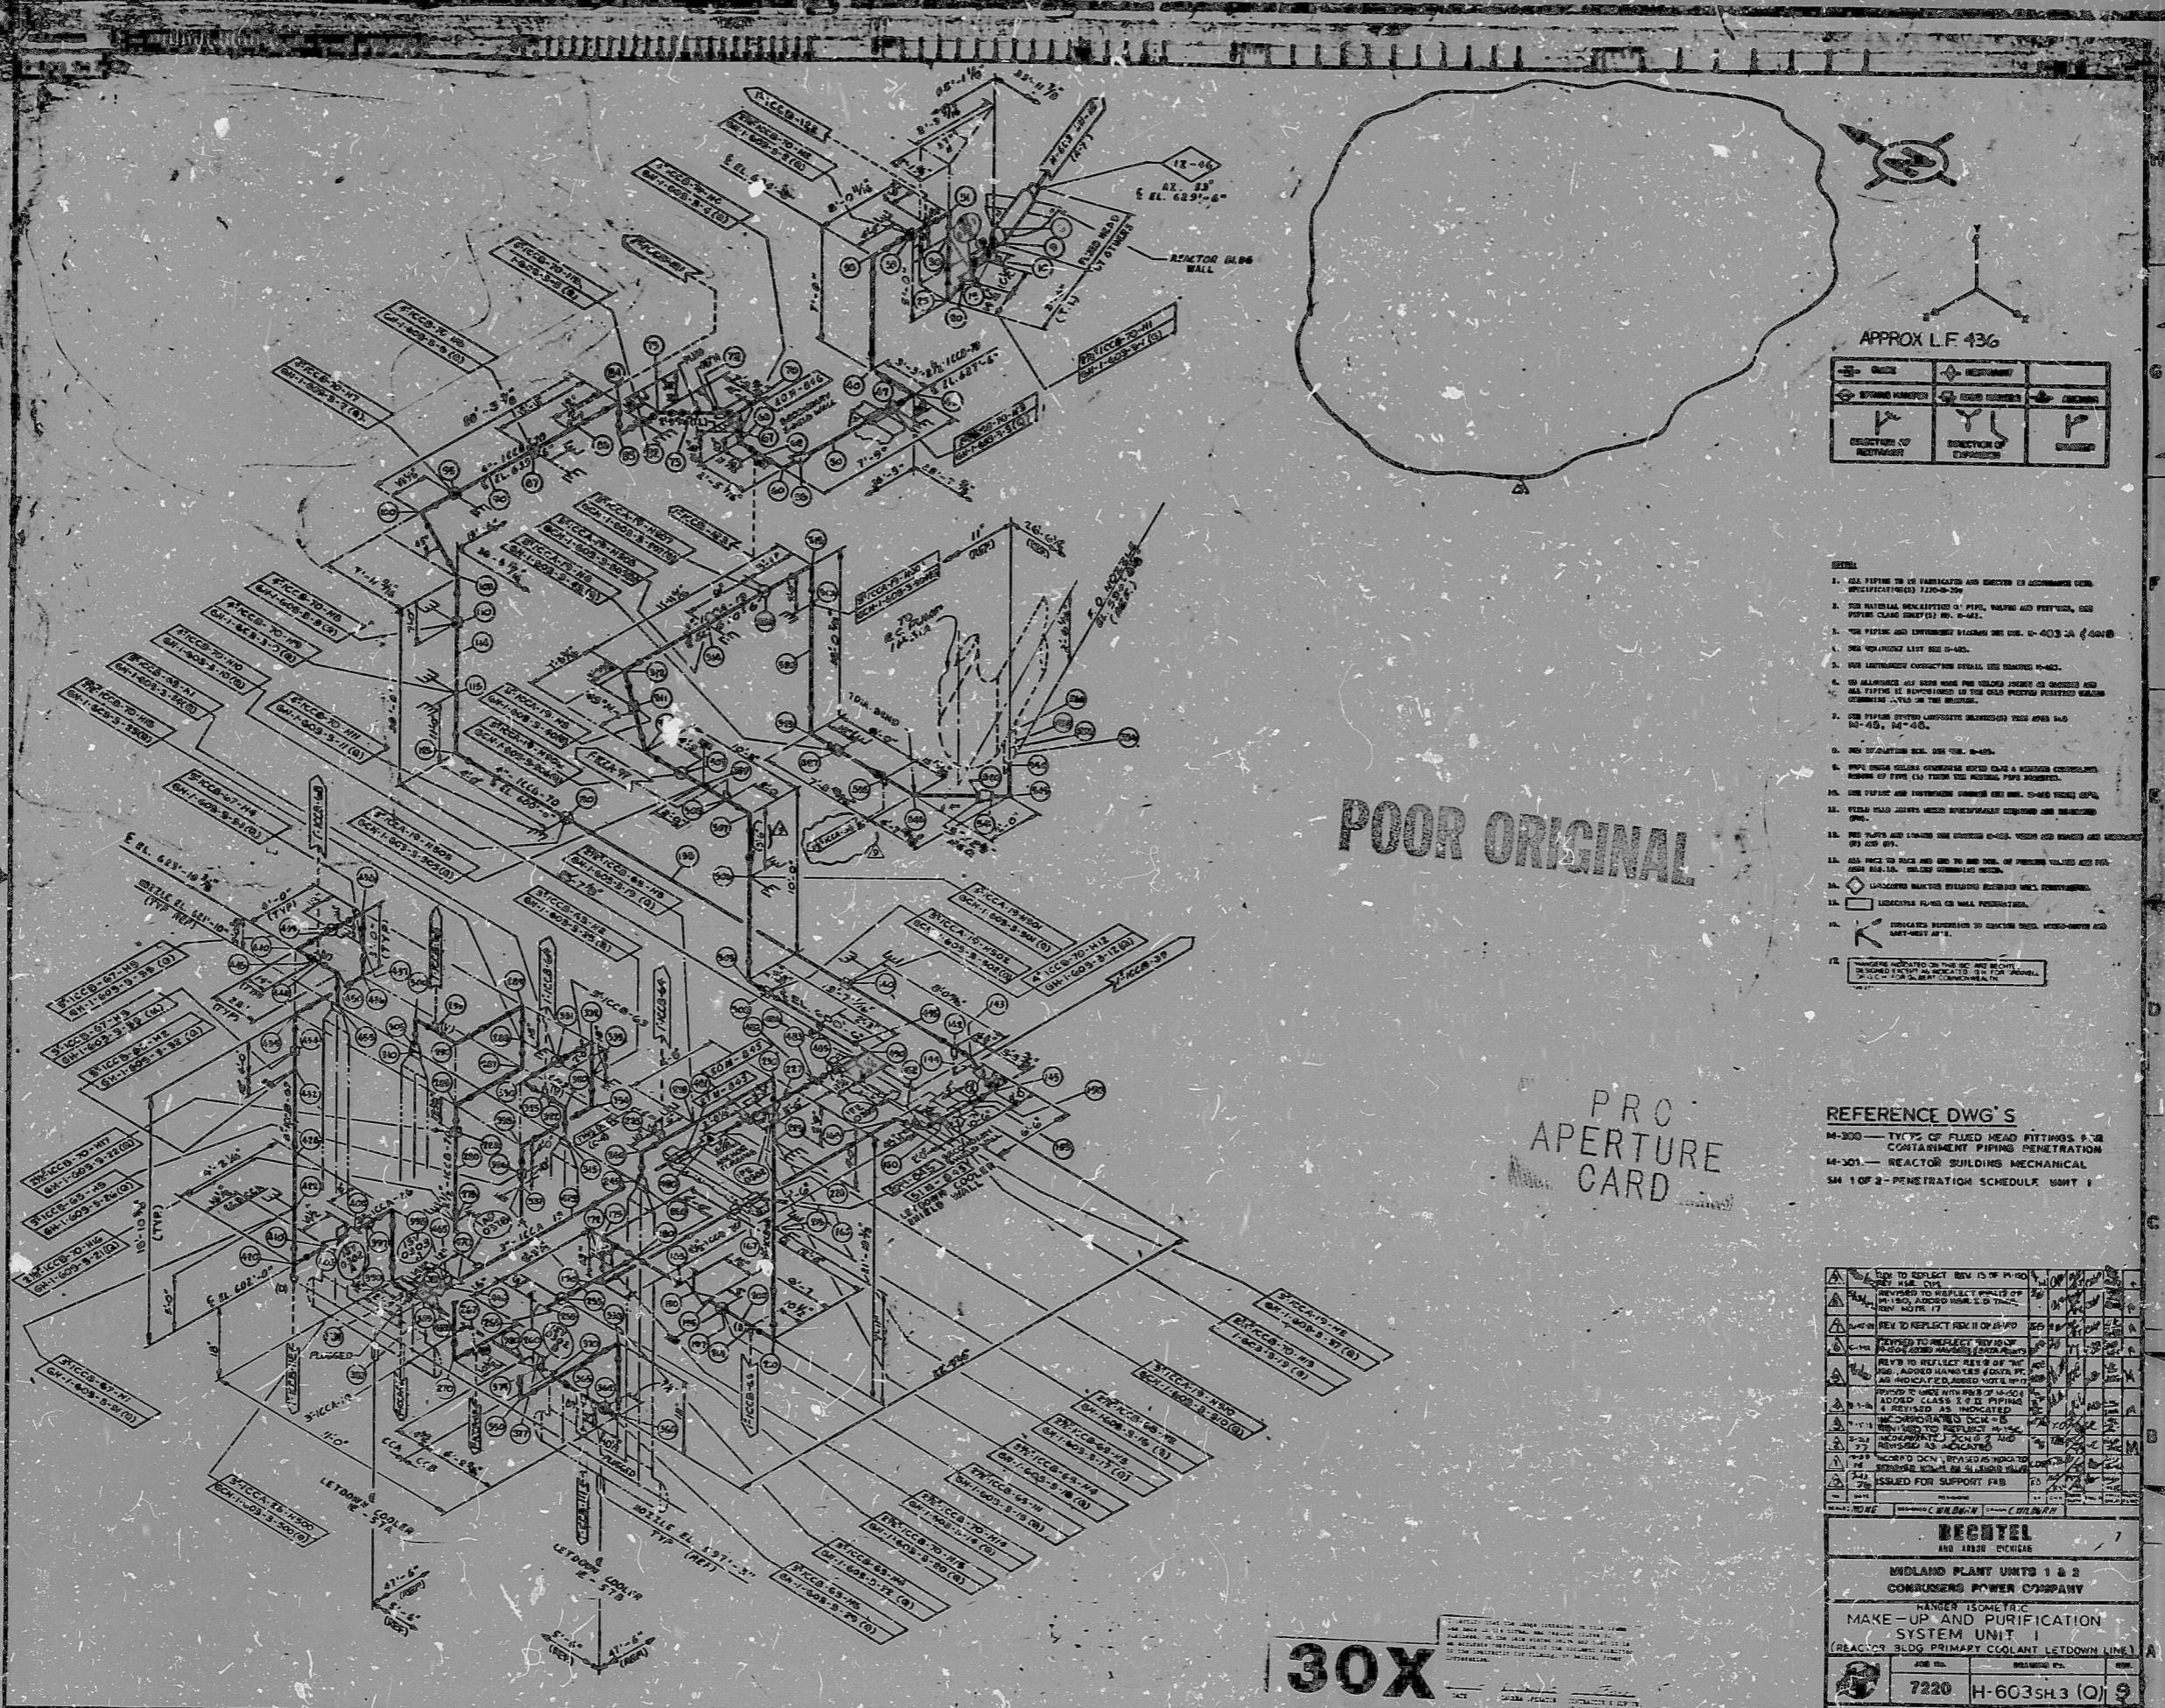

POOR ORIGINAL

PRO APERTURE CARD

30X



APPROX L.F. 436

DIRECTION OF FLOW	DIRECTION OF PENETRATION	DIRECTION OF EXPANSION

NOTES:

1. ALL PIPING TO BE FABRICATED AND ERRECTED IN ACCORDANCE WITH SPECIFICATIONS 2200-00-00.
2. THE MATERIAL SPECIFIED IS PIPE, VALVES AND FITTINGS, SEE PIPING CLASS SHEET (S) NO. 6-411.
REFERENCE DWG'S

- M-300 - TYPES OF FLUID HEAD FITTINGS & 3/8 CONTAINMENT PIPING PENETRATION
- M-301 - REACTOR BUILDING MECHANICAL
- SM 10P 2 - PENETRATION SCHEDULE UNIT I

BECHTEL
AND ASSOCIATES

MIDLAND PLANT UNITS 1 & 2

MAKE-UP AND PURIFICATION
SYSTEM UNIT I
(REACTOR BLDG PRIMARY COOLANT LETDOWN LINE)

7220 H-603SH.3 (0) 9

RIDS

8302140207

