


34"
22"
17"
11"
8.5"
11"
17"
22"
34"

34"
22"
17"
11"
8.5"
11"
17"
22"
34"

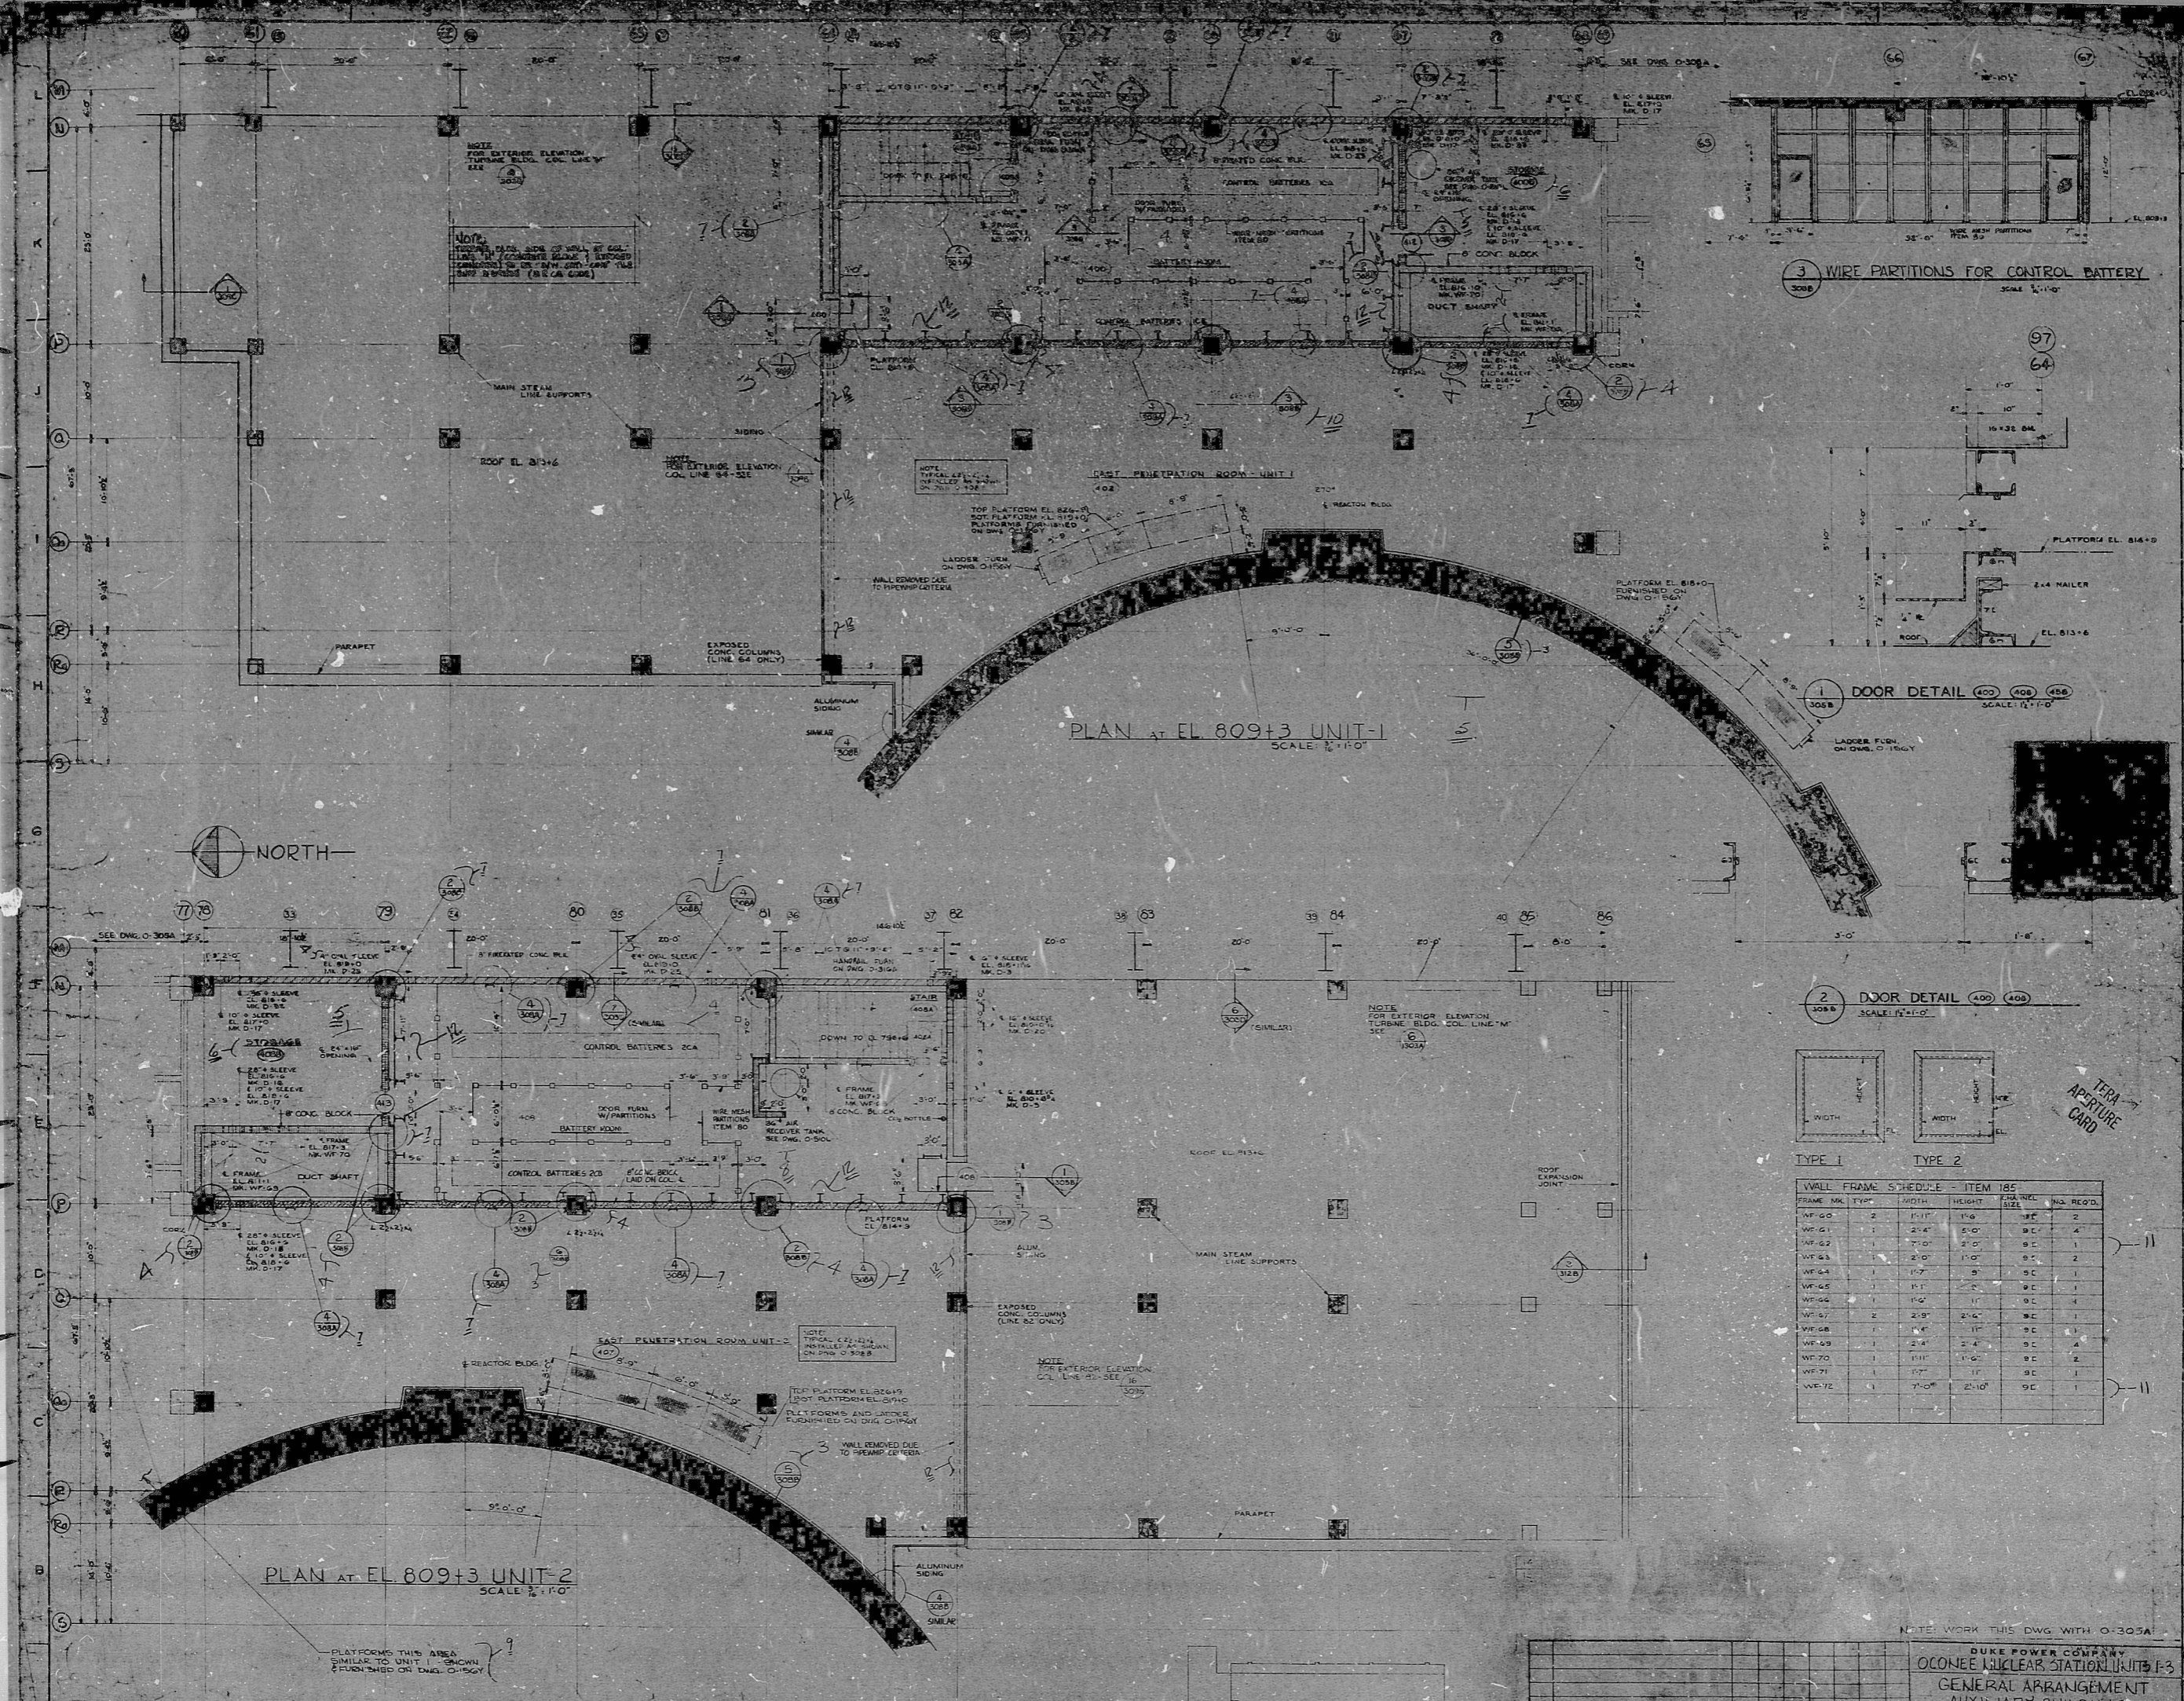

NOTE FOR EXTERIOR ELEVATION
TURNING BLDG. COL. LINE "M"
SEE 0-303A

NOTE
TYPICAL 2" x 4" x 1/2" STUDS
ON 16" o.c.

PLAN AT EL 809+3 UNIT-1
SCALE: 1/4" = 1'-0"

3 WIRE PARTITIONS FOR CONTROL BATTERY
SCALE: 1/4" = 1'-0"

1 DOOR DETAIL (400) (408) (406)
SCALE: 1/4" = 1'-0"


2 DOOR DETAIL (400) (408)
SCALE: 1/4" = 1'-0"

TYPE 1 TYPE 2

WALL FRAME SCHEDULE - ITEM 185					
FRAME NO.	TYP.	WIDTH	HEIGHT	COL. LINE SIZE	NO. REQ'D.
WF-00	2	10'-0"	1'-0"	9C	2
WF-01	1	2'-4"	2'-0"	9C	4
WF-02	1	7'-0"	2'-0"	9C	1
WF-03	1	2'-0"	1'-0"	9C	2
WF-04	1	1'-0"	5'	9C	1
WF-05	1	1'-0"	2'	9C	1
WF-06	1	1'-0"	11'	9C	1
WF-07	2	2'-8"	2'-4"	9C	1
WF-08	1	1'-0"	11'	9C	1
WF-09	1	2'-4"	2'-4"	9C	4
WF-10	1	11'	1'-0"	9C	2
WF-11	1	7'-0"	11'	9C	1
WF-12	1	7'-0"	2'-10"	9C	1

PLAN AT EL 809+3 UNIT-2
SCALE: 1/4" = 1'-0"

PLATFORMS THIS AREA
SIMILAR TO UNIT 1 - SHOW
FURNISHED ON DWG. 0-1507

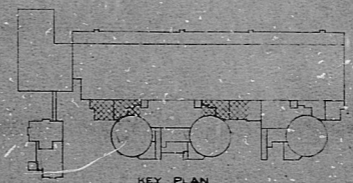

NOTE: WORK THIS DWG WITH 0-305A

NO.	REVISIONS	CHG'D BY	DATE

DUKE POWER COMPANY
OCONEE NUCLEAR STATION UNITS 1-3
GENERAL ARRANGEMENT
AUXILIARY BUILDING
PLAN AT EL 809+3
SAFE LOAD PATHS

RIAS

8109220584

