


17"
11"
8.5"
8.5"
11"
17"

17"
11"
8.5"
8.5"
11"
17"

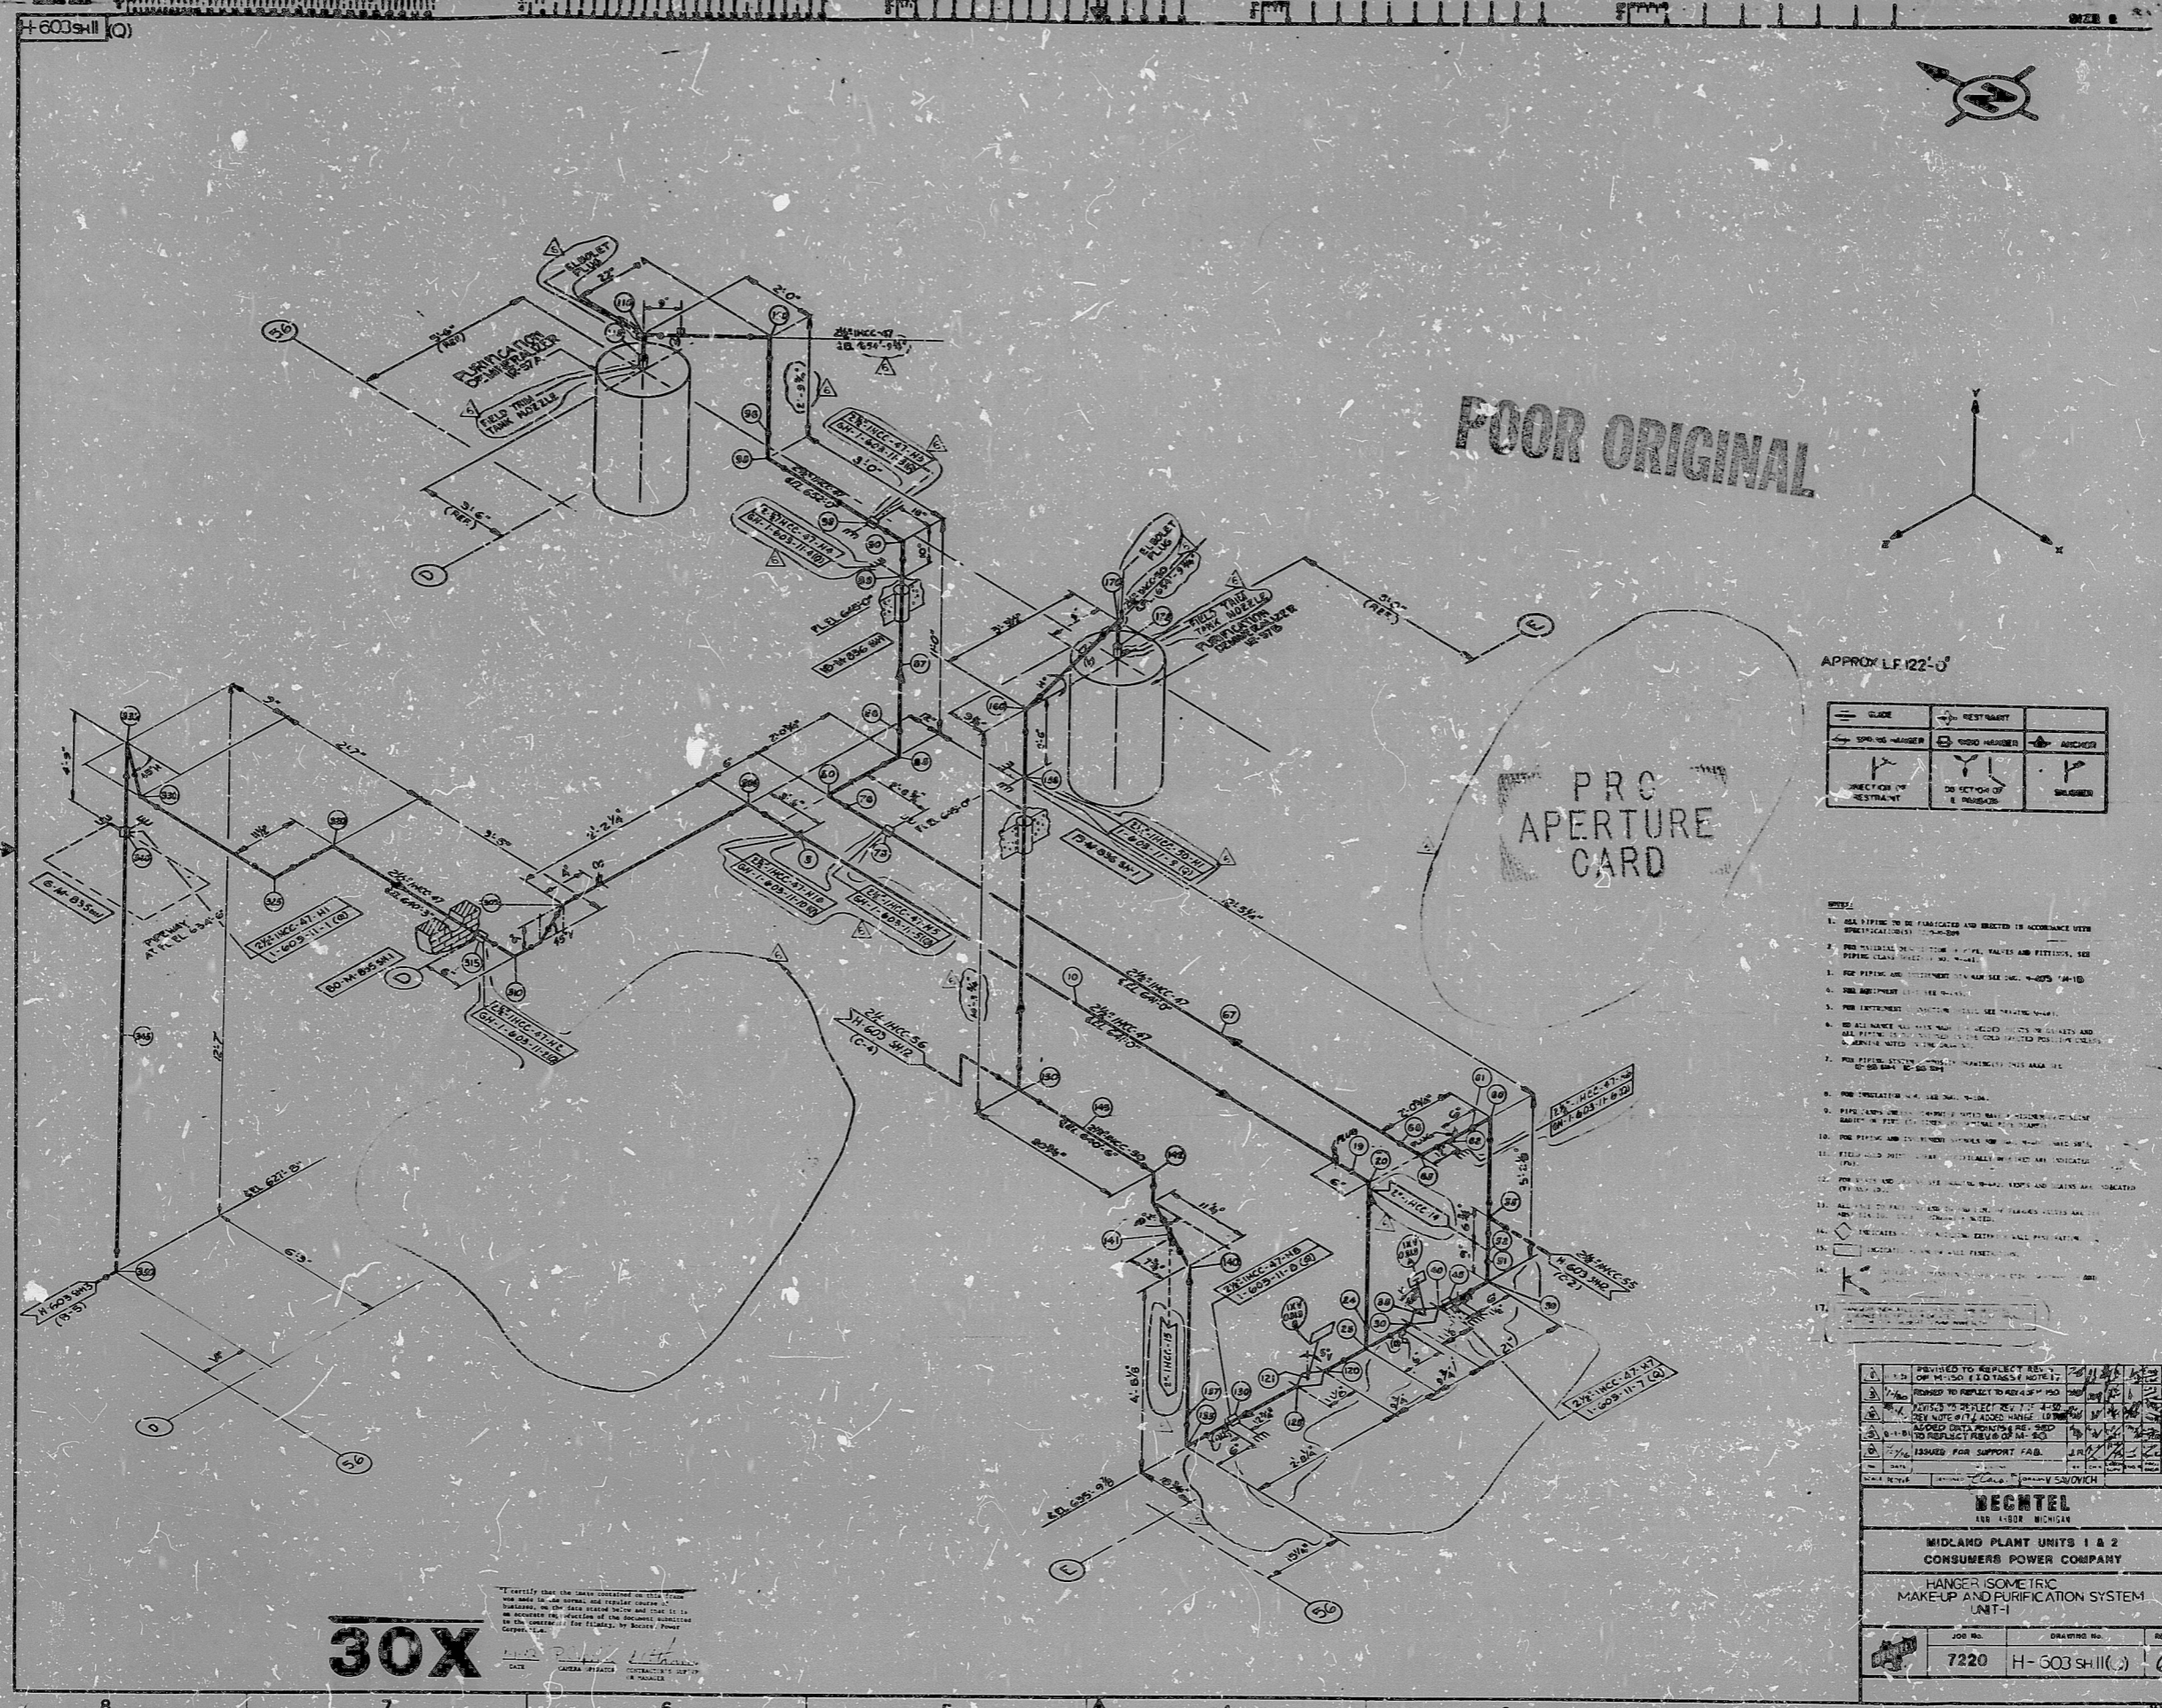

FOOR ORIGINAL

APPROX LF 122'-0"


- NOTES:
1. SEE LISTING TO BE MANUFACTURED AND INSTALLED IN ACCORDANCE WITH SPECIFICATIONS 104-109.
 2. FOR MATERIAL SPECIFICATIONS, VALUES AND FITTINGS, SEE PIPING STANDARDS 104-109.
 3. FOR PIPING AND FITTINGS, SEE PIPING STANDARDS 104-109.
 4. FOR MATERIALS, SEE LISTING.
 5. FOR DIMENSIONS, SEE LISTING.
 6. FOR ALL WELDS, SEE LISTING.

30X



ISSUED FOR SUPPORT FAB. J.M.

DATE: _____

BY: _____

BECHTEL
 MIDLAND PLANT UNITS 1 & 2
 CONSUMERS POWER COMPANY
 HANGER ISOMETRIC
 MAKE-UP AND PURIFICATION SYSTEM
 (INT.)


RIDS

8302140217

