


11  
8.5  
8.5  
11  
17

11  
8.5  
8.5  
11  
17

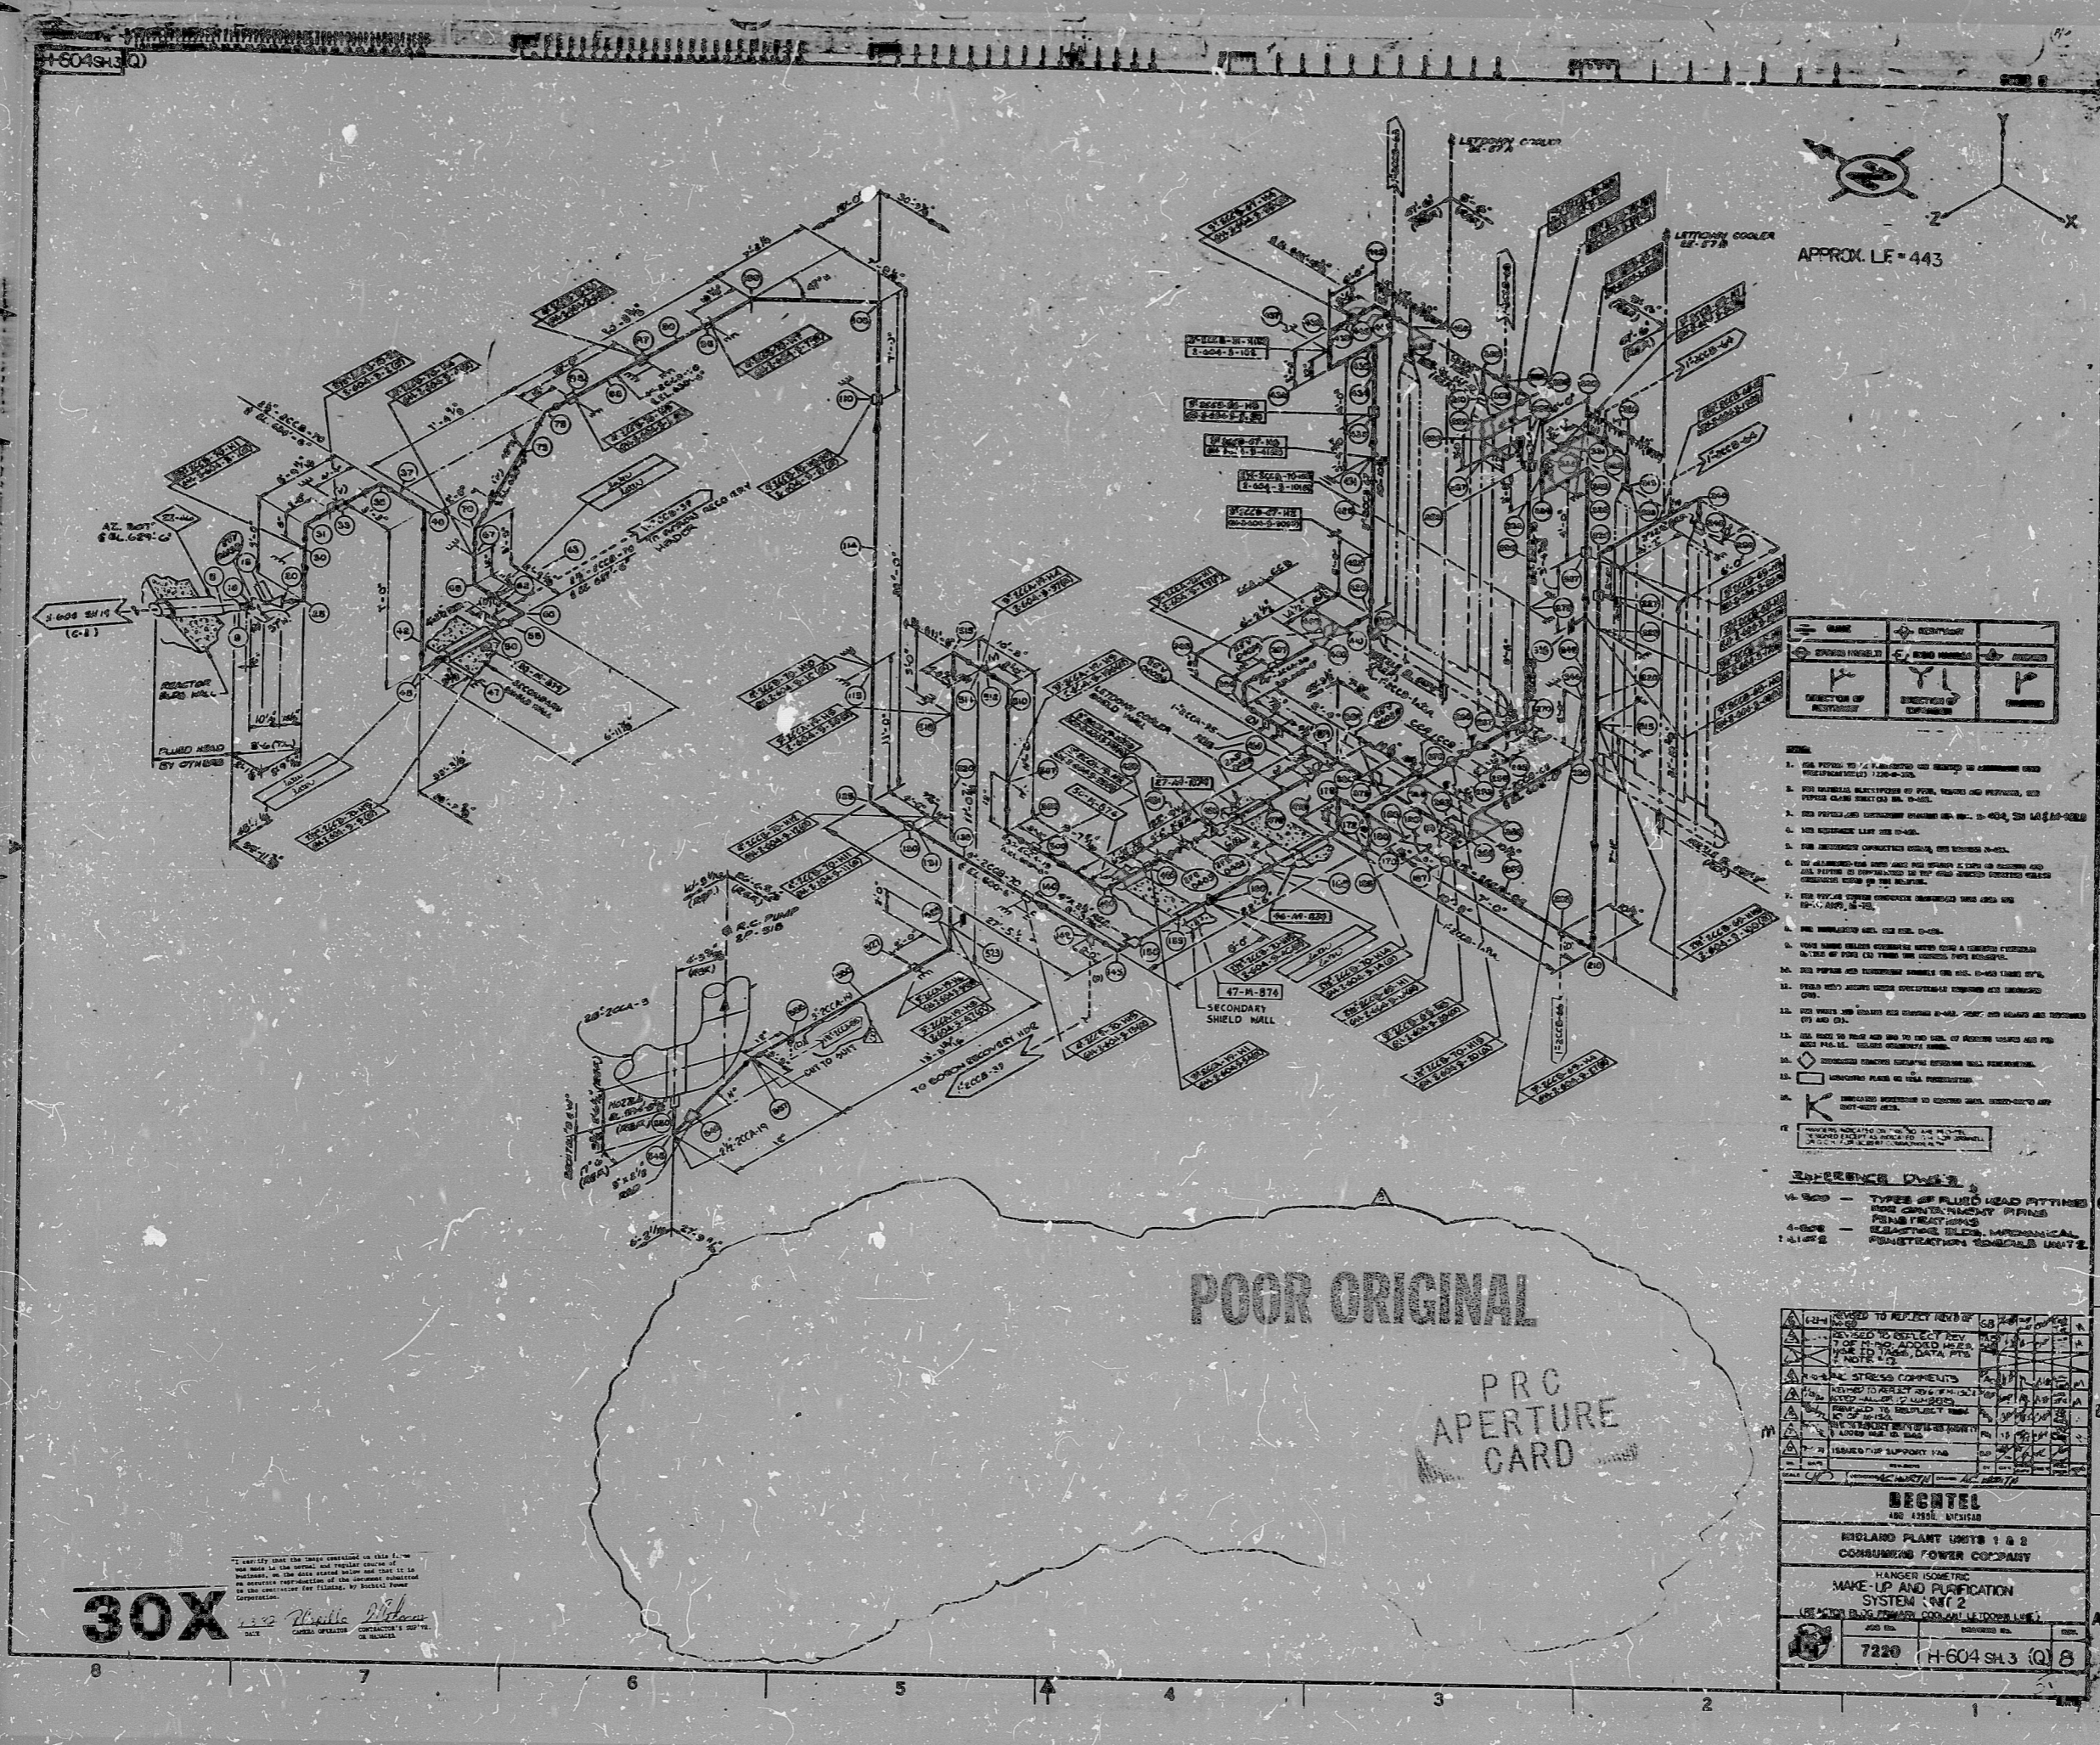

SYMBOL	DESCRIPTION
(Symbol)	DIRECTION OF EXPANSION

- 1. SEE PIPING TO BE FABRICATED AND INSTALLED IN ACCORDANCE WITH SPECIFICATIONS 1200-0-100.
- 2. FOR MATERIAL SPECIFICATIONS OF PIPES, FITTINGS AND FLANGES, SEE PIPING SPECIFICATION 1200-0-100.
POOR ORIGINAL  
PRC  
APERTURE  
CARD

**30X**  

**REVISIONS**

NO.	DESCRIPTION	DATE	BY

**BECHTEL**  

MAKE-UP AND PURIFICATION  
SYSTEM (NO. 2)  

7220 H-604 SH3 (Q) B

RIDS

830215008

