


17"  
11"  
8.5"  
8.5"  
11"  
17"

17"  
11"  
8.5"  
8.5"  
11"  
17"

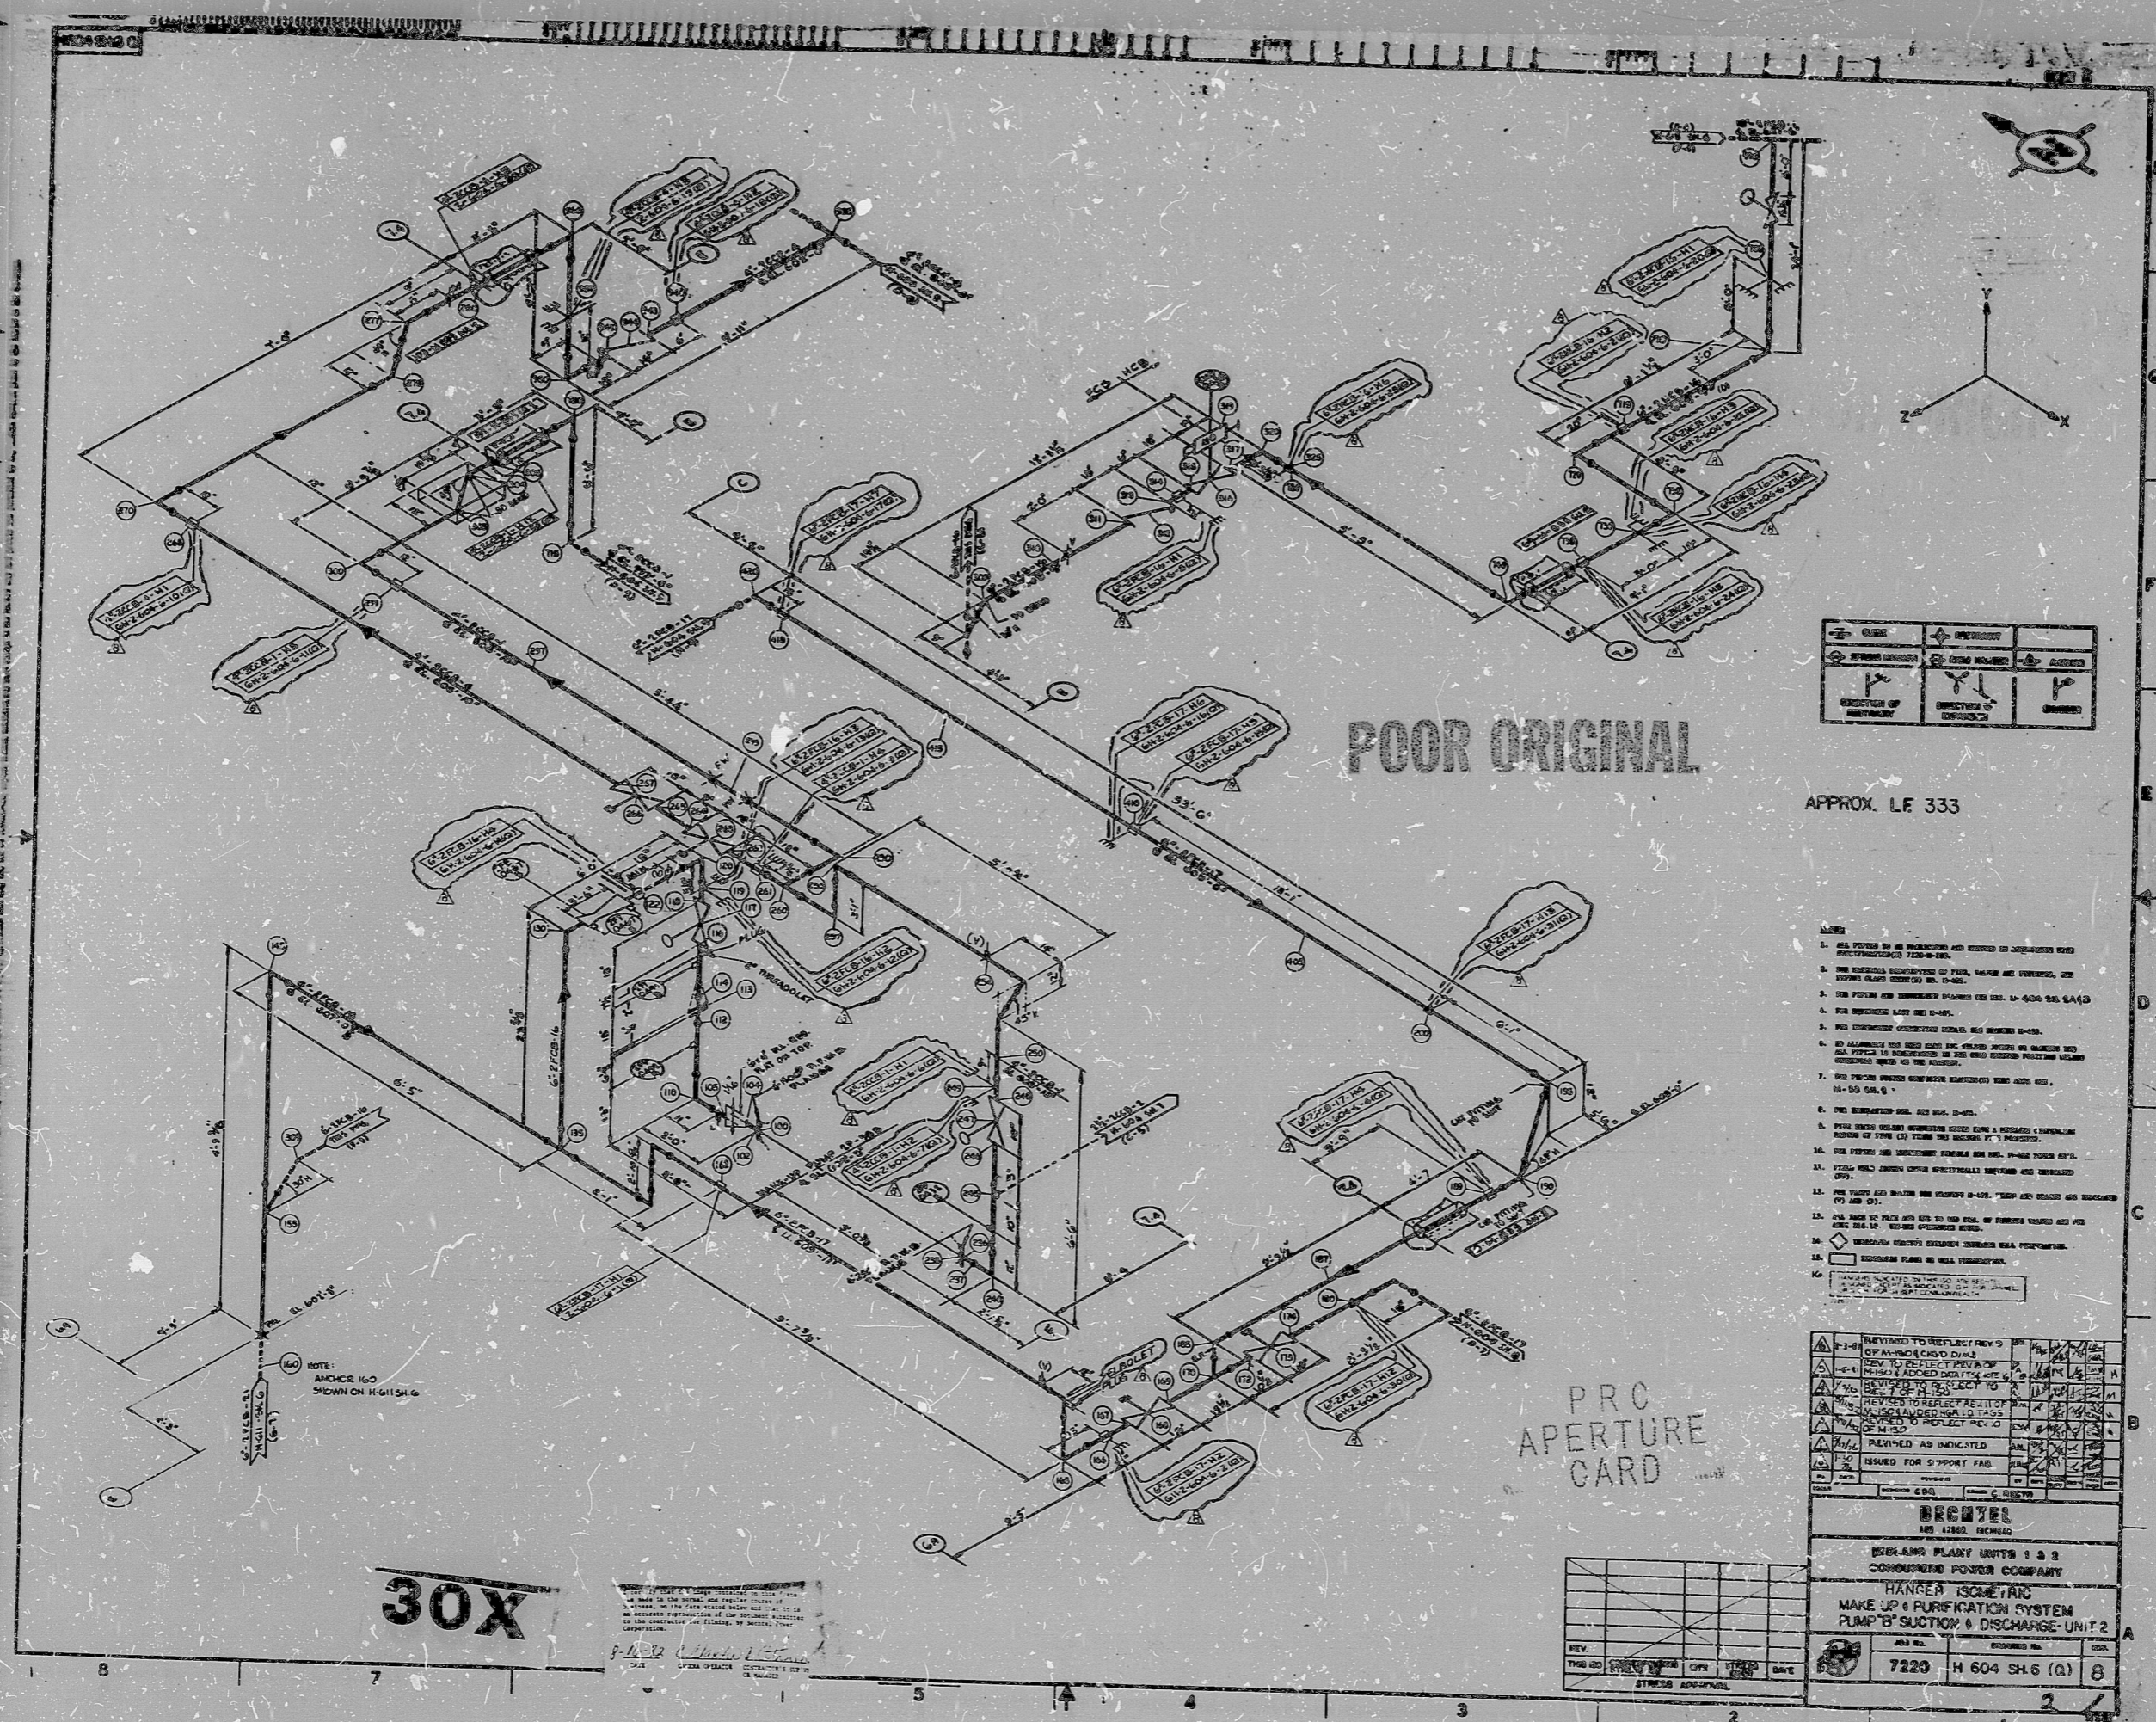

POOR ORIGINAL


APPROX. LF 333

7220 H 604 SH.6 (Q) 8



RIDS

8307150088

