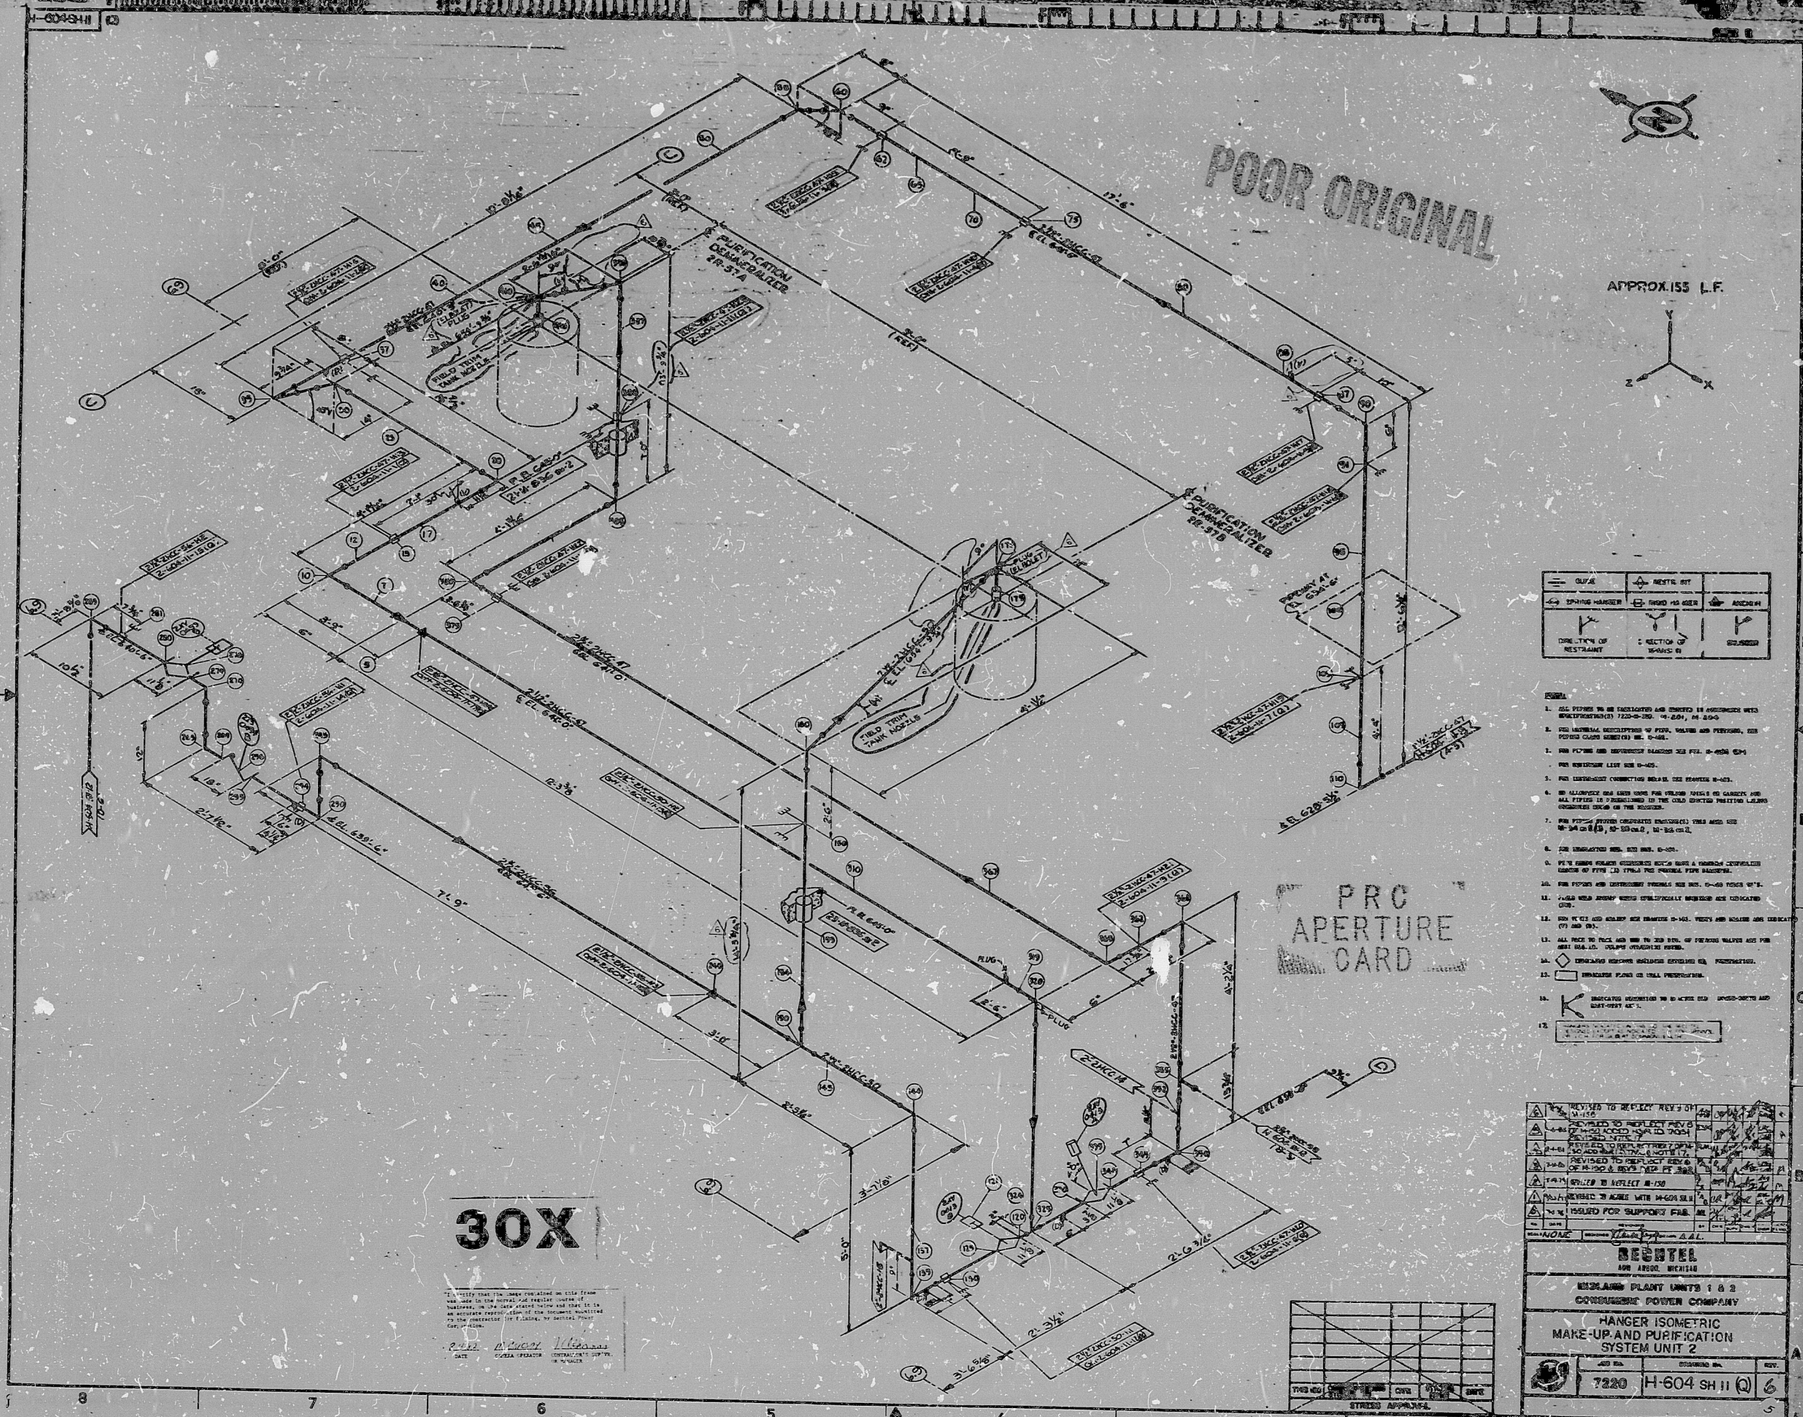
POOR ORIGINAL
PRC APERTURE CARD
30X
APPROX. 155 L.F.
PURIFICATION DEMINERALIZER 2B-37A
PURIFICATION DEMINERALIZER 2B-37B

RIDS

8302150097

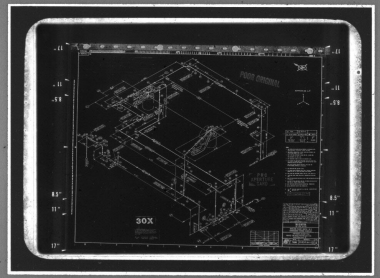

MMM 5824 — FILMSORT® Brand Aperture & Camera Cards and DUPLICARD® Brand Copy Cards — Product of 3M Company, St. Paul, Minn.