

11  
8.5"


11  
8.5"

8.5"

11"

17"


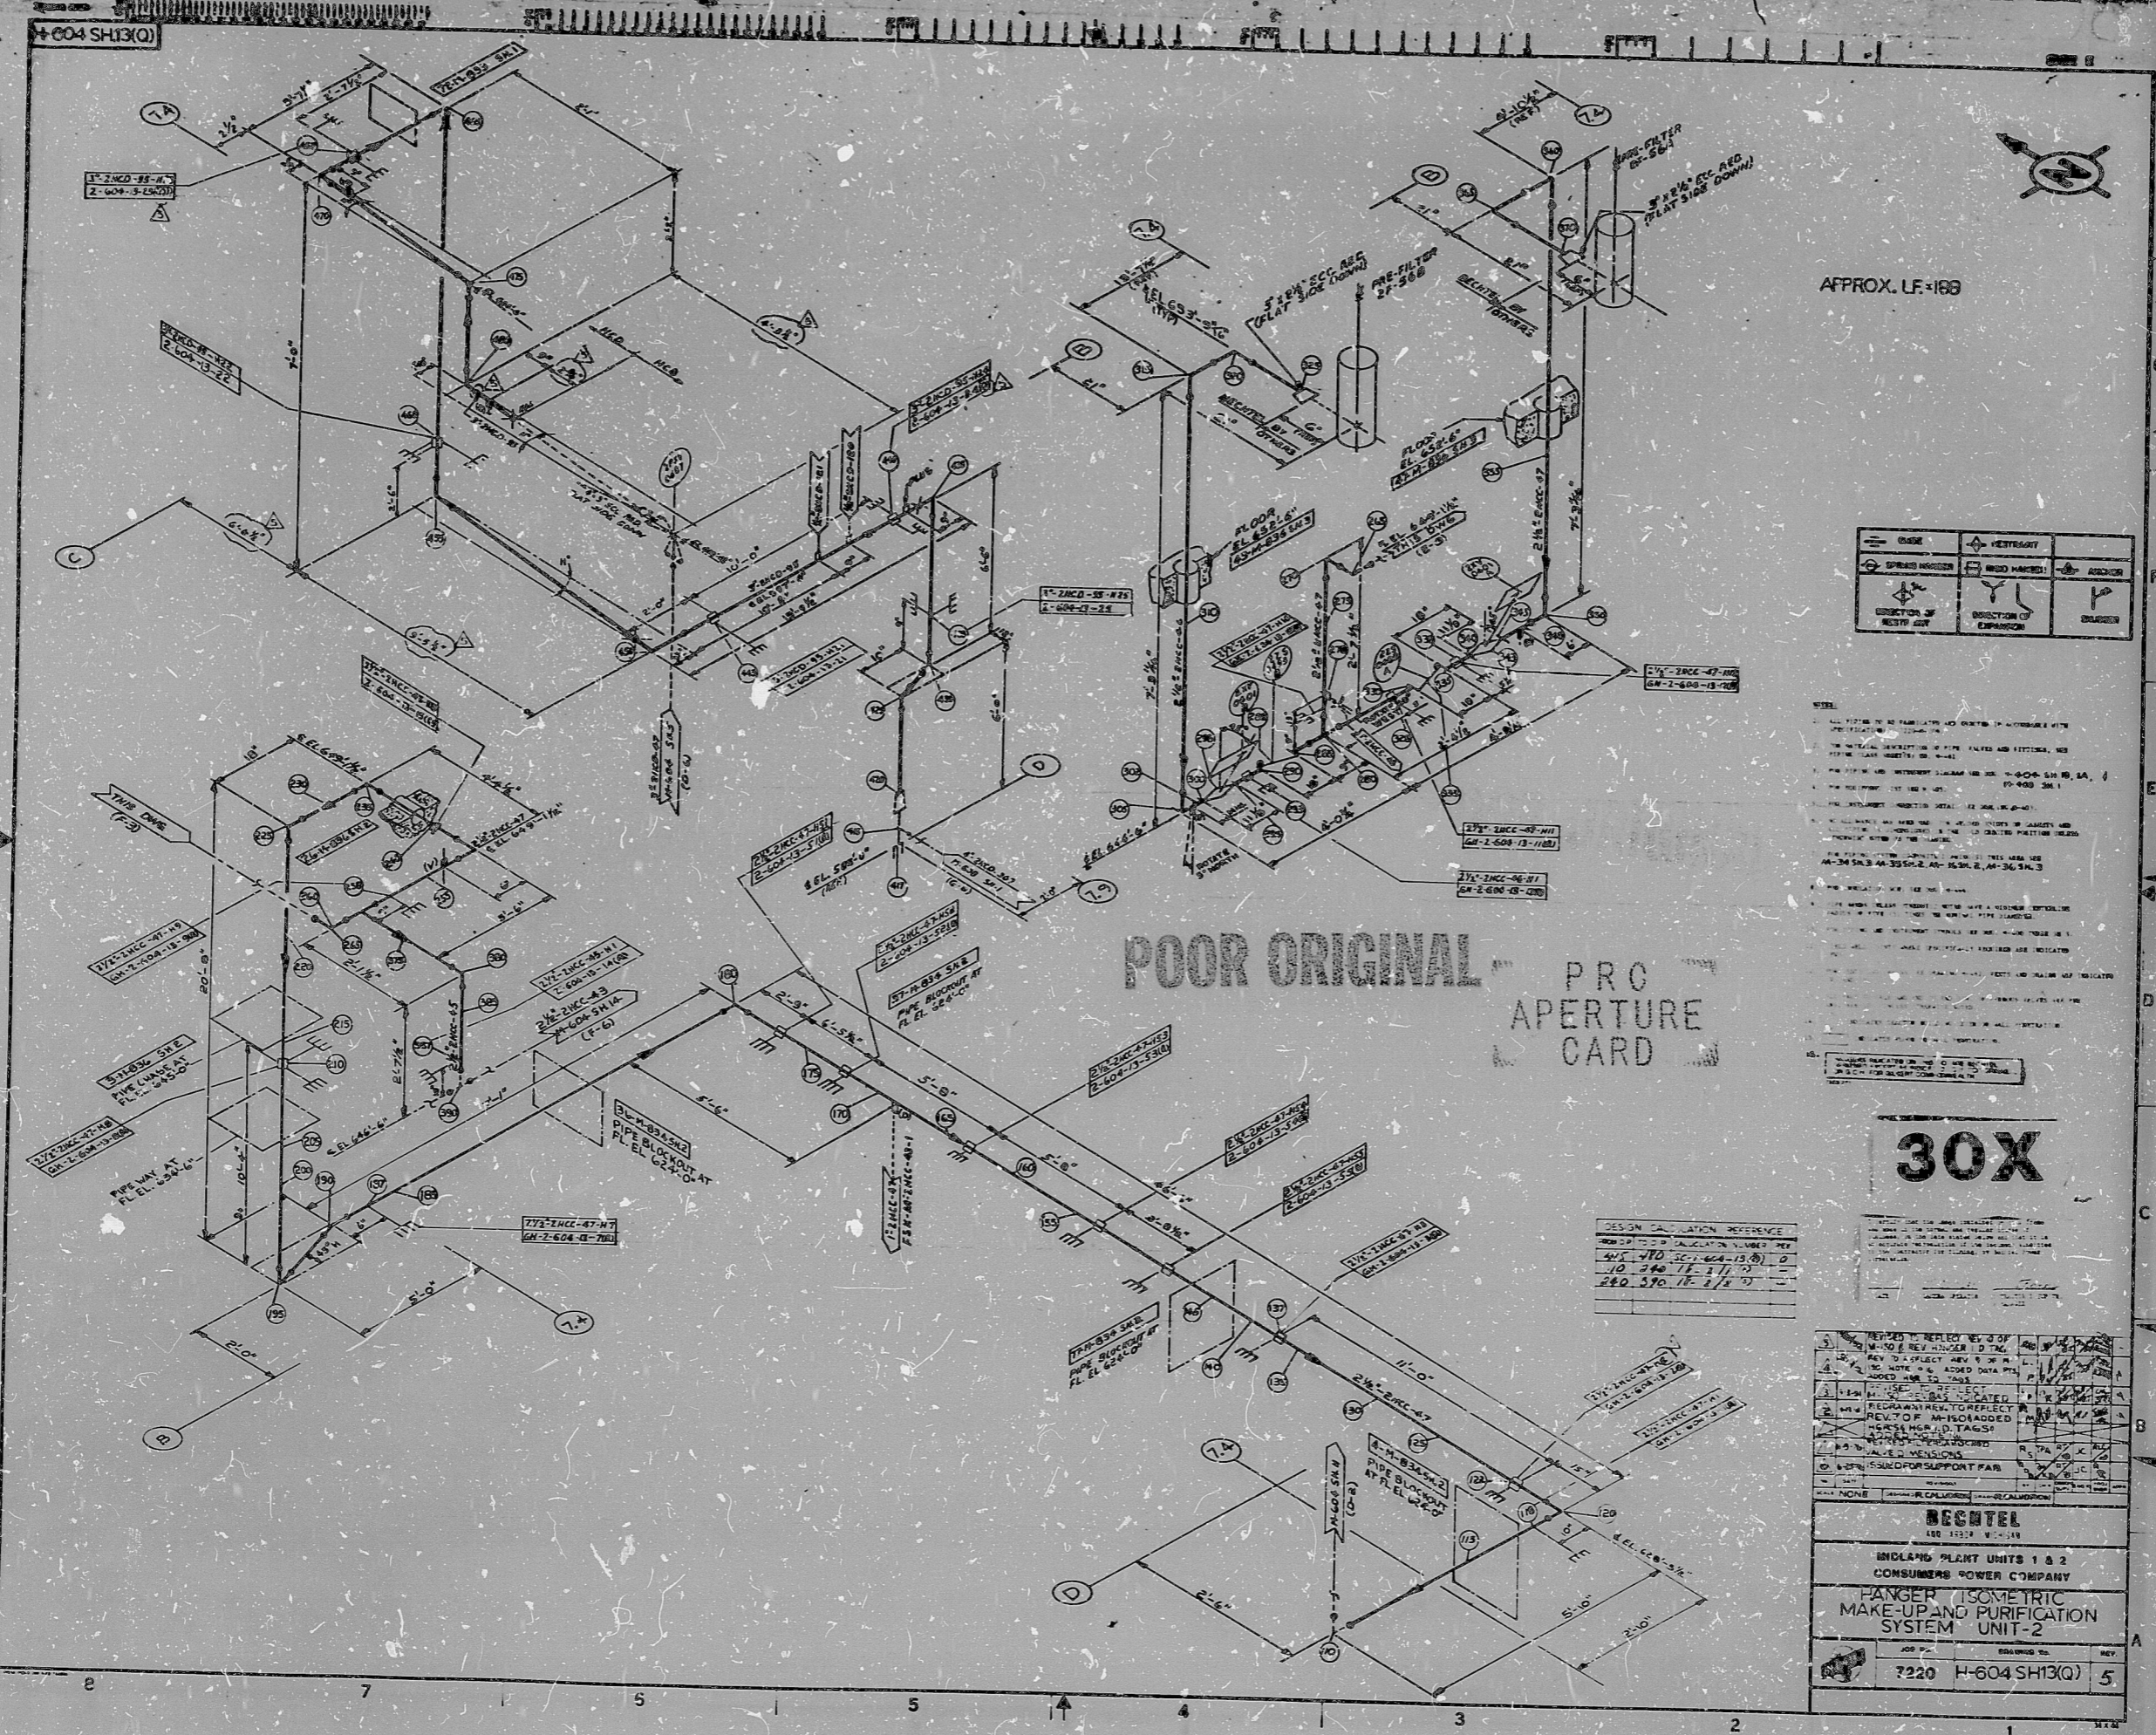

APPROX. LF:168


NOTE:  


POOR ORIGINAL PRO APERTURE CARD

30X




CONSUMERS POWER COMPANY	
PANGER ISOMETRIC MAKE-UP AND PURIFICATION SYSTEM UNIT-2	
JOB NO.	REV.
7220 H-604 SH13(Q)	5

11  
8.5"

11  
8.5"

8.5"

11"

17"

RIDS

8302150111

