


17  
11  
8.5  
8.5  
11  
17

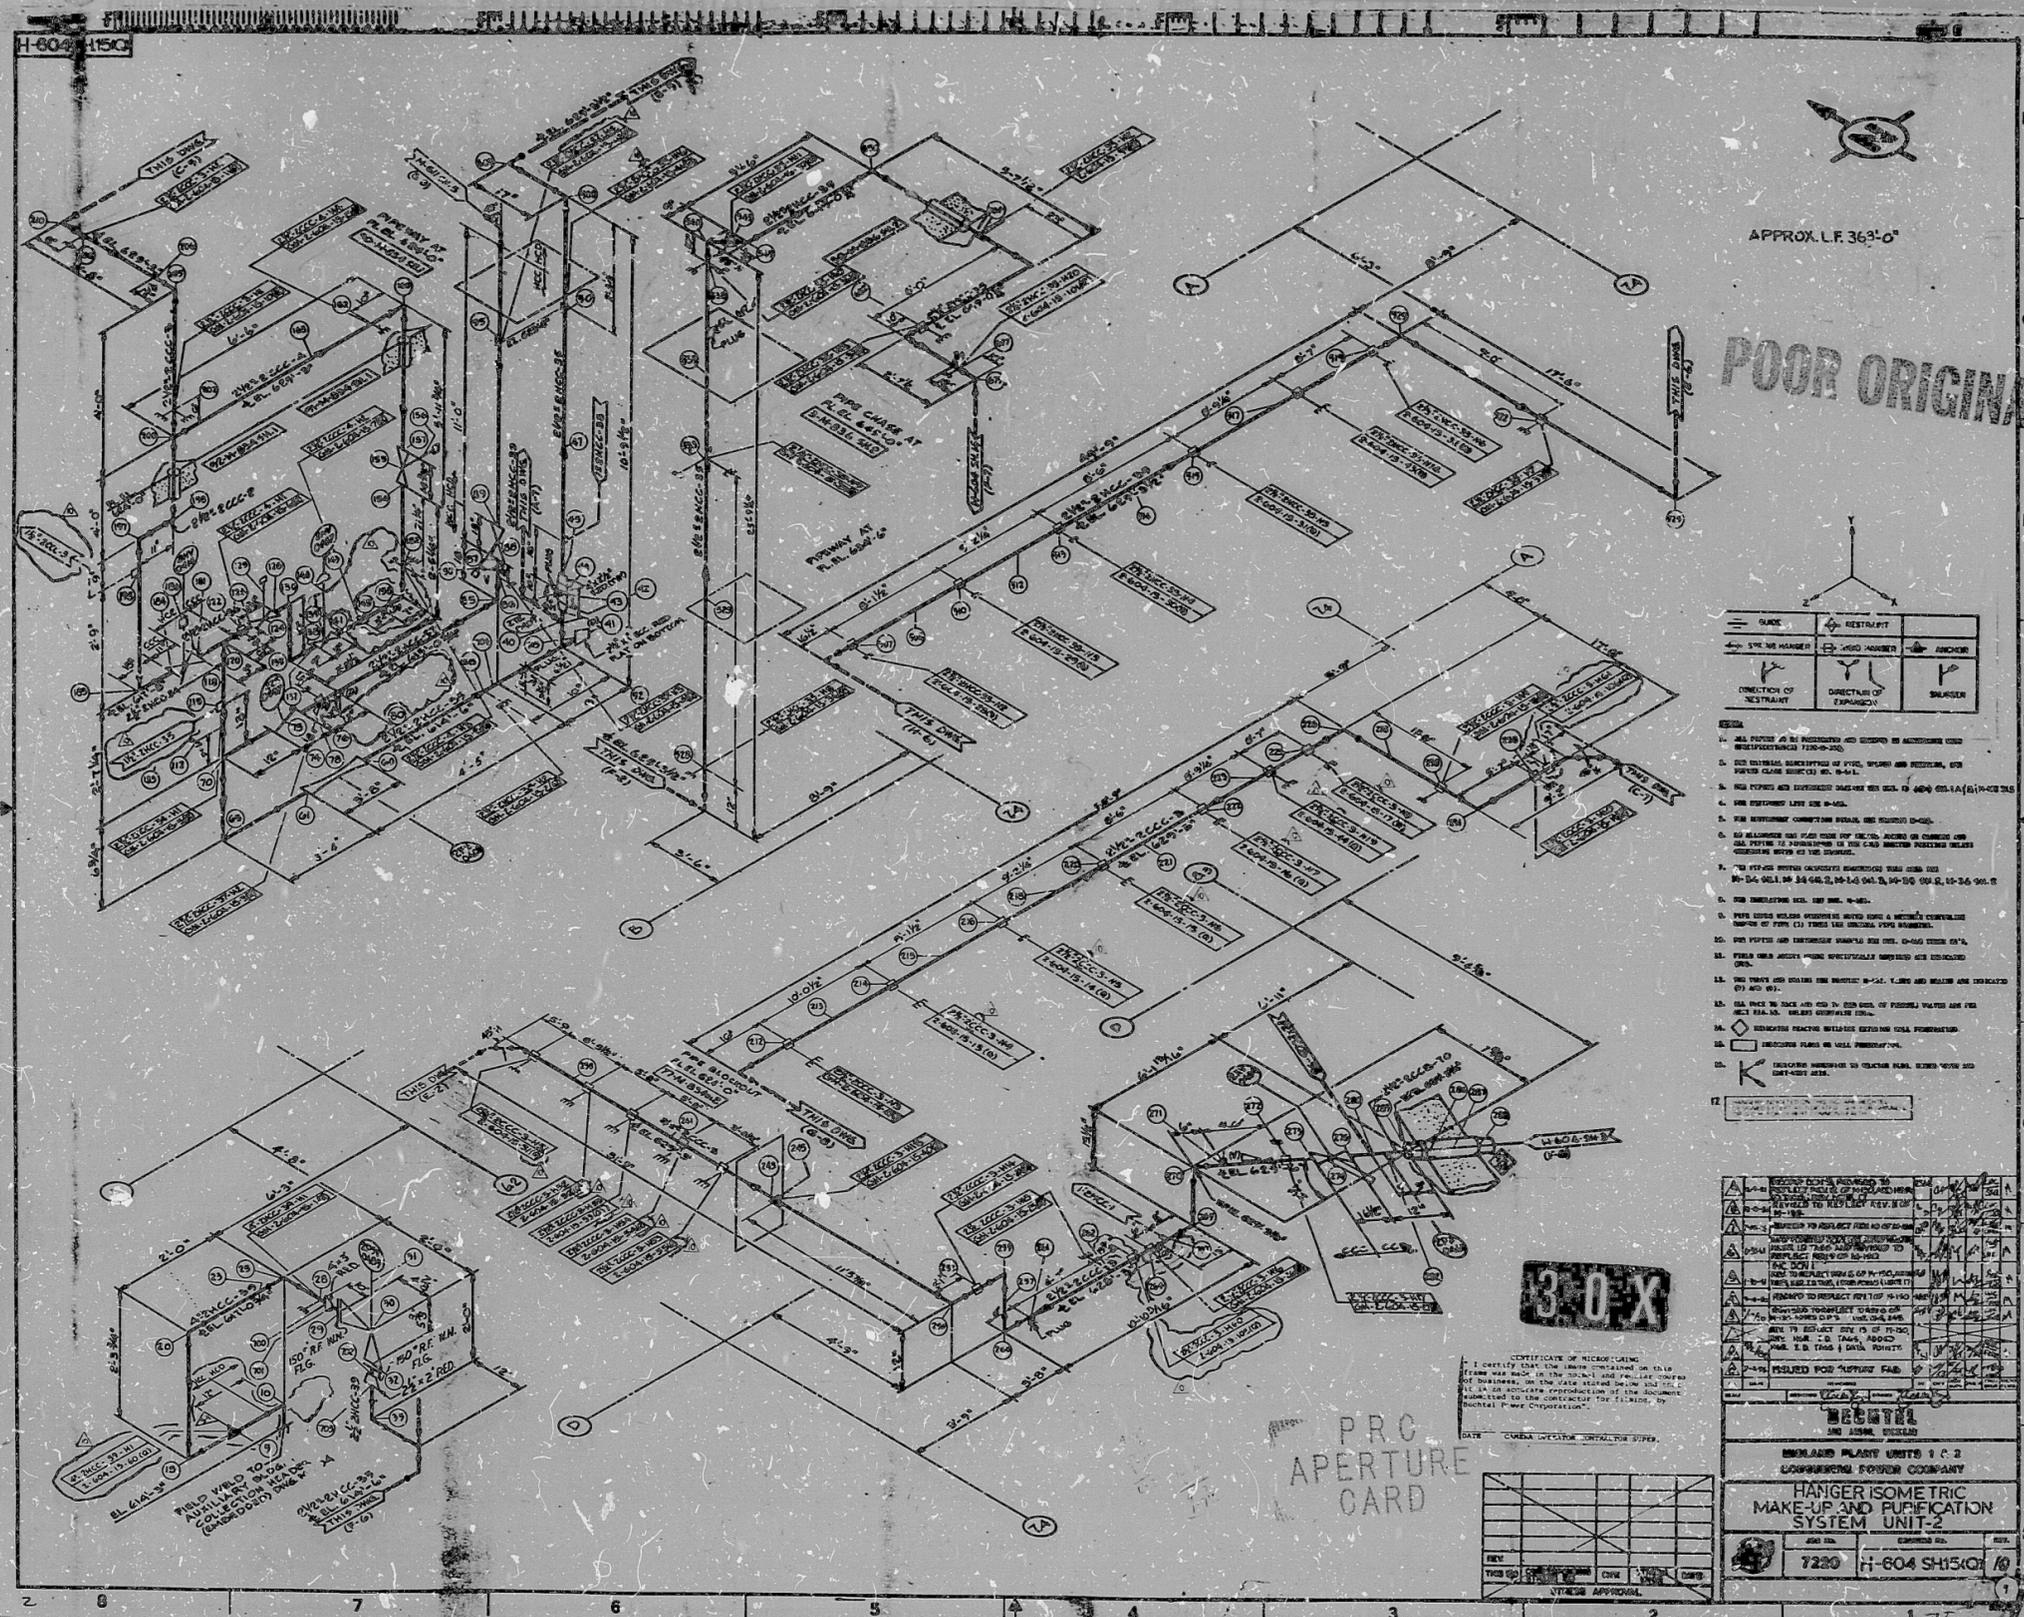

APPROX. L.F. 363'-0"

**POOR ORIGINAL**

—	RESTRAINT	
—	SHOCK ABSORBER	ANCHOR
—	DIRECTION OF RESTRAINT	DIRECTION OF EXPANSION
		SHIELDER

- NOTES:**
**3-0-X**

CERTIFICATE OF MICROFILMING  


REVISION	DATE	BY	CHKD	APP'D
1				
2				
3				
4				
5				
6				
7				
8				
9				
10				

**HANGER ISOMETRIC MAKE-UP AND PURIFICATION SYSTEM UNIT-2**  
 SHEET NO. 7220 H-604 SH150/10

17  
11  
8.5  
8.5  
11  
17

RIDS

8302150122

