


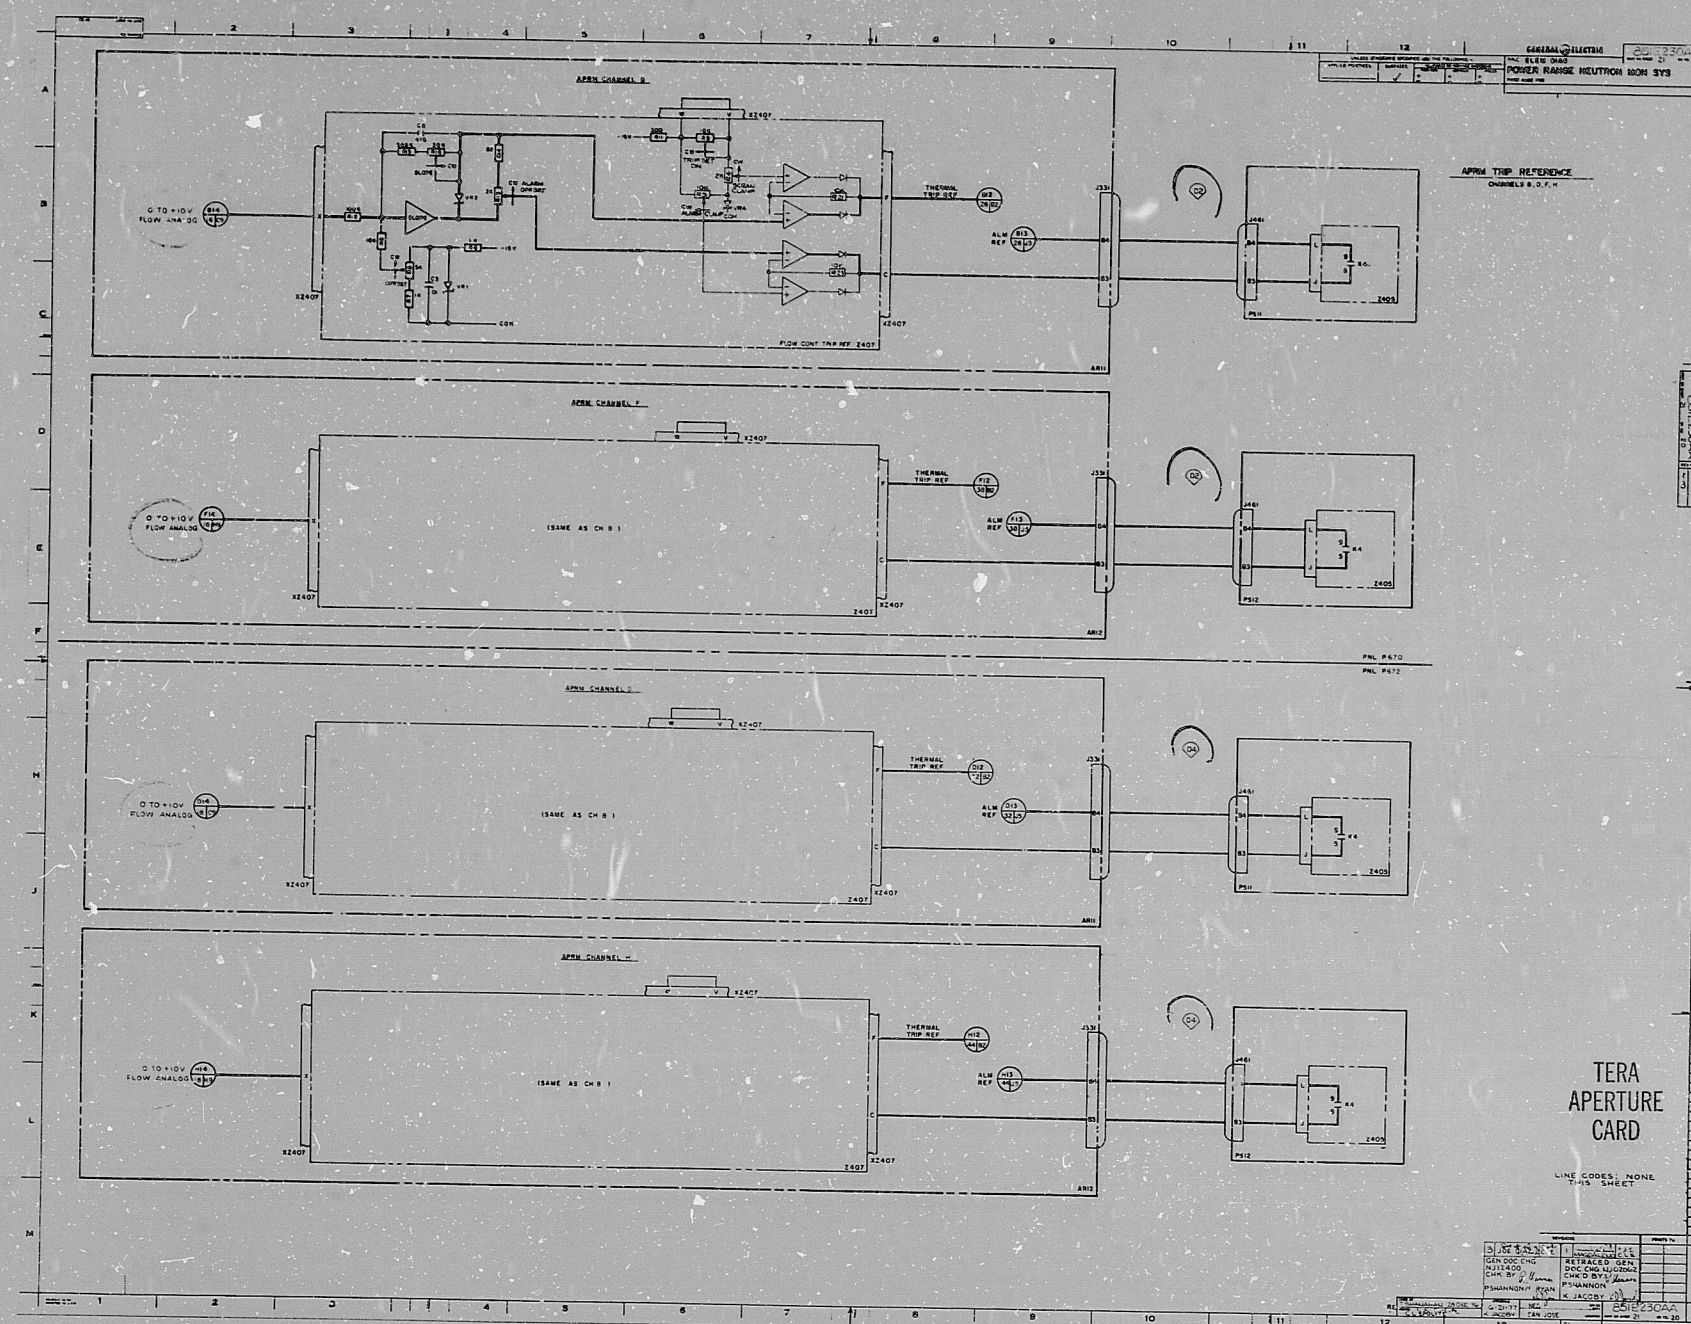



RIDS

8109220784

