

17


11

8.5

8.5

11

17

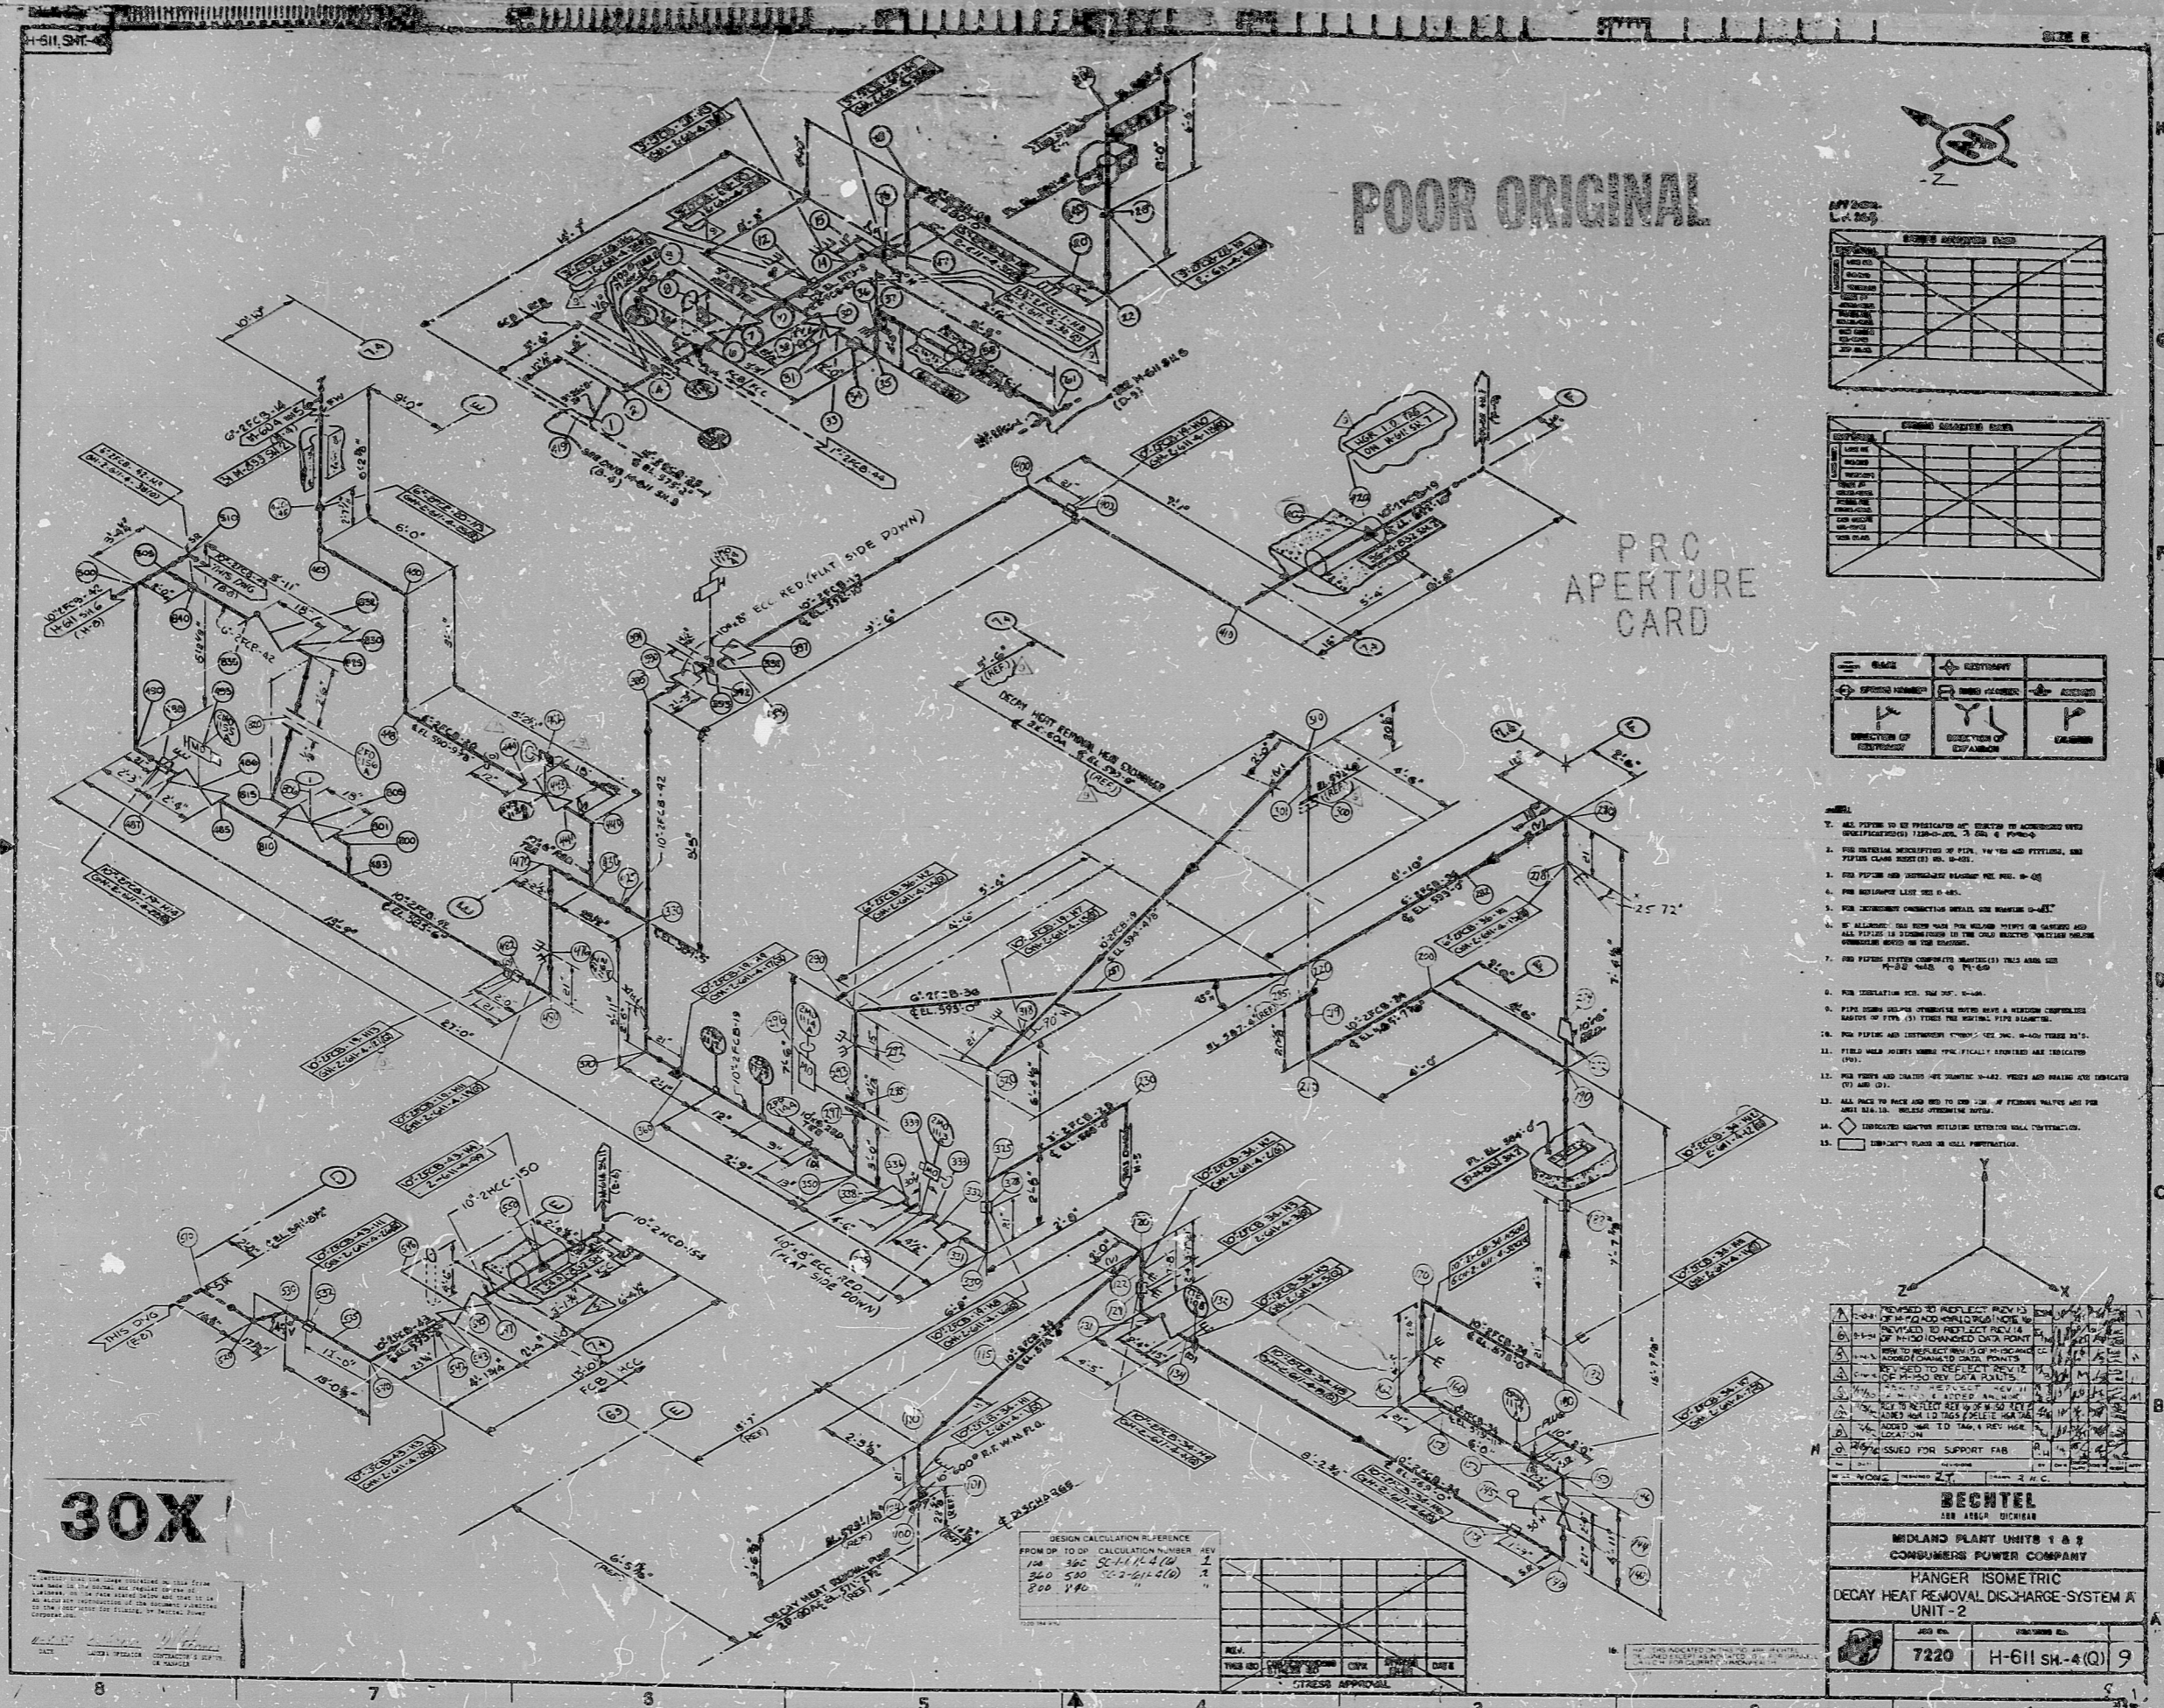

NO.	DATE	DESCRIPTION

NO.	DATE	DESCRIPTION

FLOW DIRECTION	DIRECTION OF EXPANSION

NO.	DATE	DESCRIPTION	BY	CHKD.

BECHTEL
MIDLAND PLANT UNITS 1 & 2
CONSUMERS POWER COMPANY
HANGER ISOMETRIC
DECAY HEAT REMOVAL DISCHARGE SYSTEM A
UNIT 2

7220 H-611 SH-4(O) 9

30X


DESIGN CALCULATION REFERENCE
FROM DP TO DP CALCULATION NUMBER

NO.	DATE	DESCRIPTION	BY	CHKD.

17

11

8.5

8.5

11

17

RIDS

8302150164

