


H613 SH2(Q)

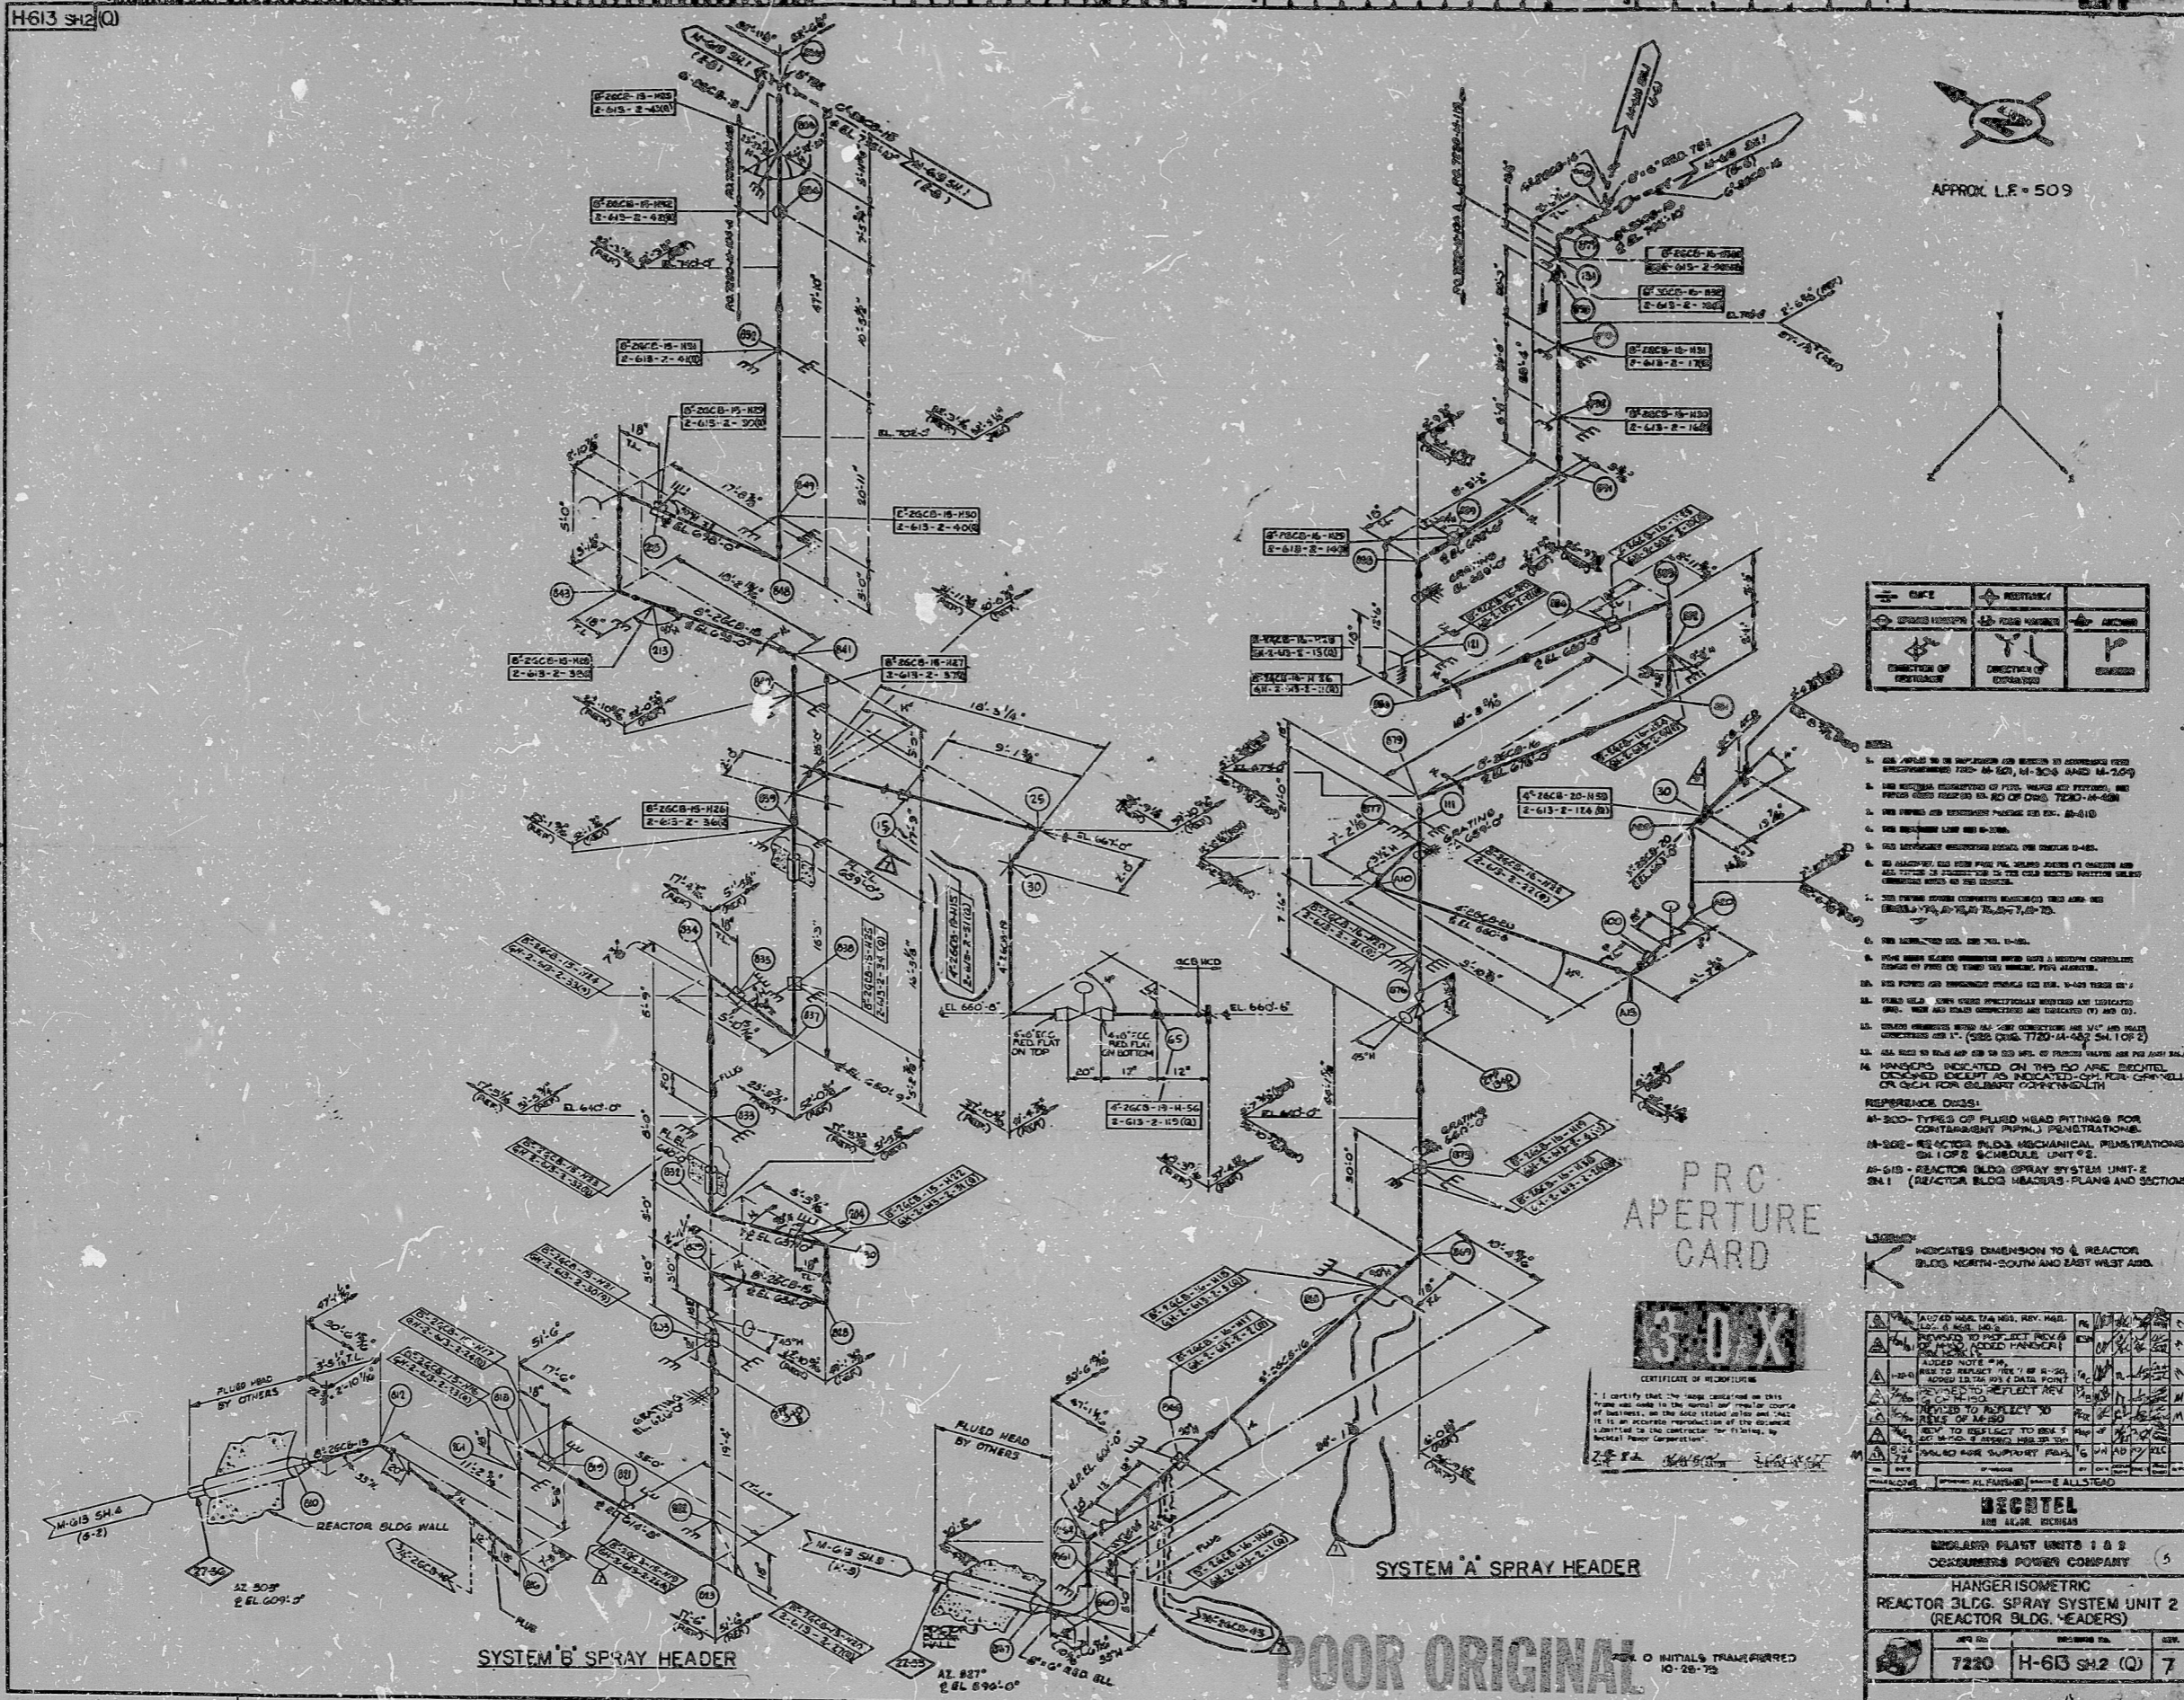

APPROX. L.F. = 509




PRO APERTURE CARD

3-0 X





HANGER ISOMETRIC	
REACTOR BLDG. SPRAY SYSTEM UNIT 2	
(REACTOR BLDG. HEADERS)	
7230	H-613 SH2 (Q)
7	7

POOR ORIGINAL

FOR O INITIALS TRANSFERRED 10-26-72



RIDS

8302150204

