

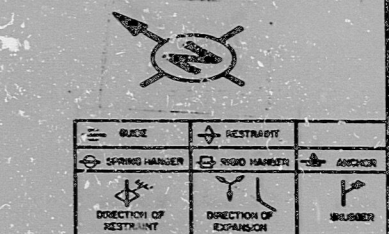


H-616 SH12 (C)

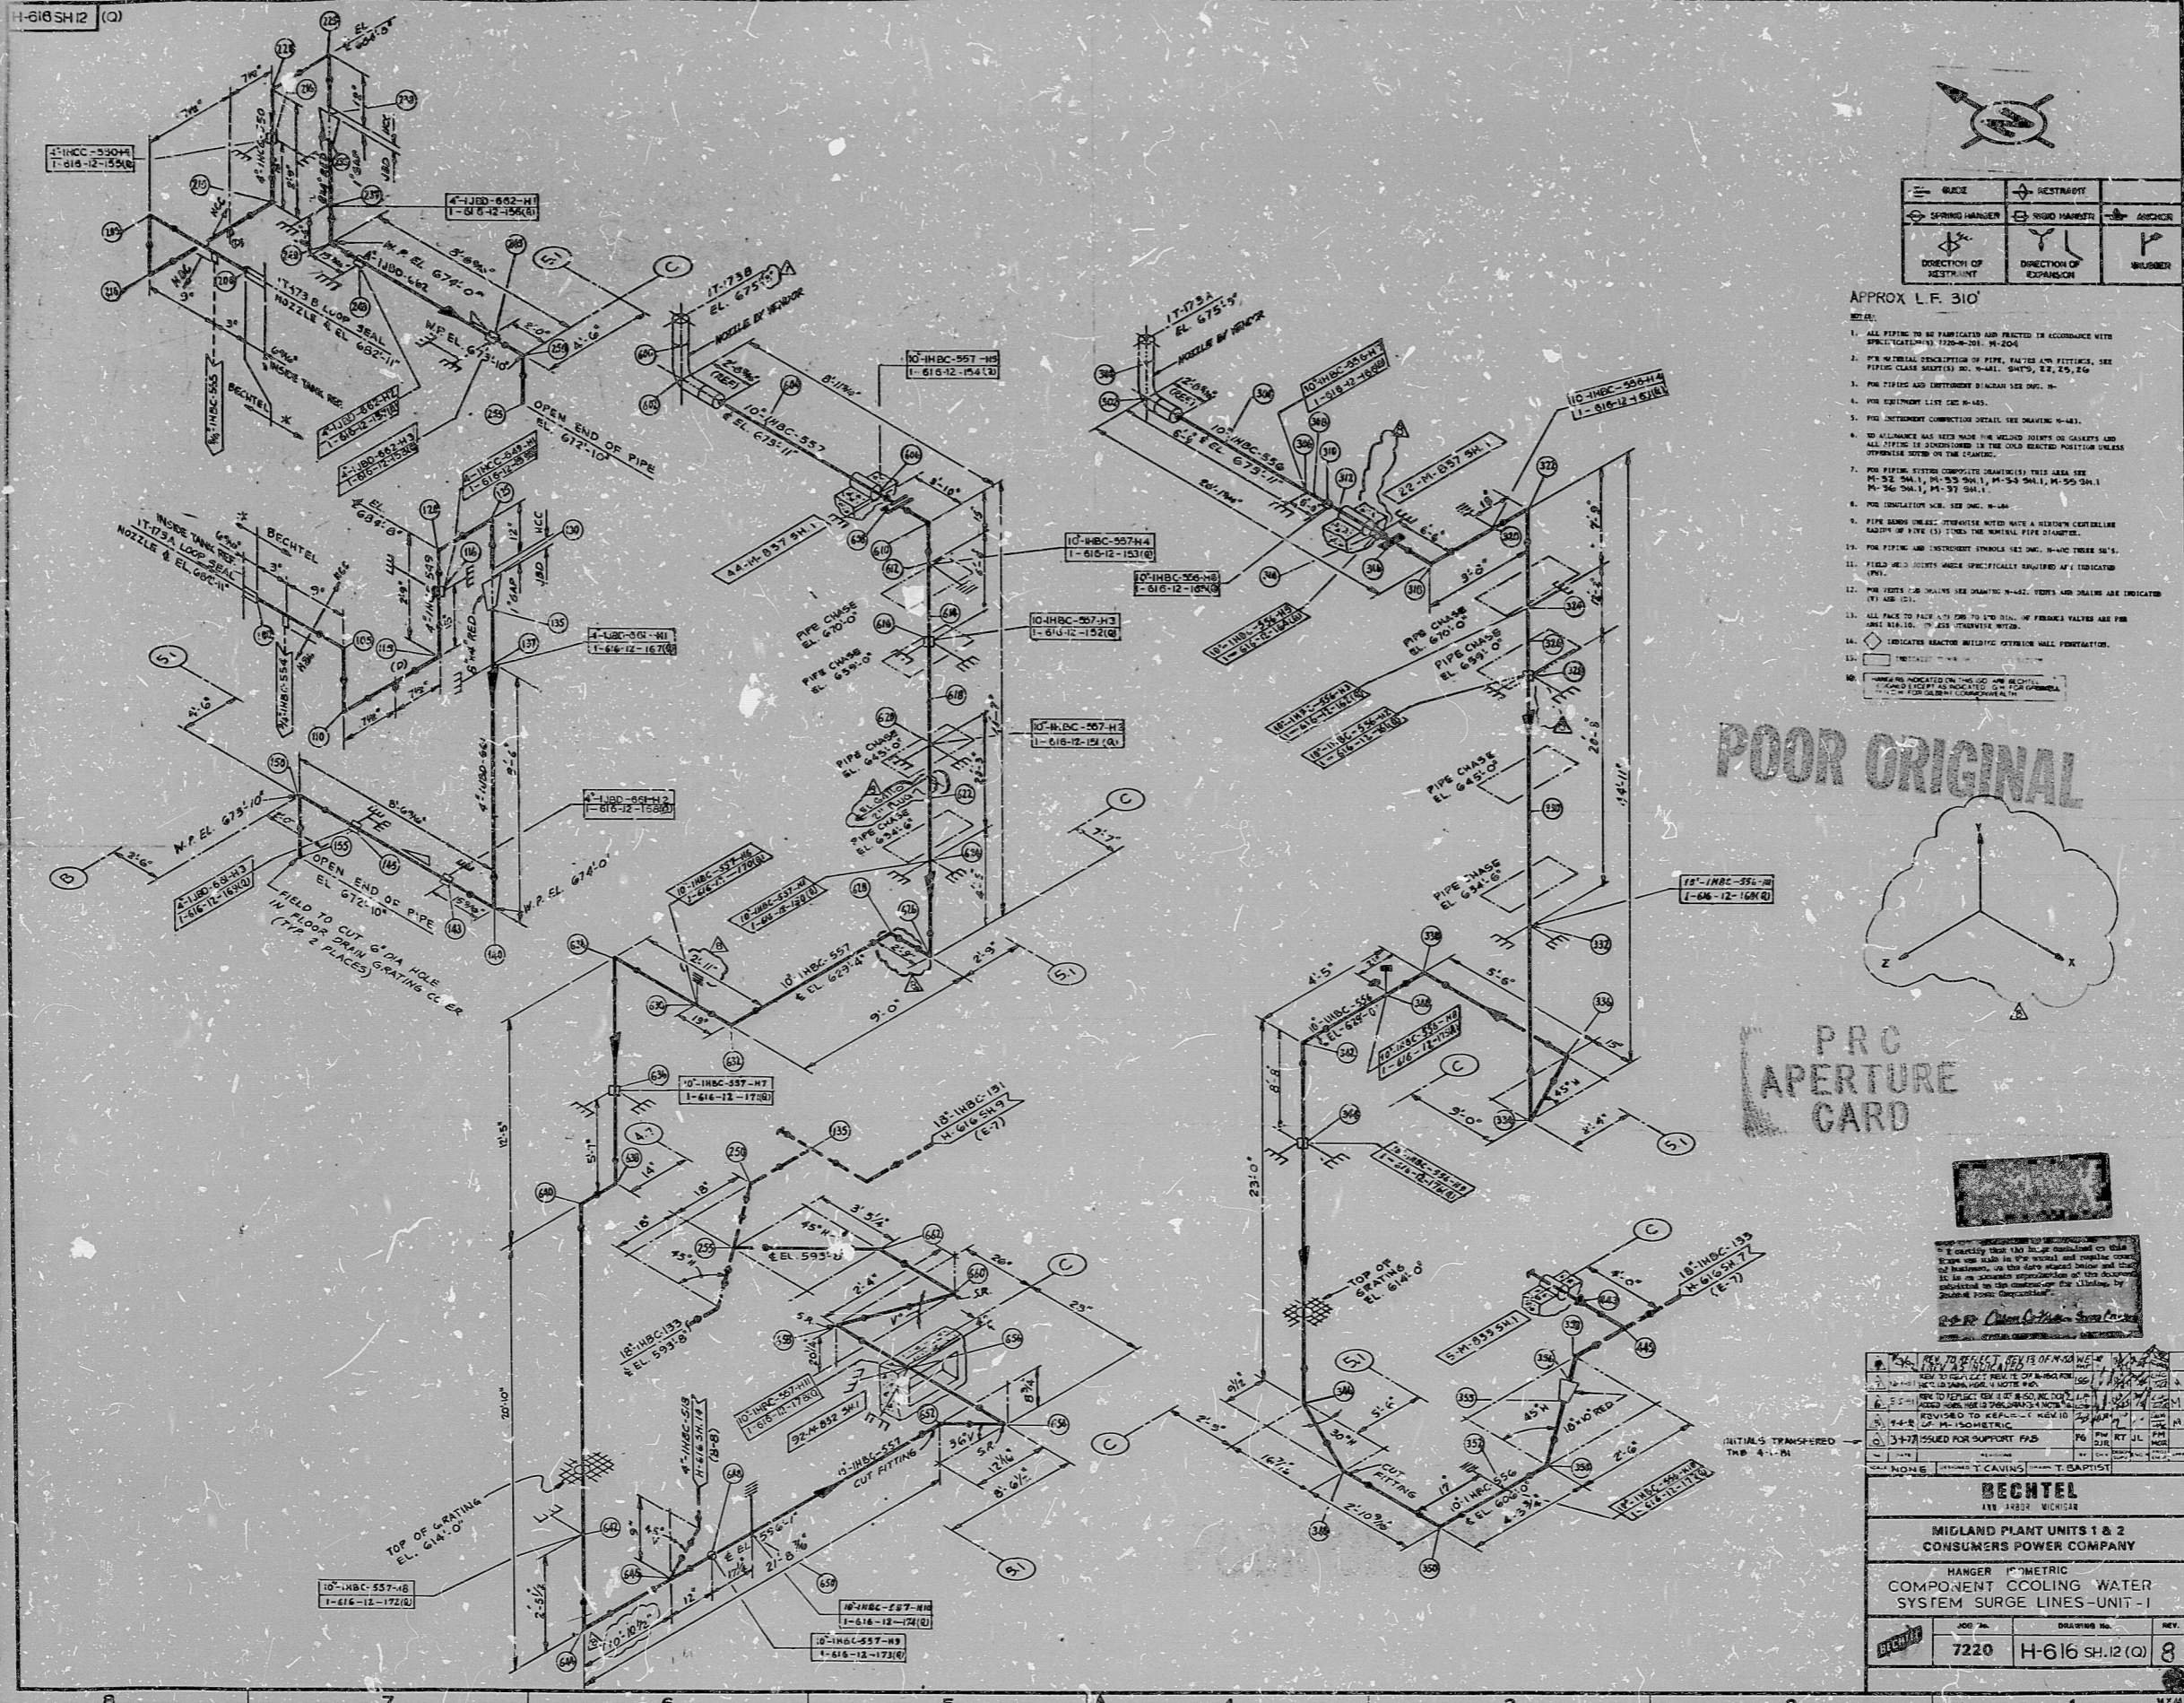

- APPROX. L.F. 310
1. ALL PIPING TO BE FABRICATED AND INSTALLED IN ACCORDANCE WITH SPECIFICATION 1220-8-201, M-204.

POOR ORIGINAL

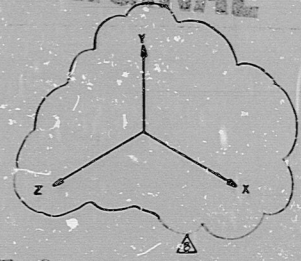

PRC APERTURE CARD

BECHTEL


BY: T. CAVINS

CHECKED: T. CAVINS

APPROVED: T. CAVINS

| | | | |
|----|------|----------------|---|
| 7 | 7220 | H-616 SH12 (C) | 8 |
| 8 | | | |
| 9 | | | |
| | | | |
|--|----------------|---------------------------|--|
| BECHTEL | | MIGLAND PLANT UNITS 1 & 2 | |
| HANGER ISOMETRIC COMPONENT COOLING WATER SYSTEM SURGE LINES-UNIT-1 | | | |
| 7220 | H-616 SH12 (C) | 8 | |

RIDS

8302150253

