


17"
11"
8.5"
8.5"
11"
17"

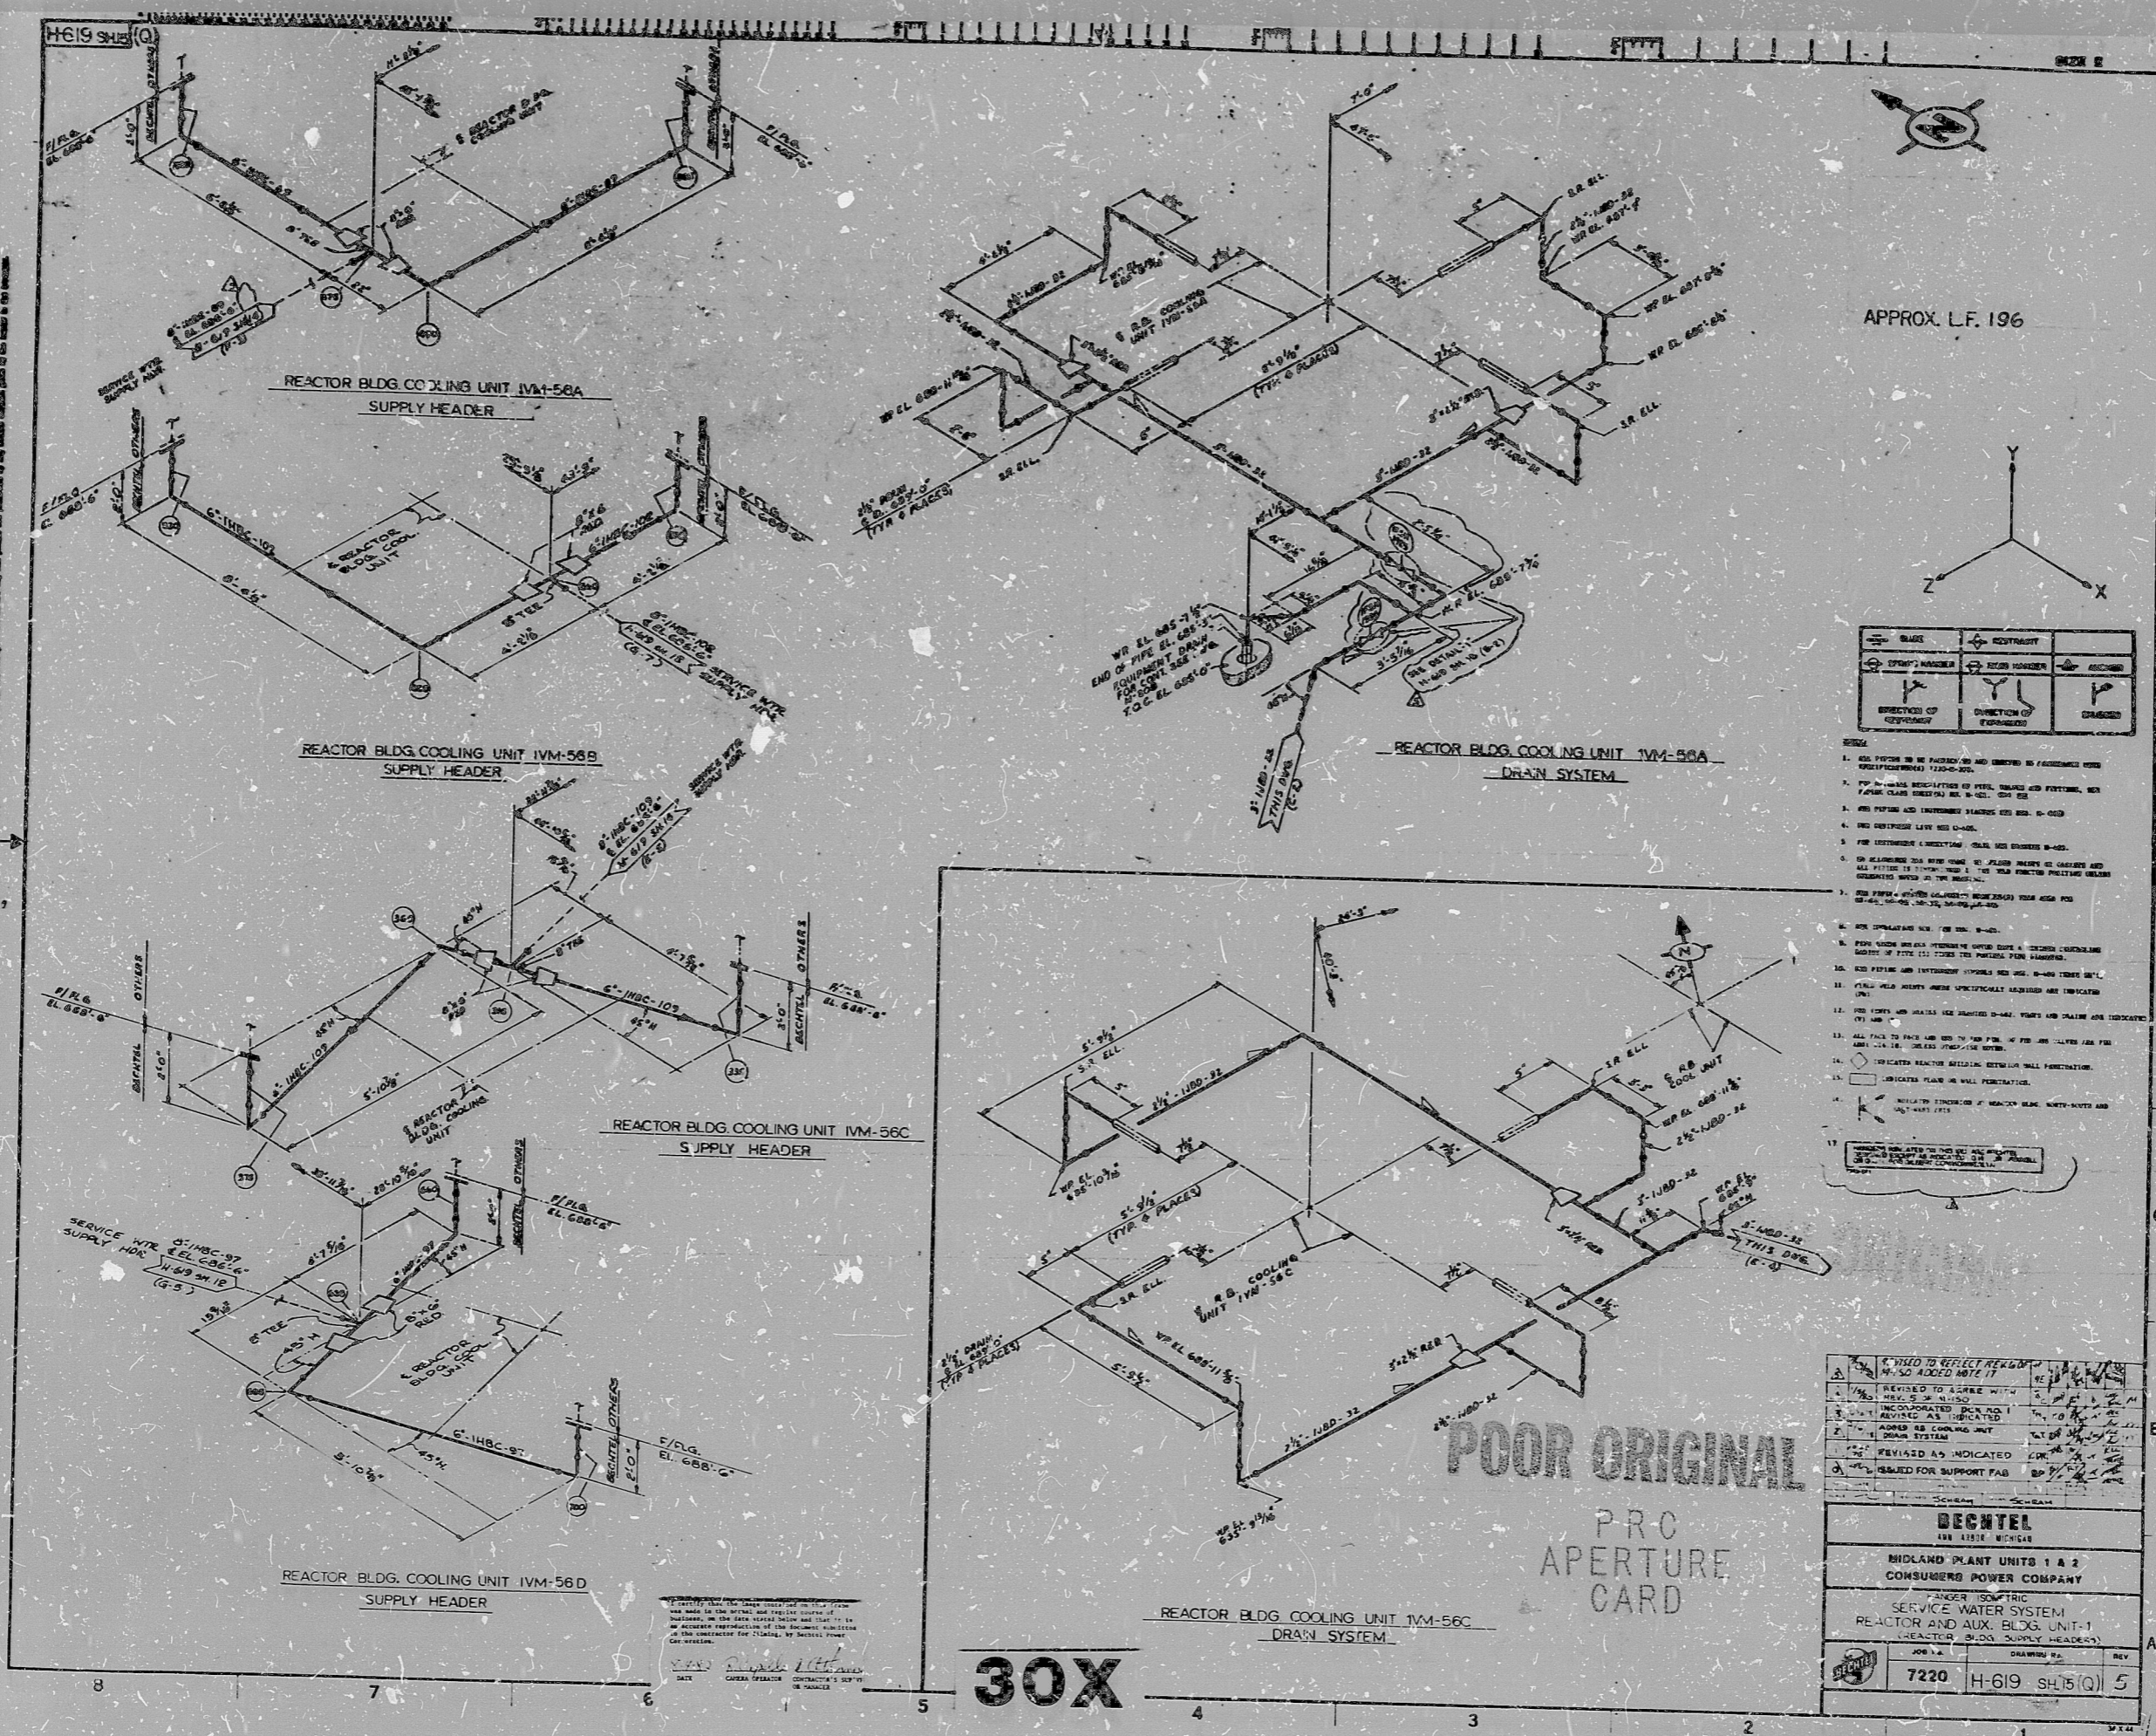

APPROX. L.F. 196

| | |
|--|--|
| | |
| | |
| | |

| | | | |
|-----|----------|-----|-----|
| NO. | DATE | BY | FOR |

BECHTEL

MIDLAND PLANT UNITS 1 & 2
CONSUMERS POWER COMPANY

SERVICE WATER SYSTEM
REACTOR AND AUX. BLDG. UNIT-1
(REACTOR BLDG. SUPPLY HEADERS)

7220 H-619 SH-15(Q) 5

30X

RIDS

8302160038

