


H-633 SH.2


SIZE E

APPROX. L.F. 269

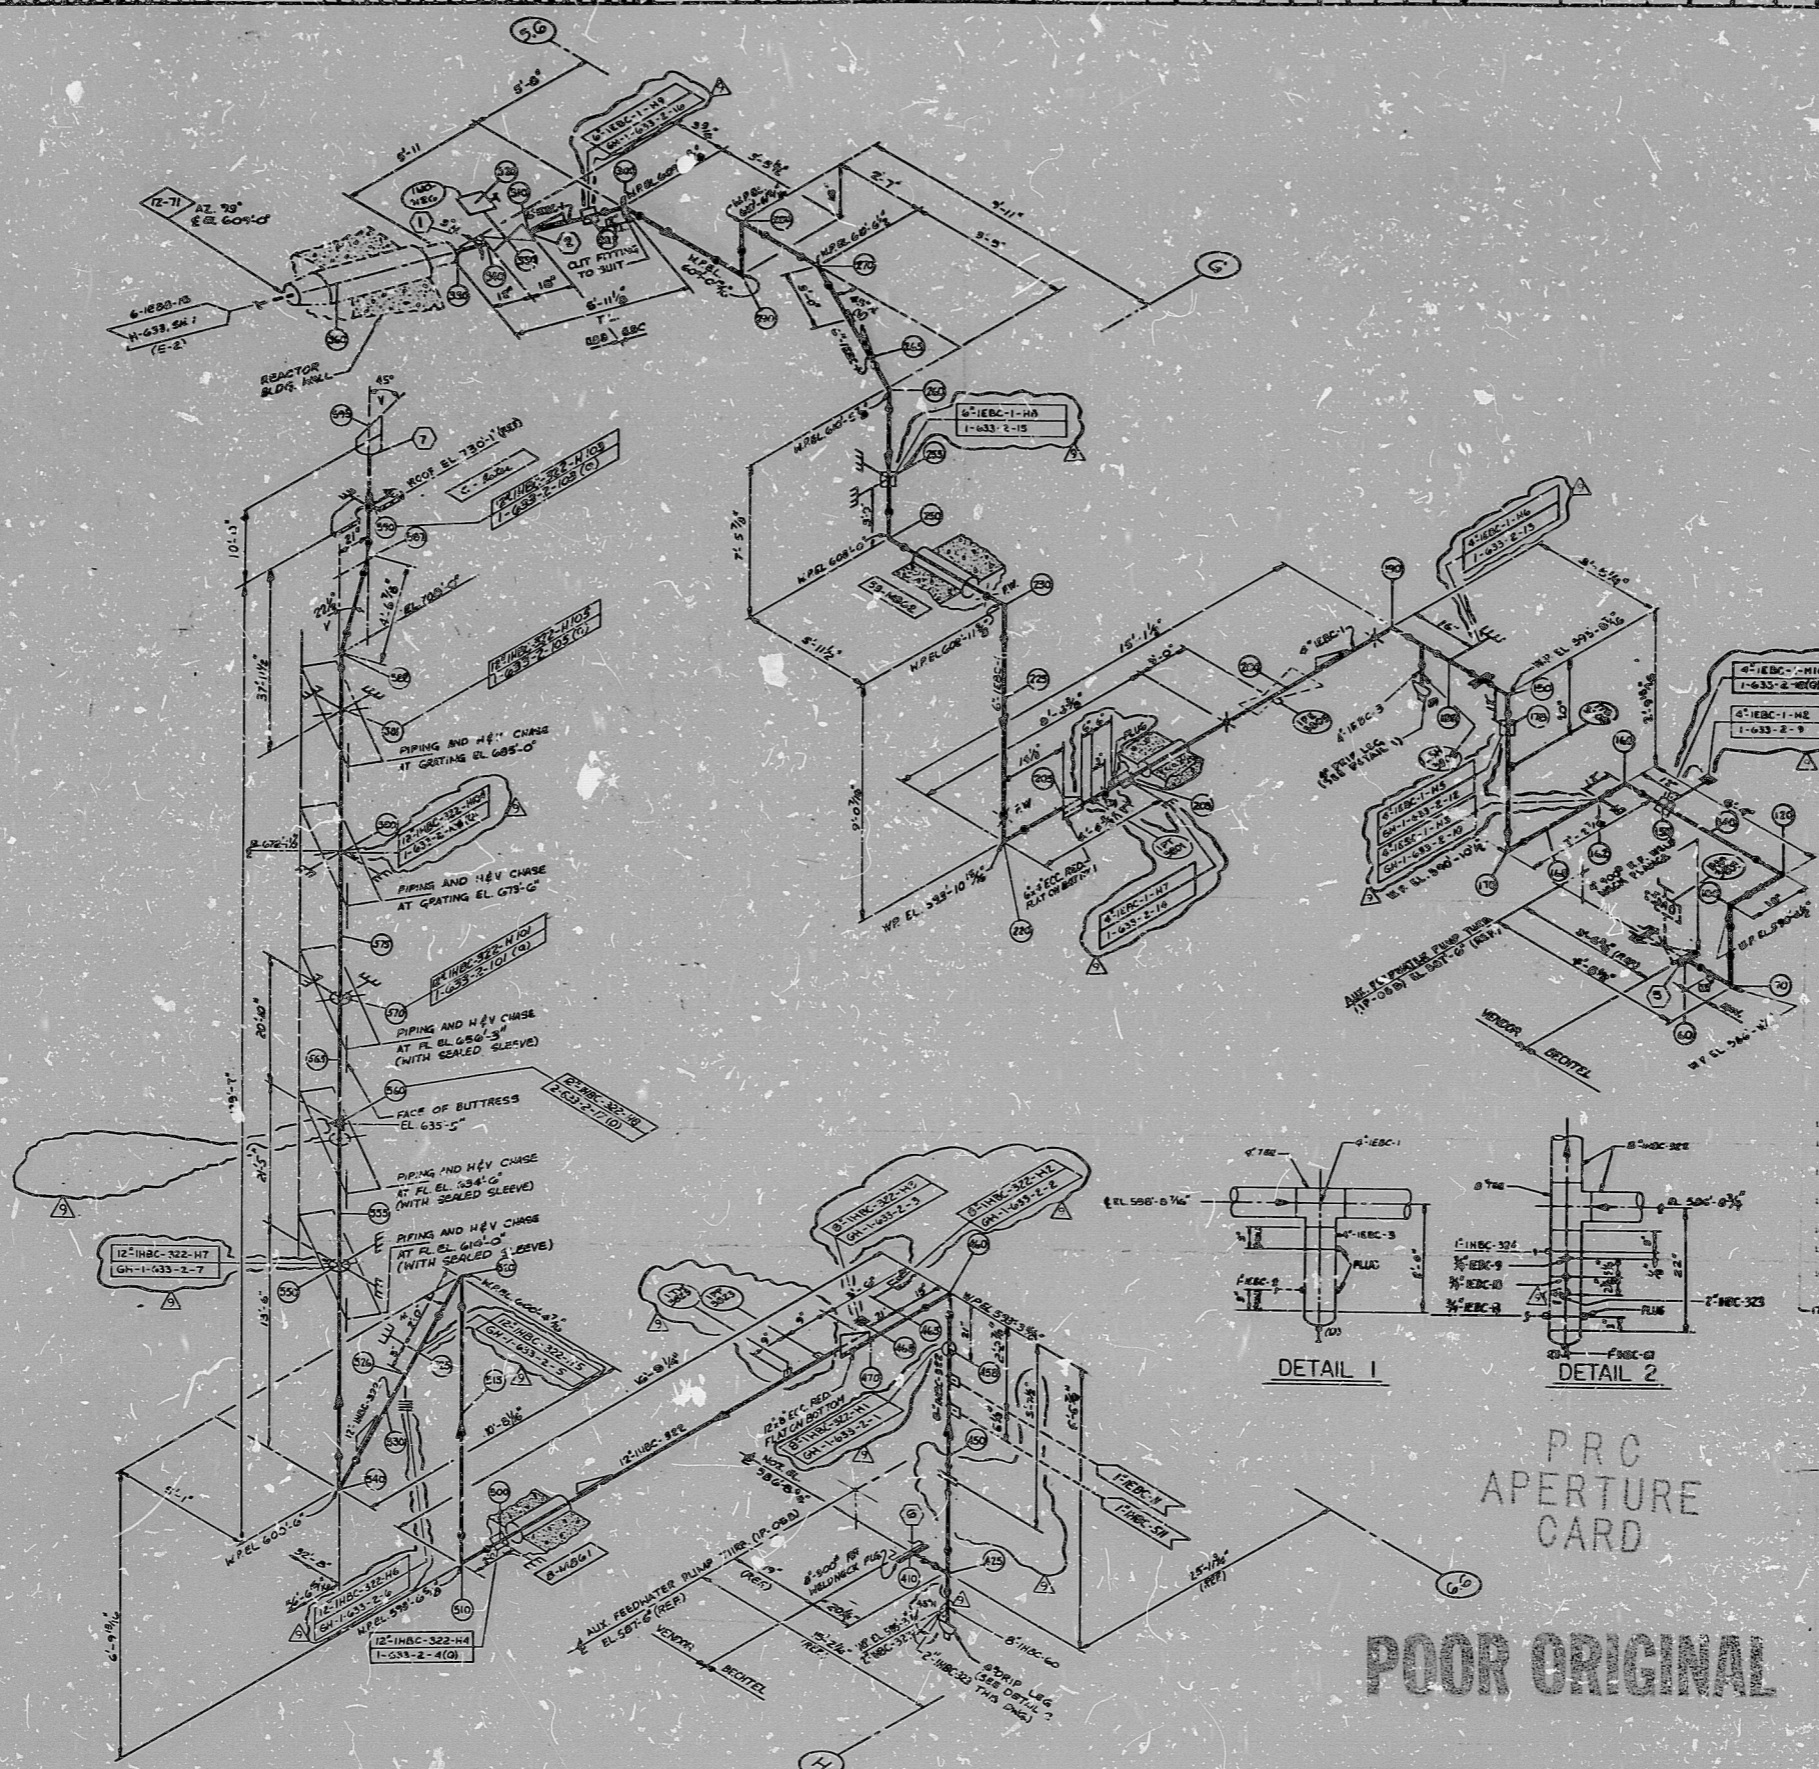

—	RESTRAINT	—	RESTRAINT
—	SPECIAL HANGER	—	ROD HANGER
—	DIRECTION OF RESTRAINT	—	DIRECTION OF EXPANSION
—	DISASSEMBLED	—	DISASSEMBLED

- NOTES:
1. ALL PIPING TO BE FABRICATED TO MEET THE REQUIREMENTS SPECIFIED IN THE SPECIFICATIONS AND THE CODES REFERRED TO THEREIN.
  2. FOR MATERIAL SPECIFICATIONS OF PIPE, TUBES, FITTINGS, AND PIPE FLANGES SEE THE QUANTITY LIST OF DWG. 7220 M-431.
  3. FOR PIPE AND FITTING DIMENSIONS SEE FIGS. M-432 AND M-433.
  4. FOR DIMENSIONS OF FITTING SEE FIG. M-434.
  5. FOR DIMENSION CONNECTION DETAILS SEE DWG. M-435.
  6. ALL ALLOWANCE SHALL BE MADE FOR WELDING TOLERANCES AND ALL FITS SHALL BE AS SHOWN IN THE DIMENSIONS SPECIFIED UNLESS OTHERWISE NOTED ON THE DRAWING.
  7. FOR PIPE STAYS, SUPPORTS, AND HANGERS SEE DWG. M-436, M-437, M-438, M-999, M-1000.
  8. HANGERS INDICATED ON THIS DRAWING ARE BECHTEL DESIGNED HANGERS. FOR ALL OTHER HANGERS THIS DRAWING SHALL BE REFERRED TO DWG. M-430.

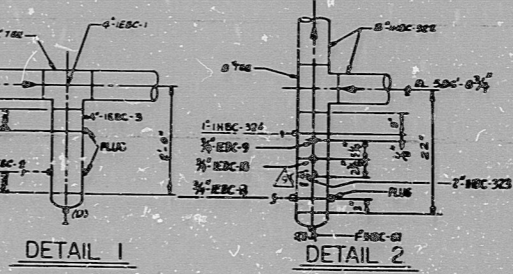

PRC APERTURE CARD

POOR ORIGINAL

NO.	DESCRIPTION	DATE	BY	CHKD.
1	ISSUED FOR SUPPORT FAB			
2	ISSUED FOR SUPPORT FAB			
<b>BECHTEL</b>	
AND ASSOCIATES	
SANDLAND PLANT UNITS 1 & 2	
CONSUMERS POWER COMPANY	
HANGER ISOMETRIC	
AUXILIARY STEAM & TURBINE EXHAUST	
UNIT 1	
JOB NO.	DRAWING NO.
7220	H-633 SH-2 (Q)
REV.	9

11  
11  
8.5  
8.5  
11  
8.5  
11  
17

11  
11  
8.5  
8.5  
11  
8.5  
11  
17

RID

8302160048

