


17"
11"
8.5"
8.5"
11"
17"

17"
11"
8.5"
8.5"
11"
17"

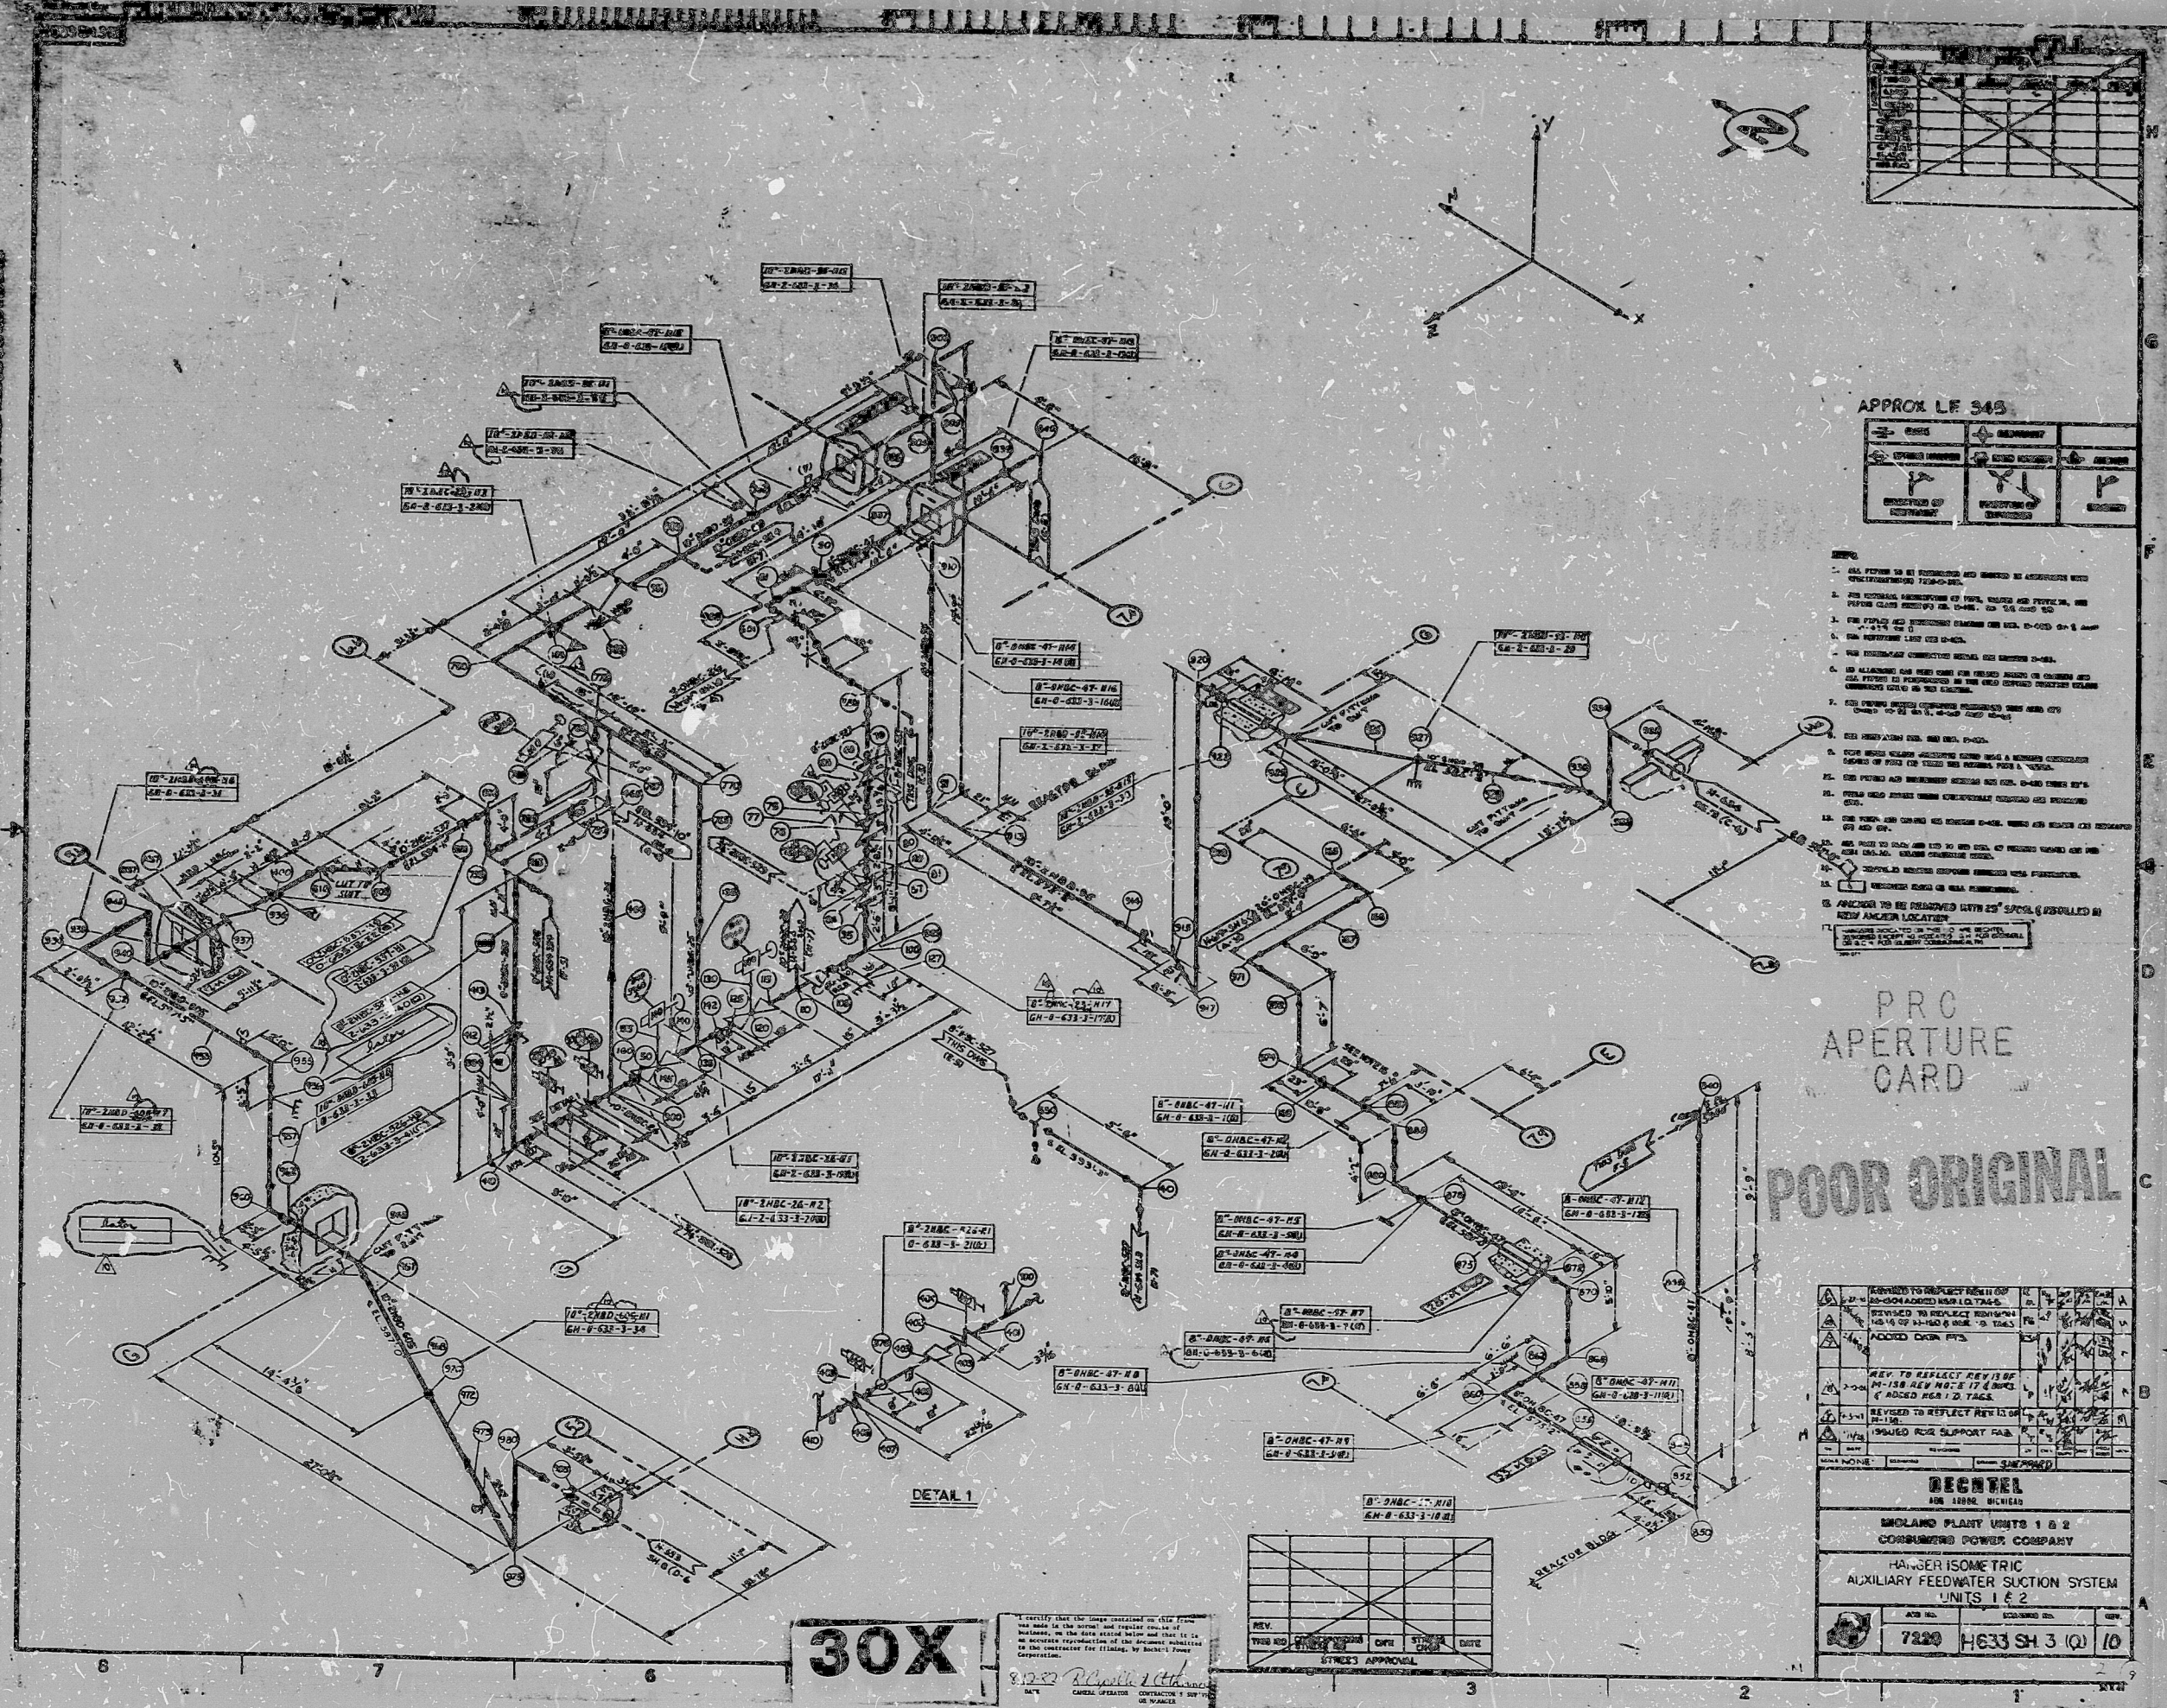

APPROX LF 345

→	←	↖	↗
○	○	○	○
○	○	○	○
○	○	○	○

PRC
APERTURE
CARD

POOR ORIGINAL

ISSUED FOR SUPPORT FAB.		

BECHTEL

CONSUMERS POWER COMPANY

HANGER ISOMETRIC
AUXILIARY FEEDWATER SUCTION SYSTEM
UNITS 1 & 2

DATE	ISSUED	BY

30X


RIDS

8302160053

