


H-633 SH.6 (Q)

17"
11"
8.5"
8.5"
11"
17"

17"
11"
8.5"
8.5"
11"
17"

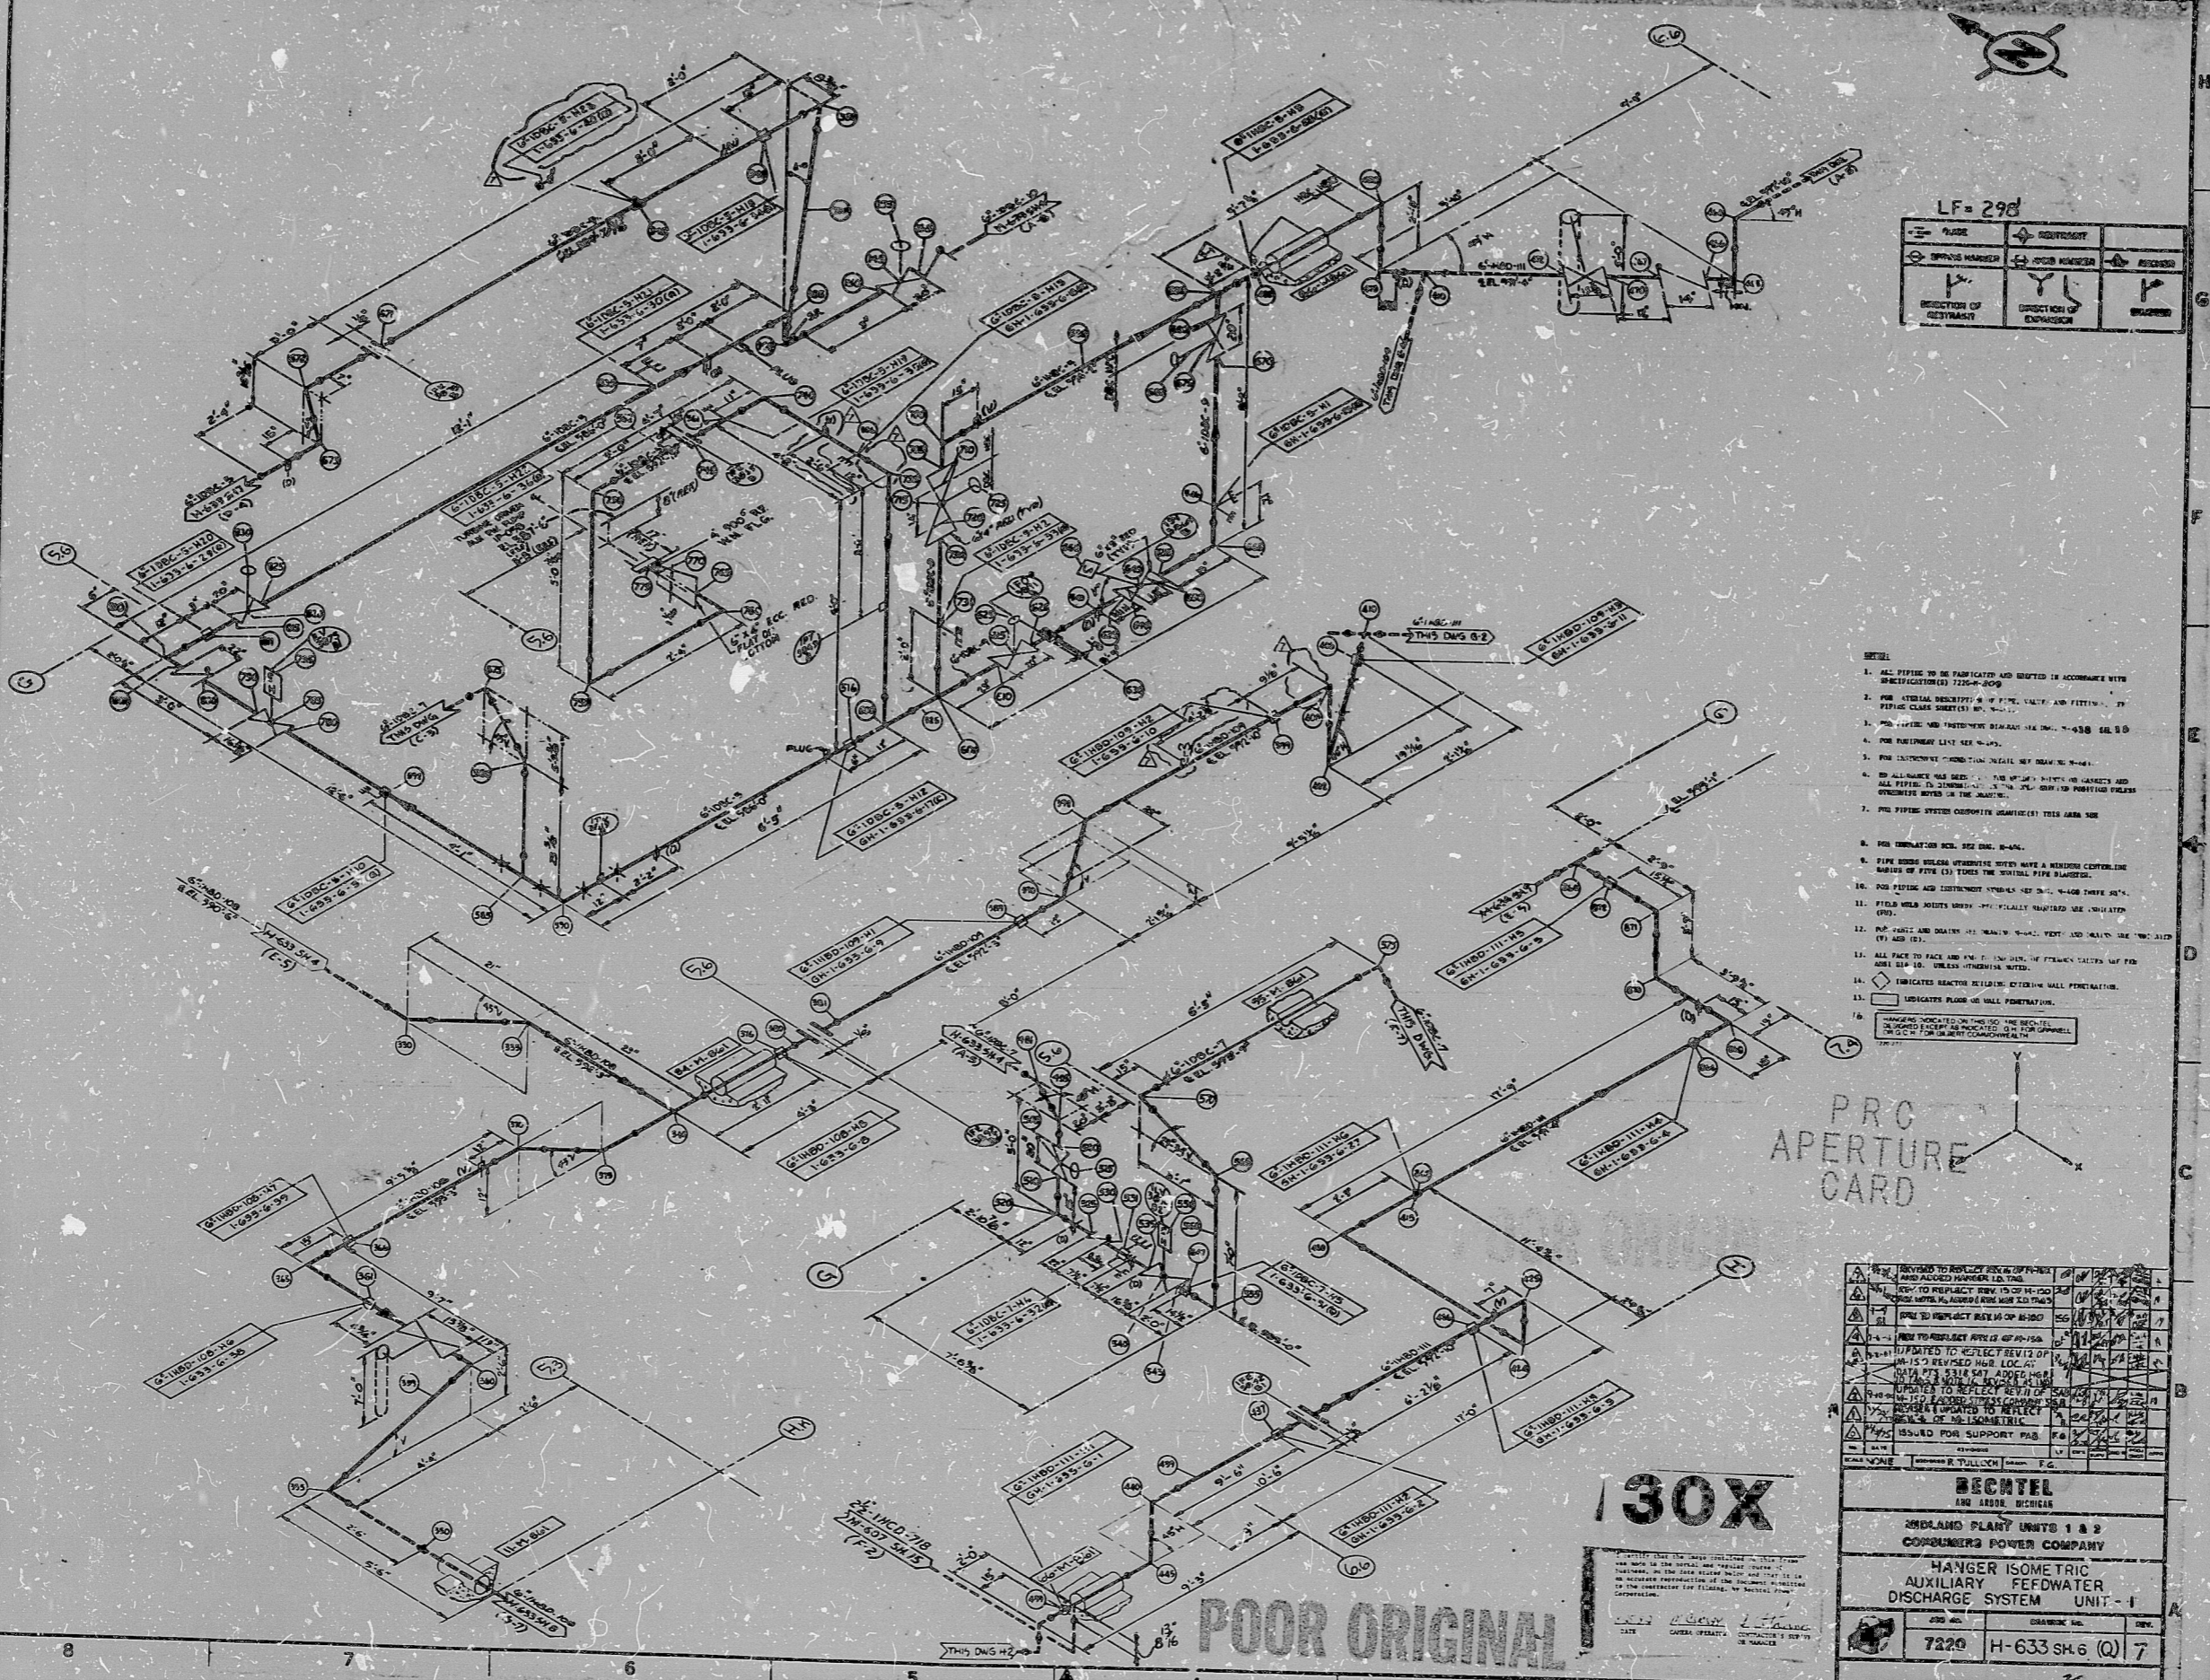

LF = 290

DIRECTION OF RETRACTION	DIRECTION OF EXPANSION
	ACCESS

- NOTES:

PRC APERTURE CARD

30X

POOR ORIGINAL

RECNTEL


HANGER ISOMETRIC
AUXILIARY FEEDWATER
DISCHARGE SYSTEM UNIT - 1

7220 H-633 SH.6 (Q) 7

RIDS

8302160059

