

17"


11"

8.5"

8.5"

11"

17"

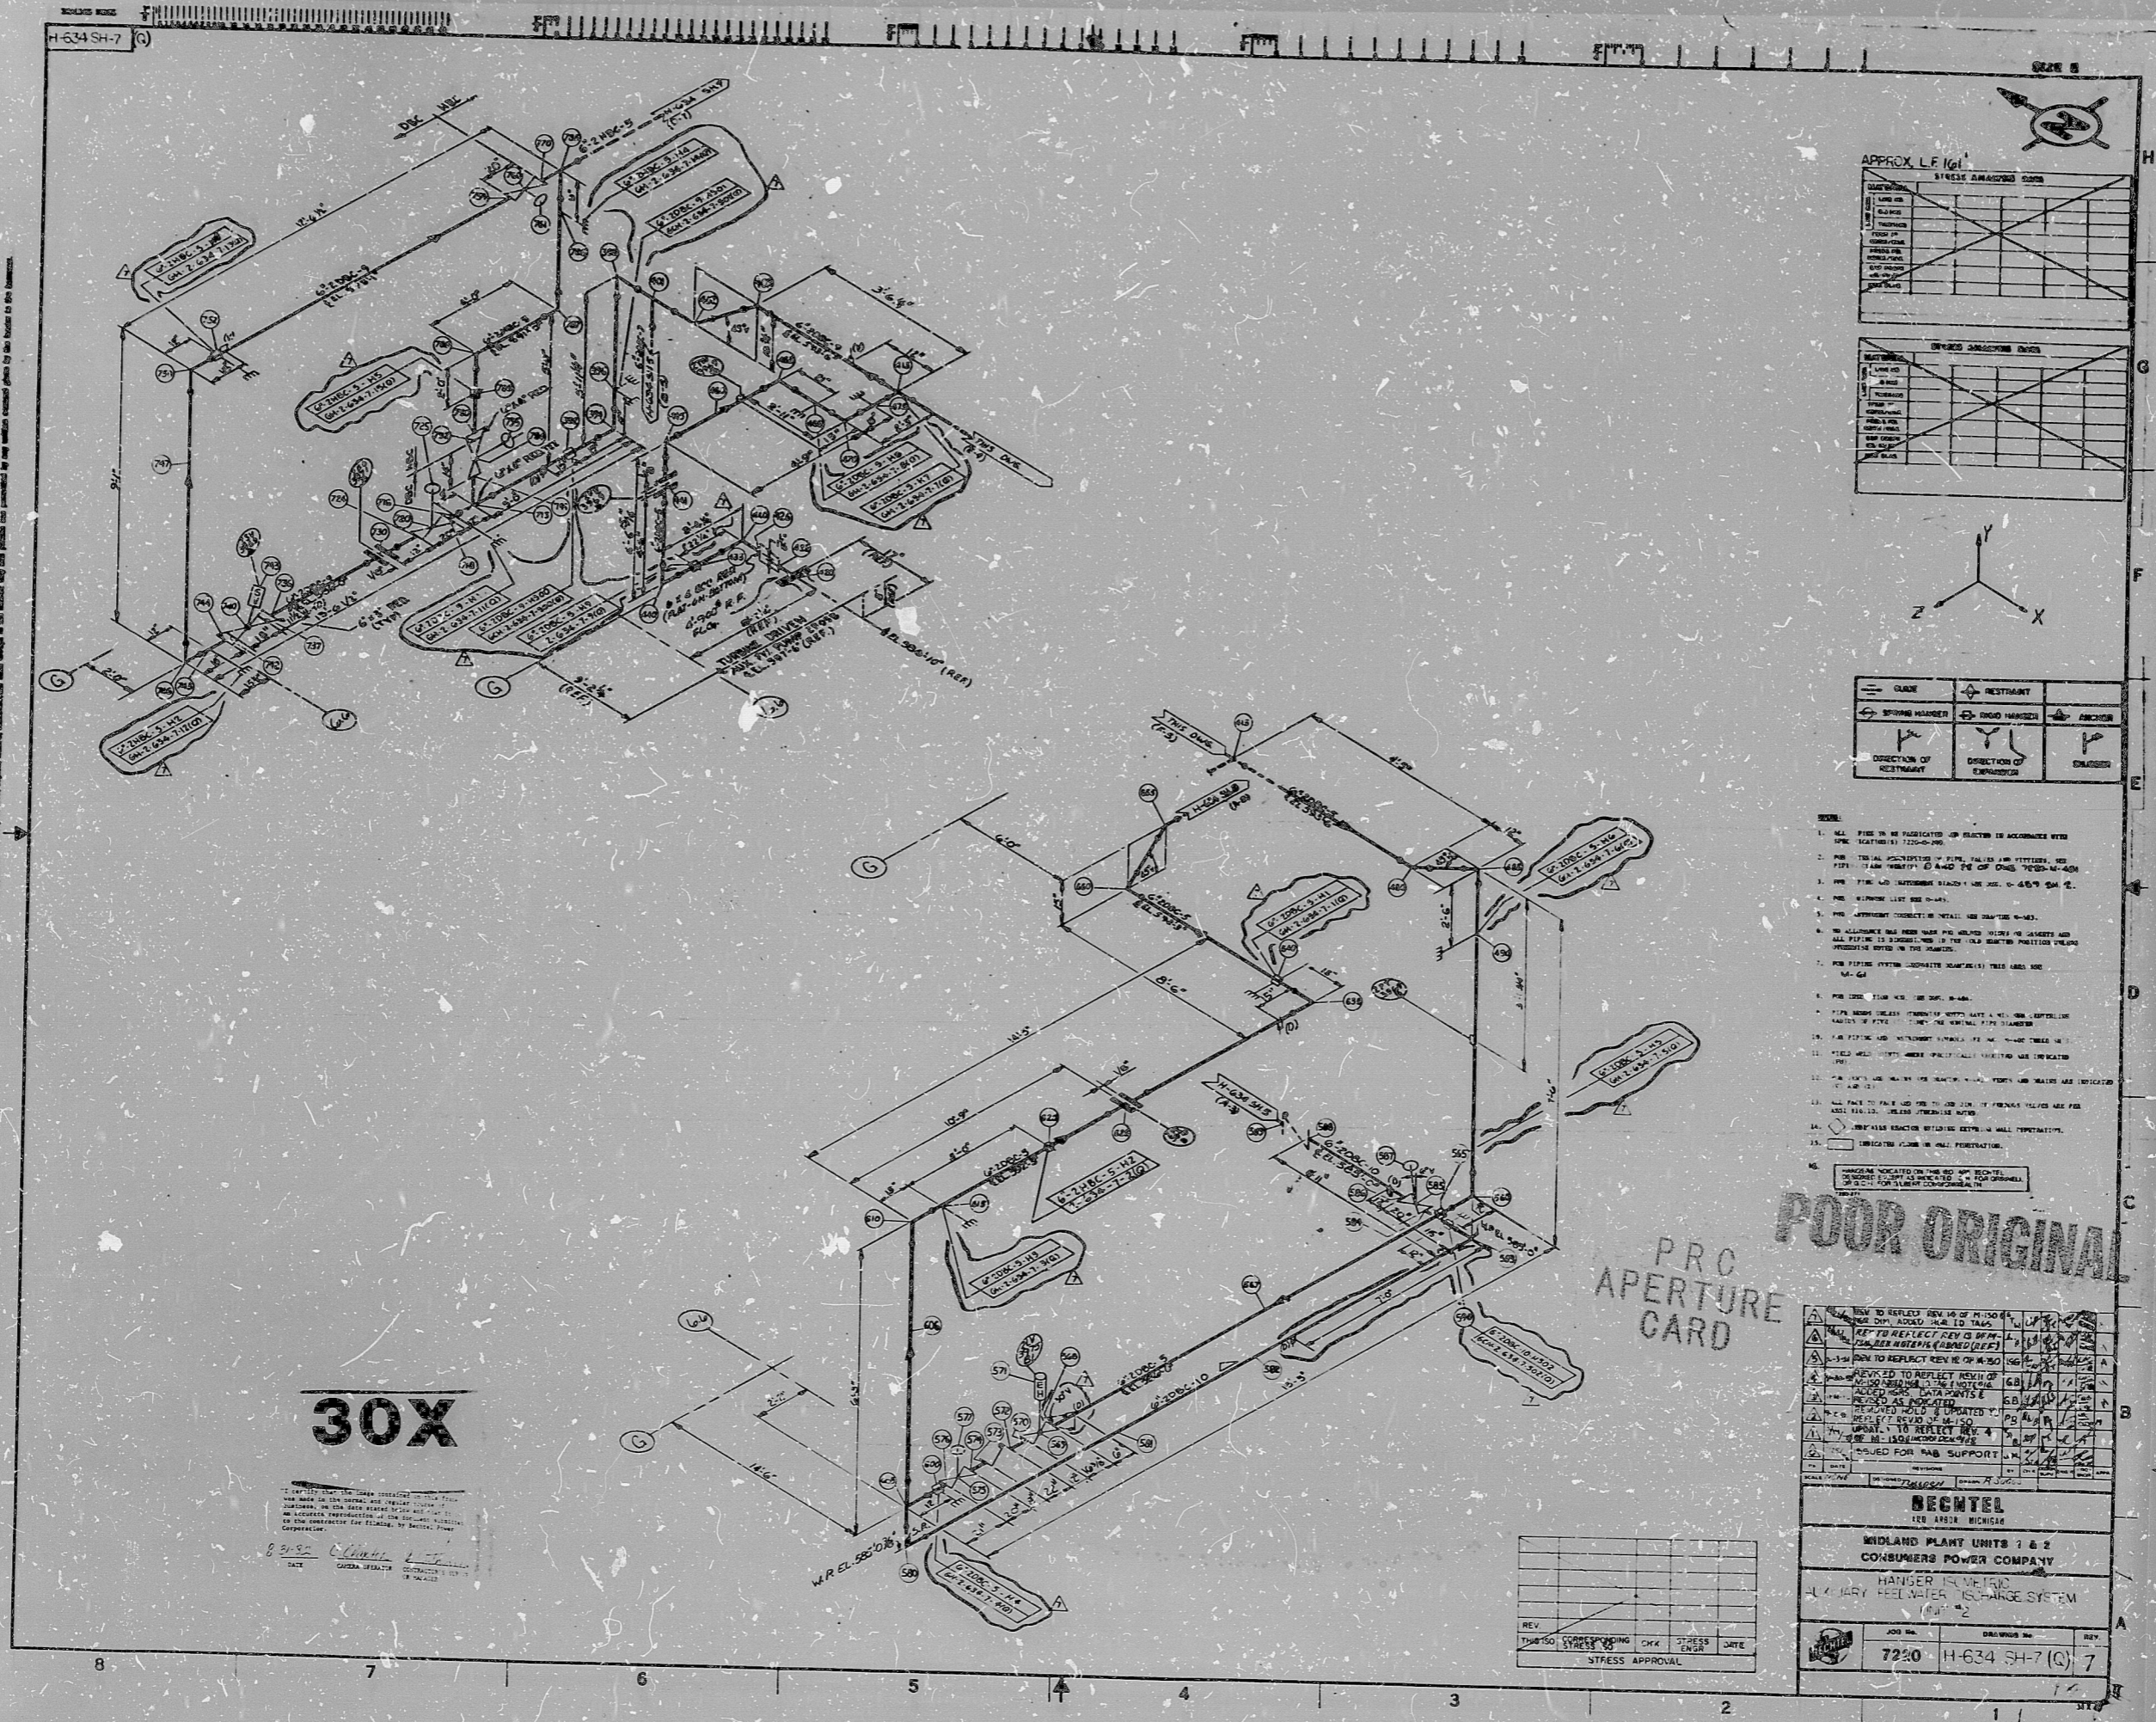

17"

11"

8.5"

8.5"

11"

17"

RIDS

8302160074

