


H-639 SHI (G)

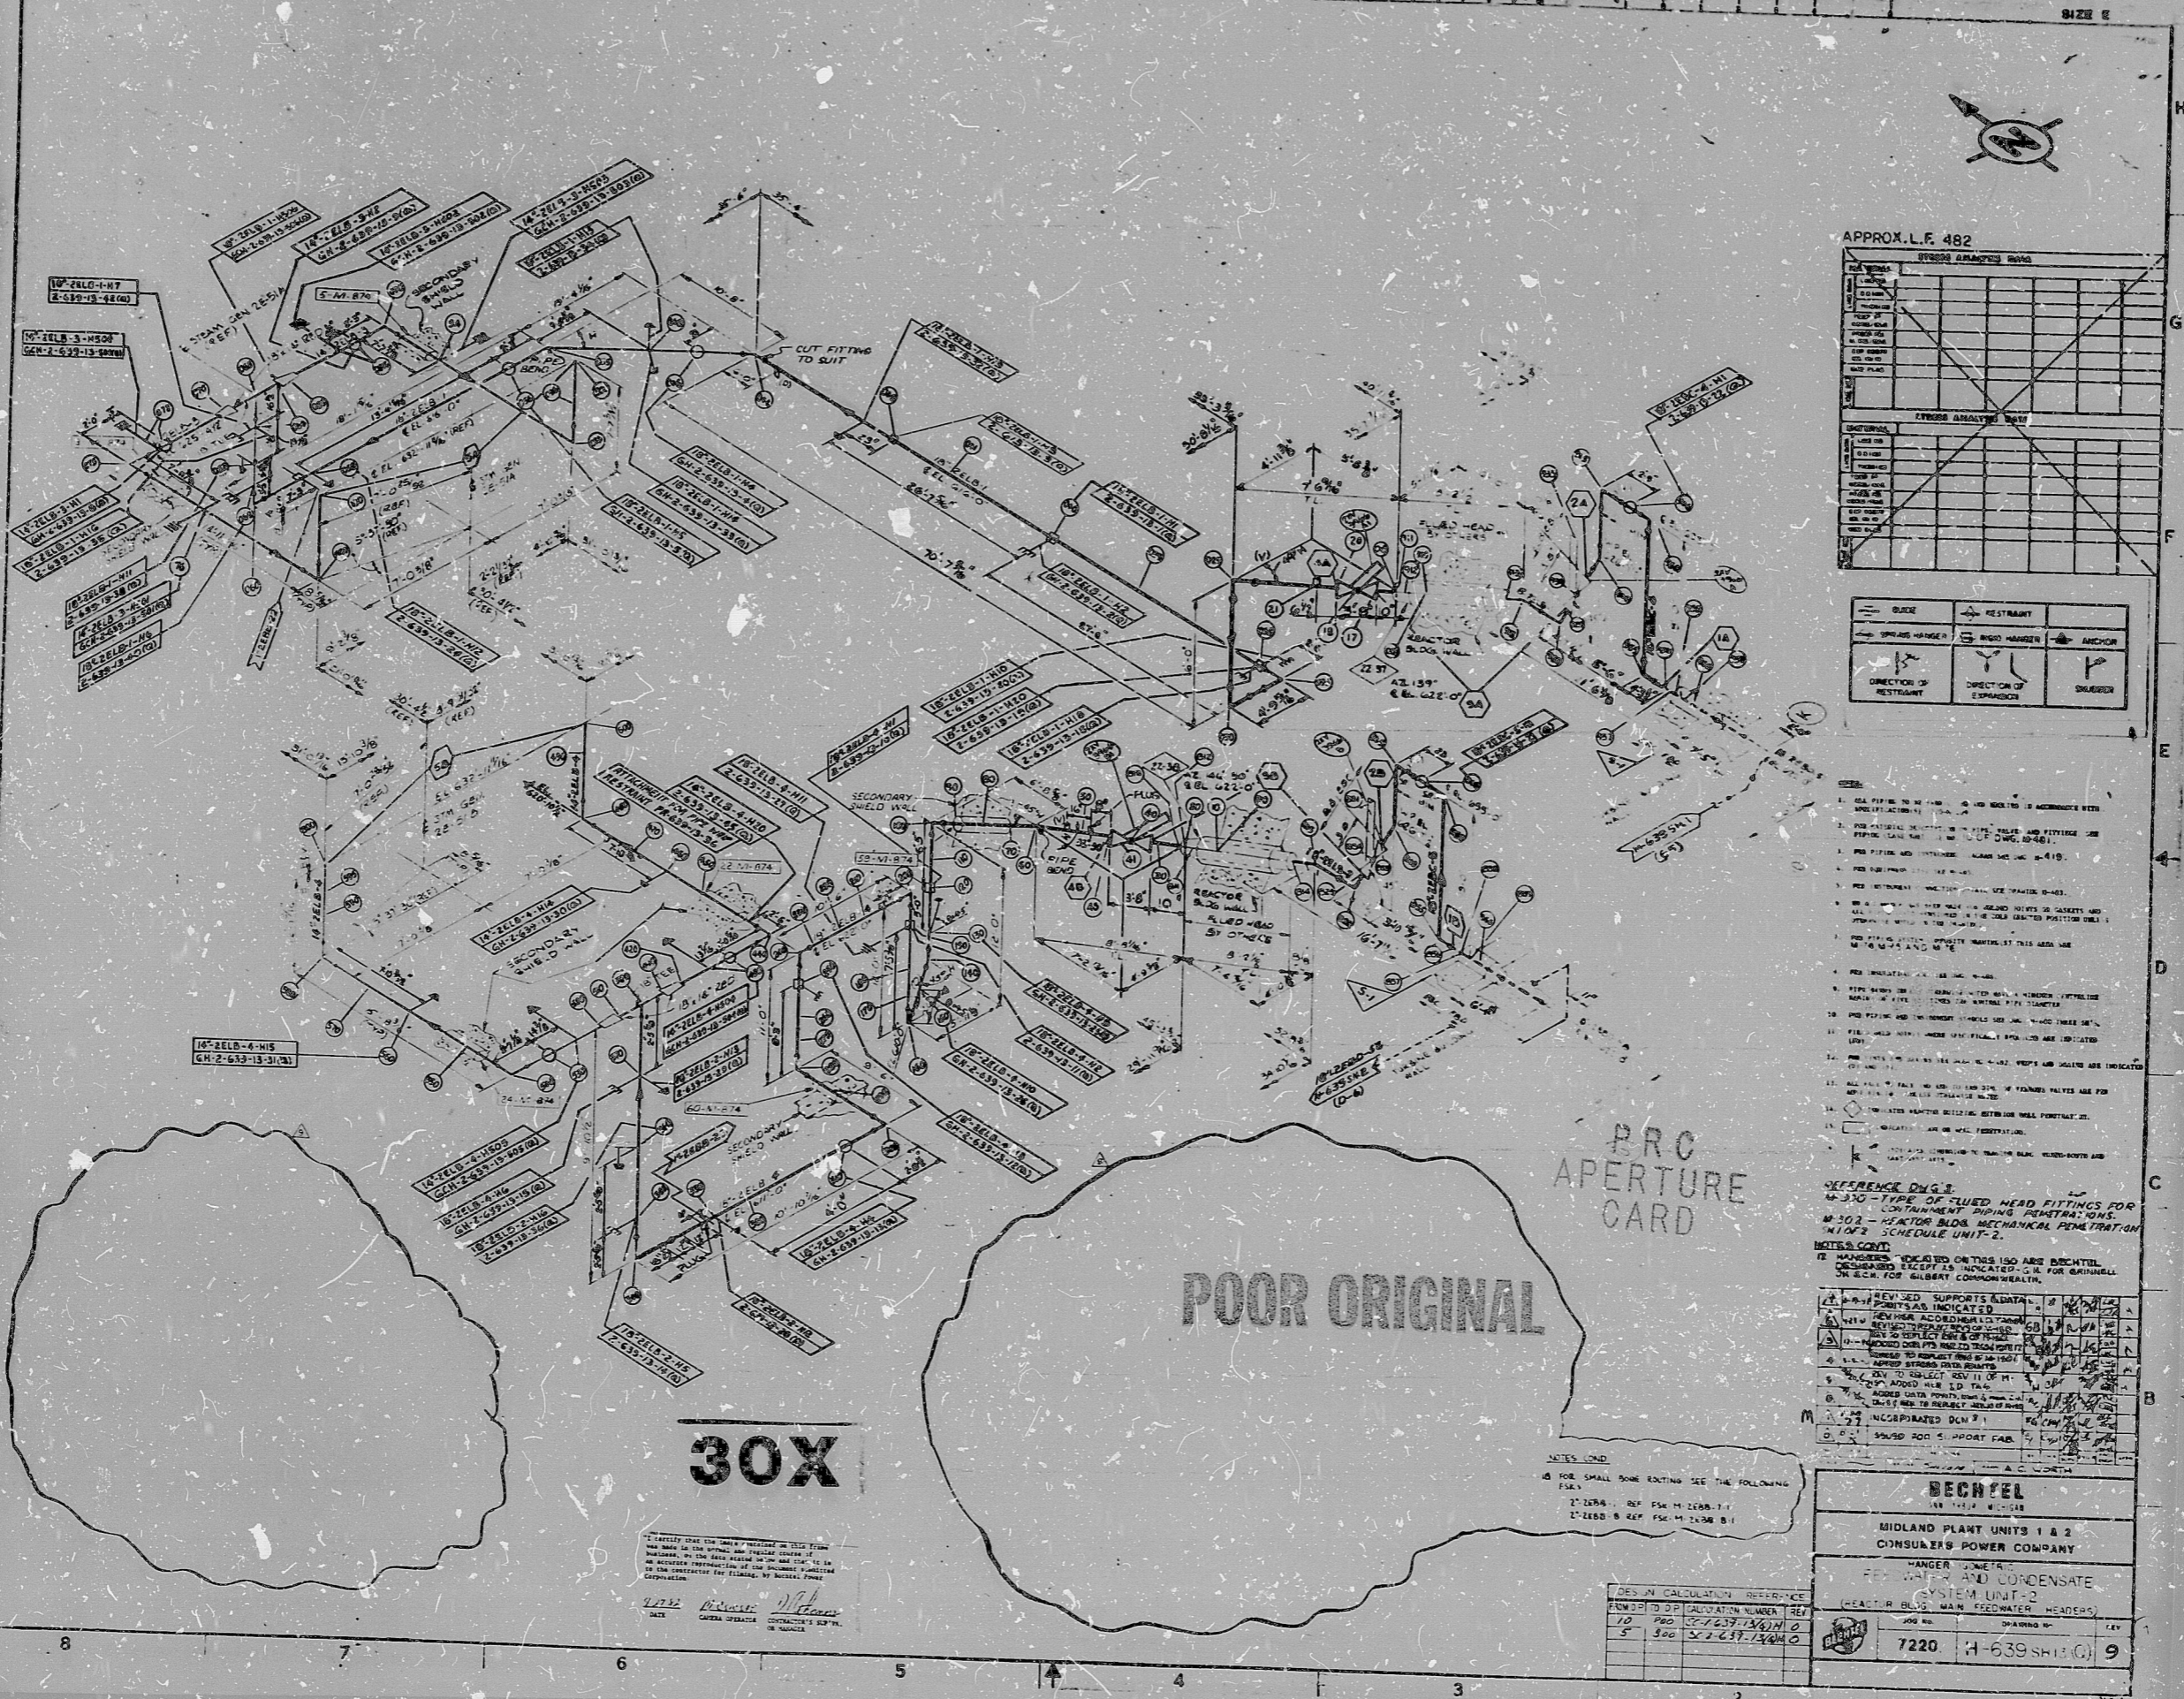

APPROX. L.F. 482





REFERENCE Dwg. 2

BECHTEL
 MIDLAND PLANT UNITS 1 & 2
 7220 H-639 SHI (G) 9



30X



DESIGN CALCULATION REFERENCES


RIDS

8302160087

