
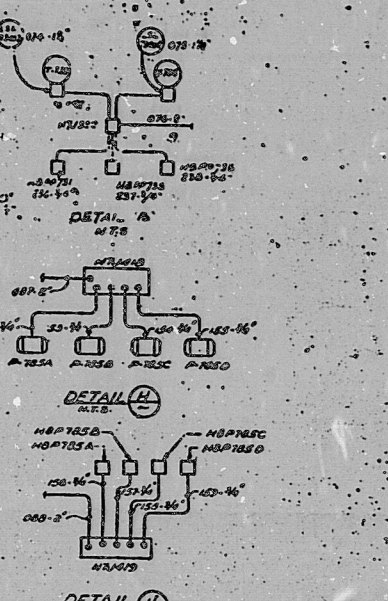
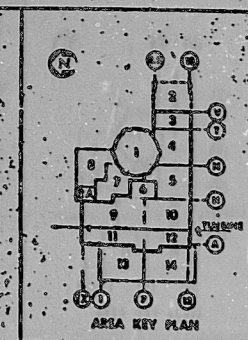


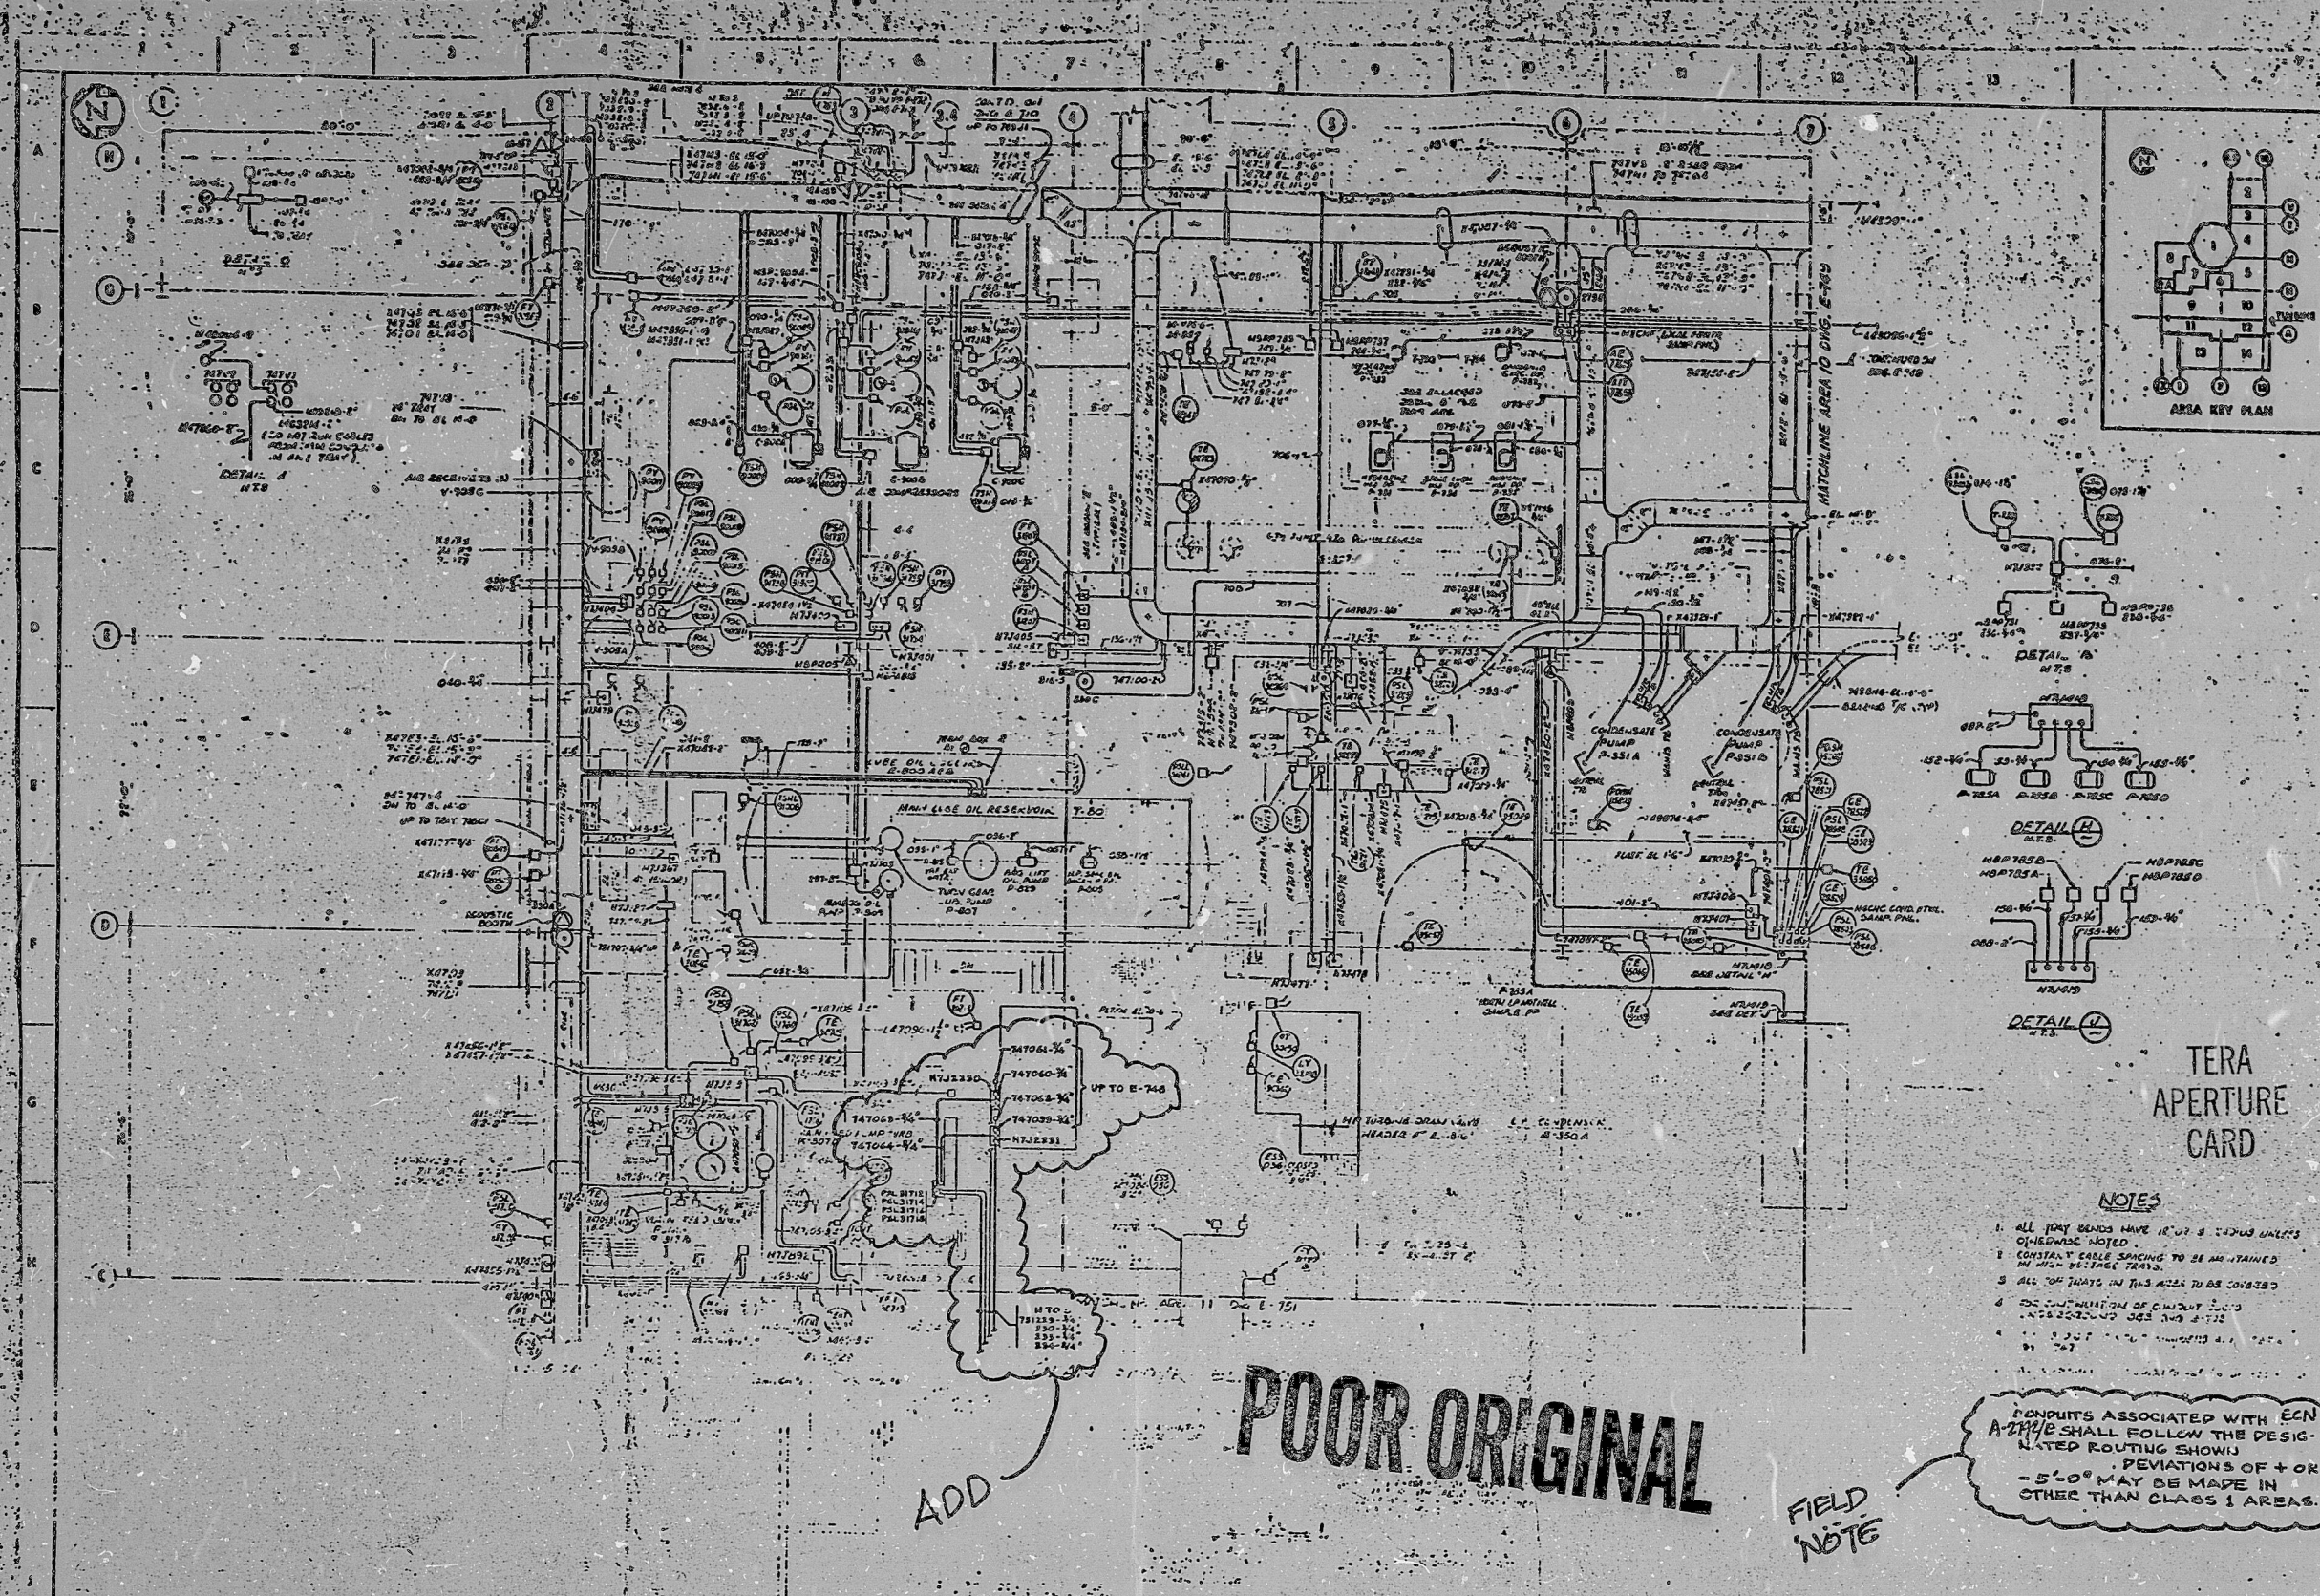

TERA
APERTURE
CARD

- NOTES
1. ALL TAPES HAVE 1/2" X 1/2" UNLESS OTHERWISE NOTED.
 2. CONDUIT CABLE SPACING TO BE MAINTAINED AT ALL TIMES.
 3. ALL TAPES IN THIS AREA TO BE COVERED.
 4. SEE DIMENSIONS OF CONDUIT TRAYS INTERSECTIONS AND JOINTS.
 5. SEE TAPES FOR DIMENSIONS AND JOINTS.

CONDUITS ASSOCIATED WITH ECN A-2742/E SHALL FOLLOW THE DESIGNATED ROUTING SHOWN. DEVIATIONS OF + OR - 5" MAY BE MADE IN OTHER THAN CLASS 1 AREAS.

POOR ORIGINAL

ADD

FIELD
NOTE

checked by VLM 4-4-80

GRAPHIC SCALE

BECHTEL CORPORATION LOS ANGELES	
SACRAMENTO MUNICIPAL UTILITY DISTRICT BANCROFT SEC. NUCLEAR STATION - UNIT 1	
TURBINE BUILDING AREA 9 CONDUIT & TRAY ARRANGEMENT PLAN AT GROUND FLOOR	
DATE 11/15/79	BY E-747

CMUD DRAWING CHANGE NOTICE	ECN No. A-2742/E TASK 575	IS INSP. REQ'D YES ☒ NO ☐	PREPARED BY TASK 575 11/15/79 RES 9/24/80	CHK'D BY 41	DRAWING NUMBER E-747	REVISION 14 ABA915
	FOR ECC USE ONLY DWS. REV. BY. DATE SHEET 1 OF 1					

I CERTIFY THAT THE IMAGE CONTAINED ON THIS FRAME WAS MADE IN THE NORMAL AND REGULAR COURSE OF BUSINESS, ON THE DATE STATED BELOW AND THAT IT IS AN ACCURATE REPRODUCTION OF THE DOCUMENT SUBMITTED TO MICROGRAPHY.

RIDS

8109230123

