




RIDS

8109230196

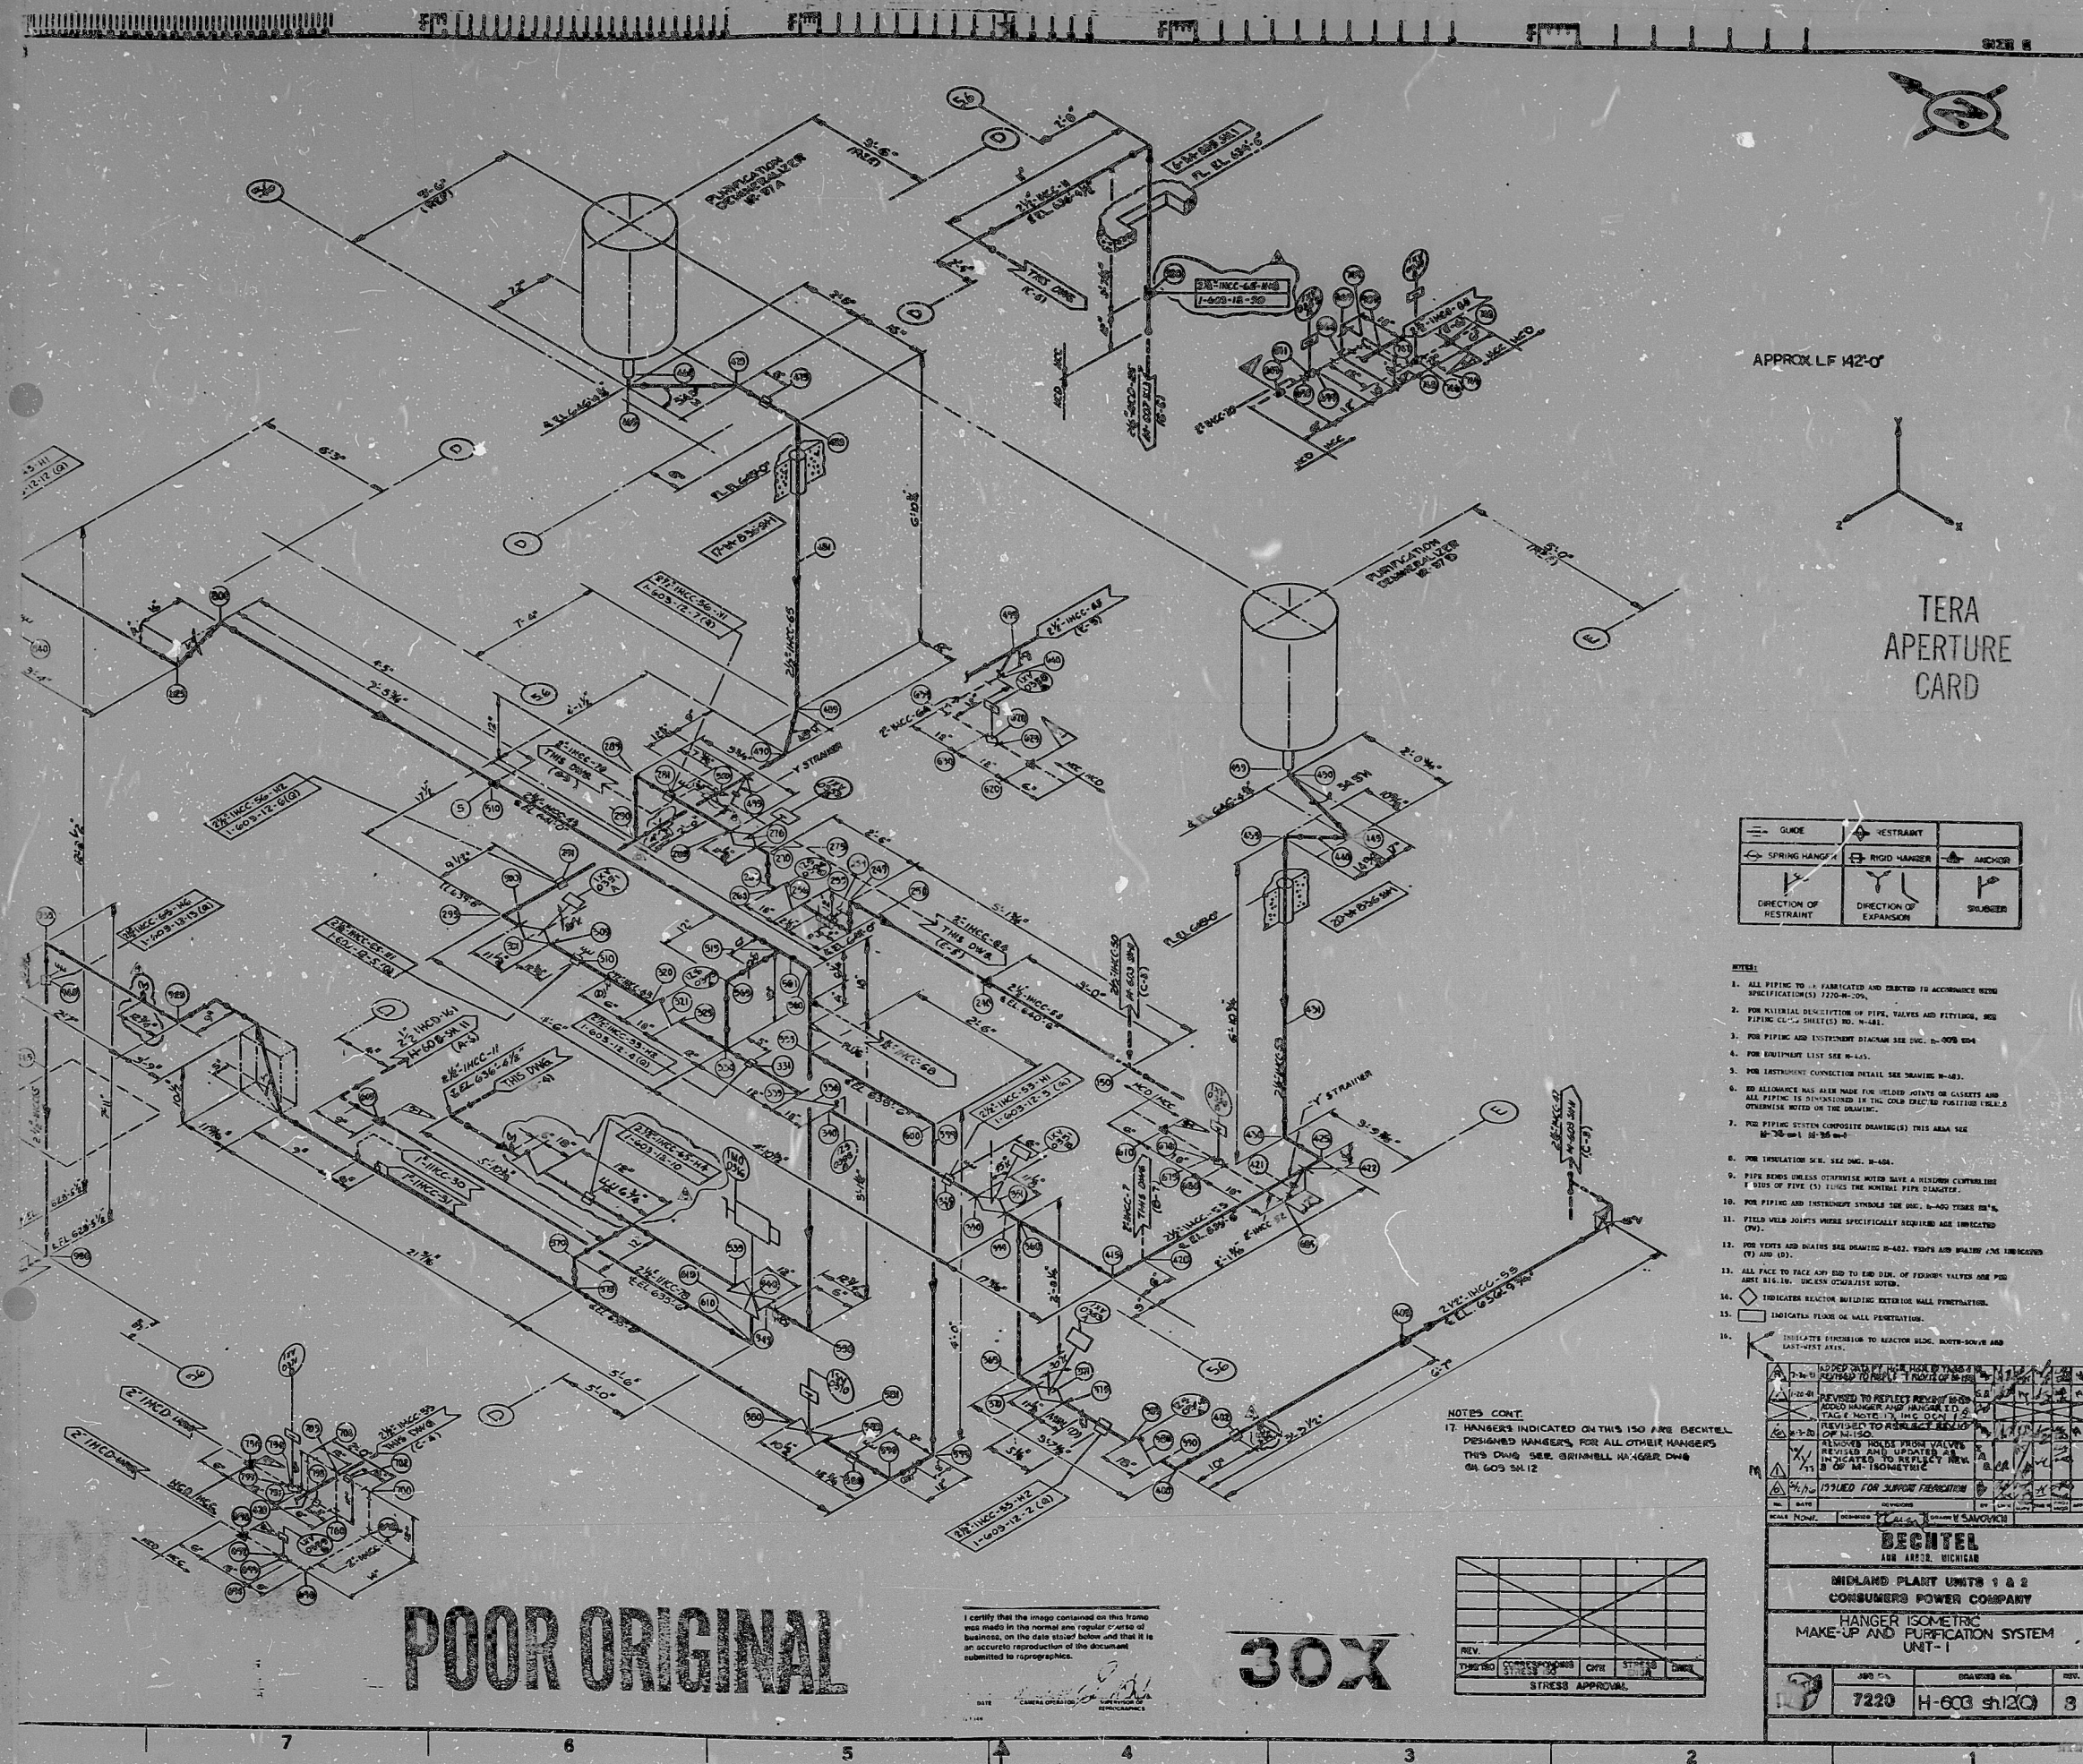