


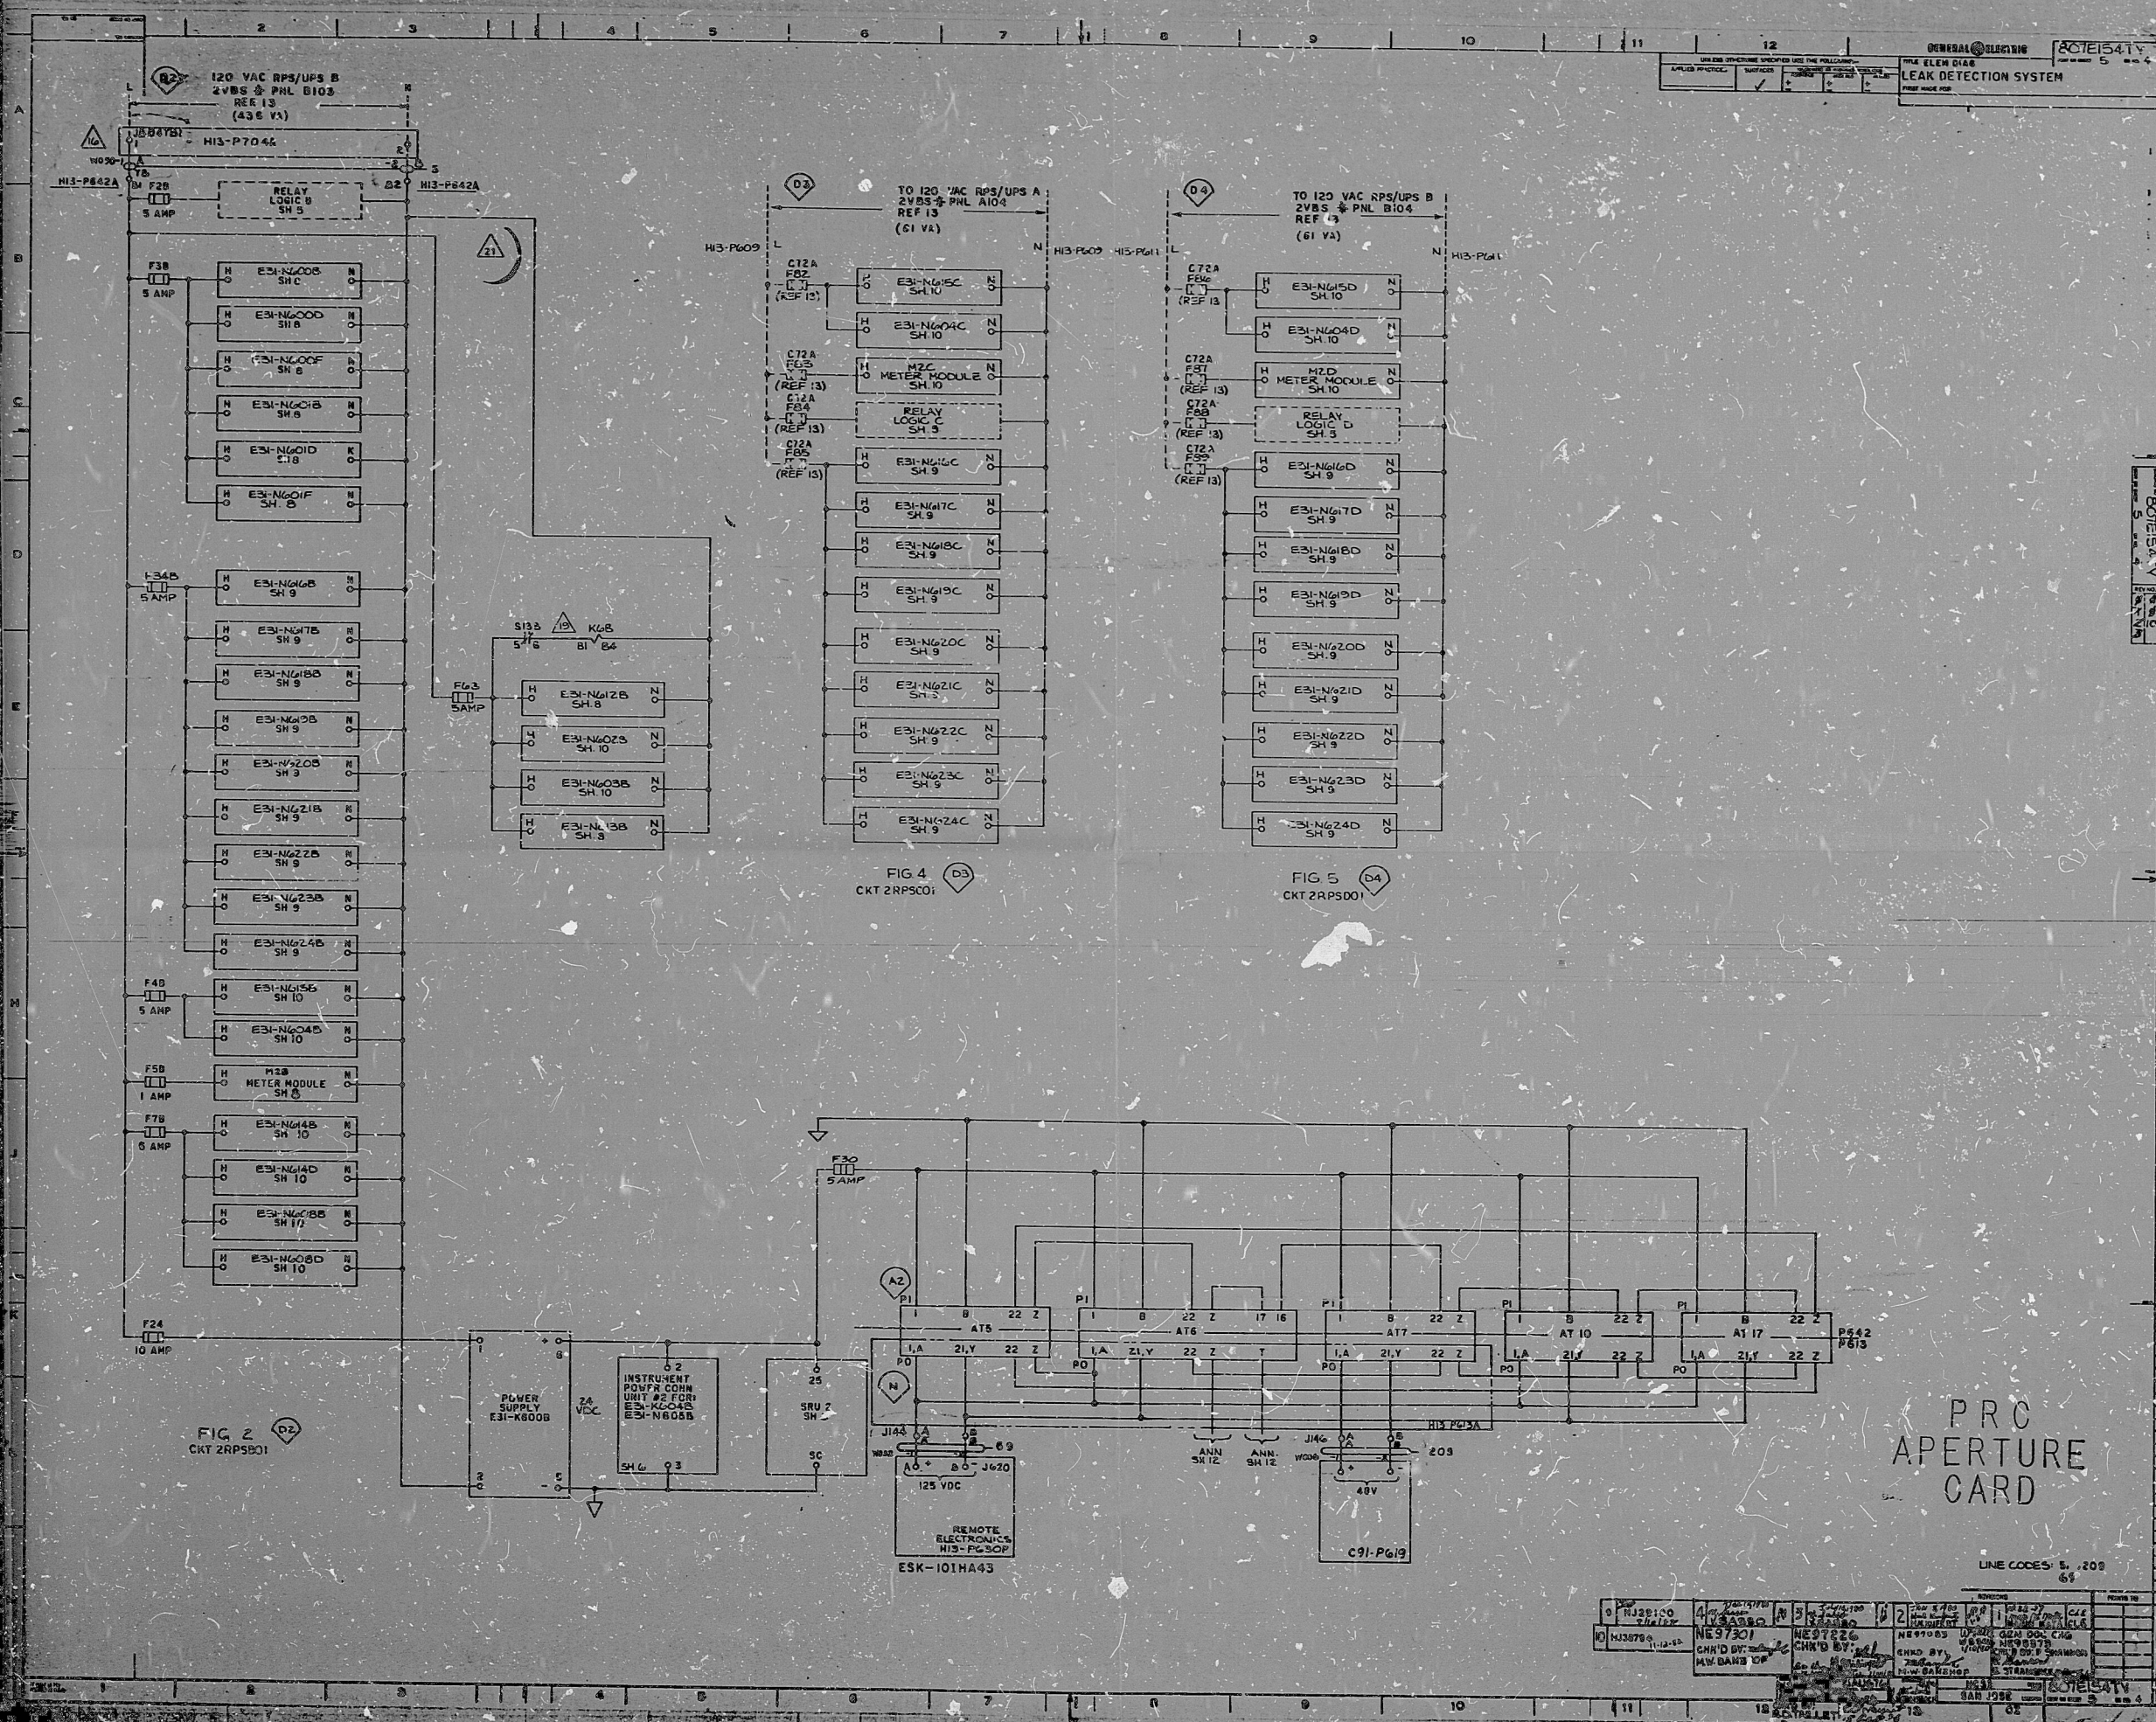

PDR RIDS

8401250346

