


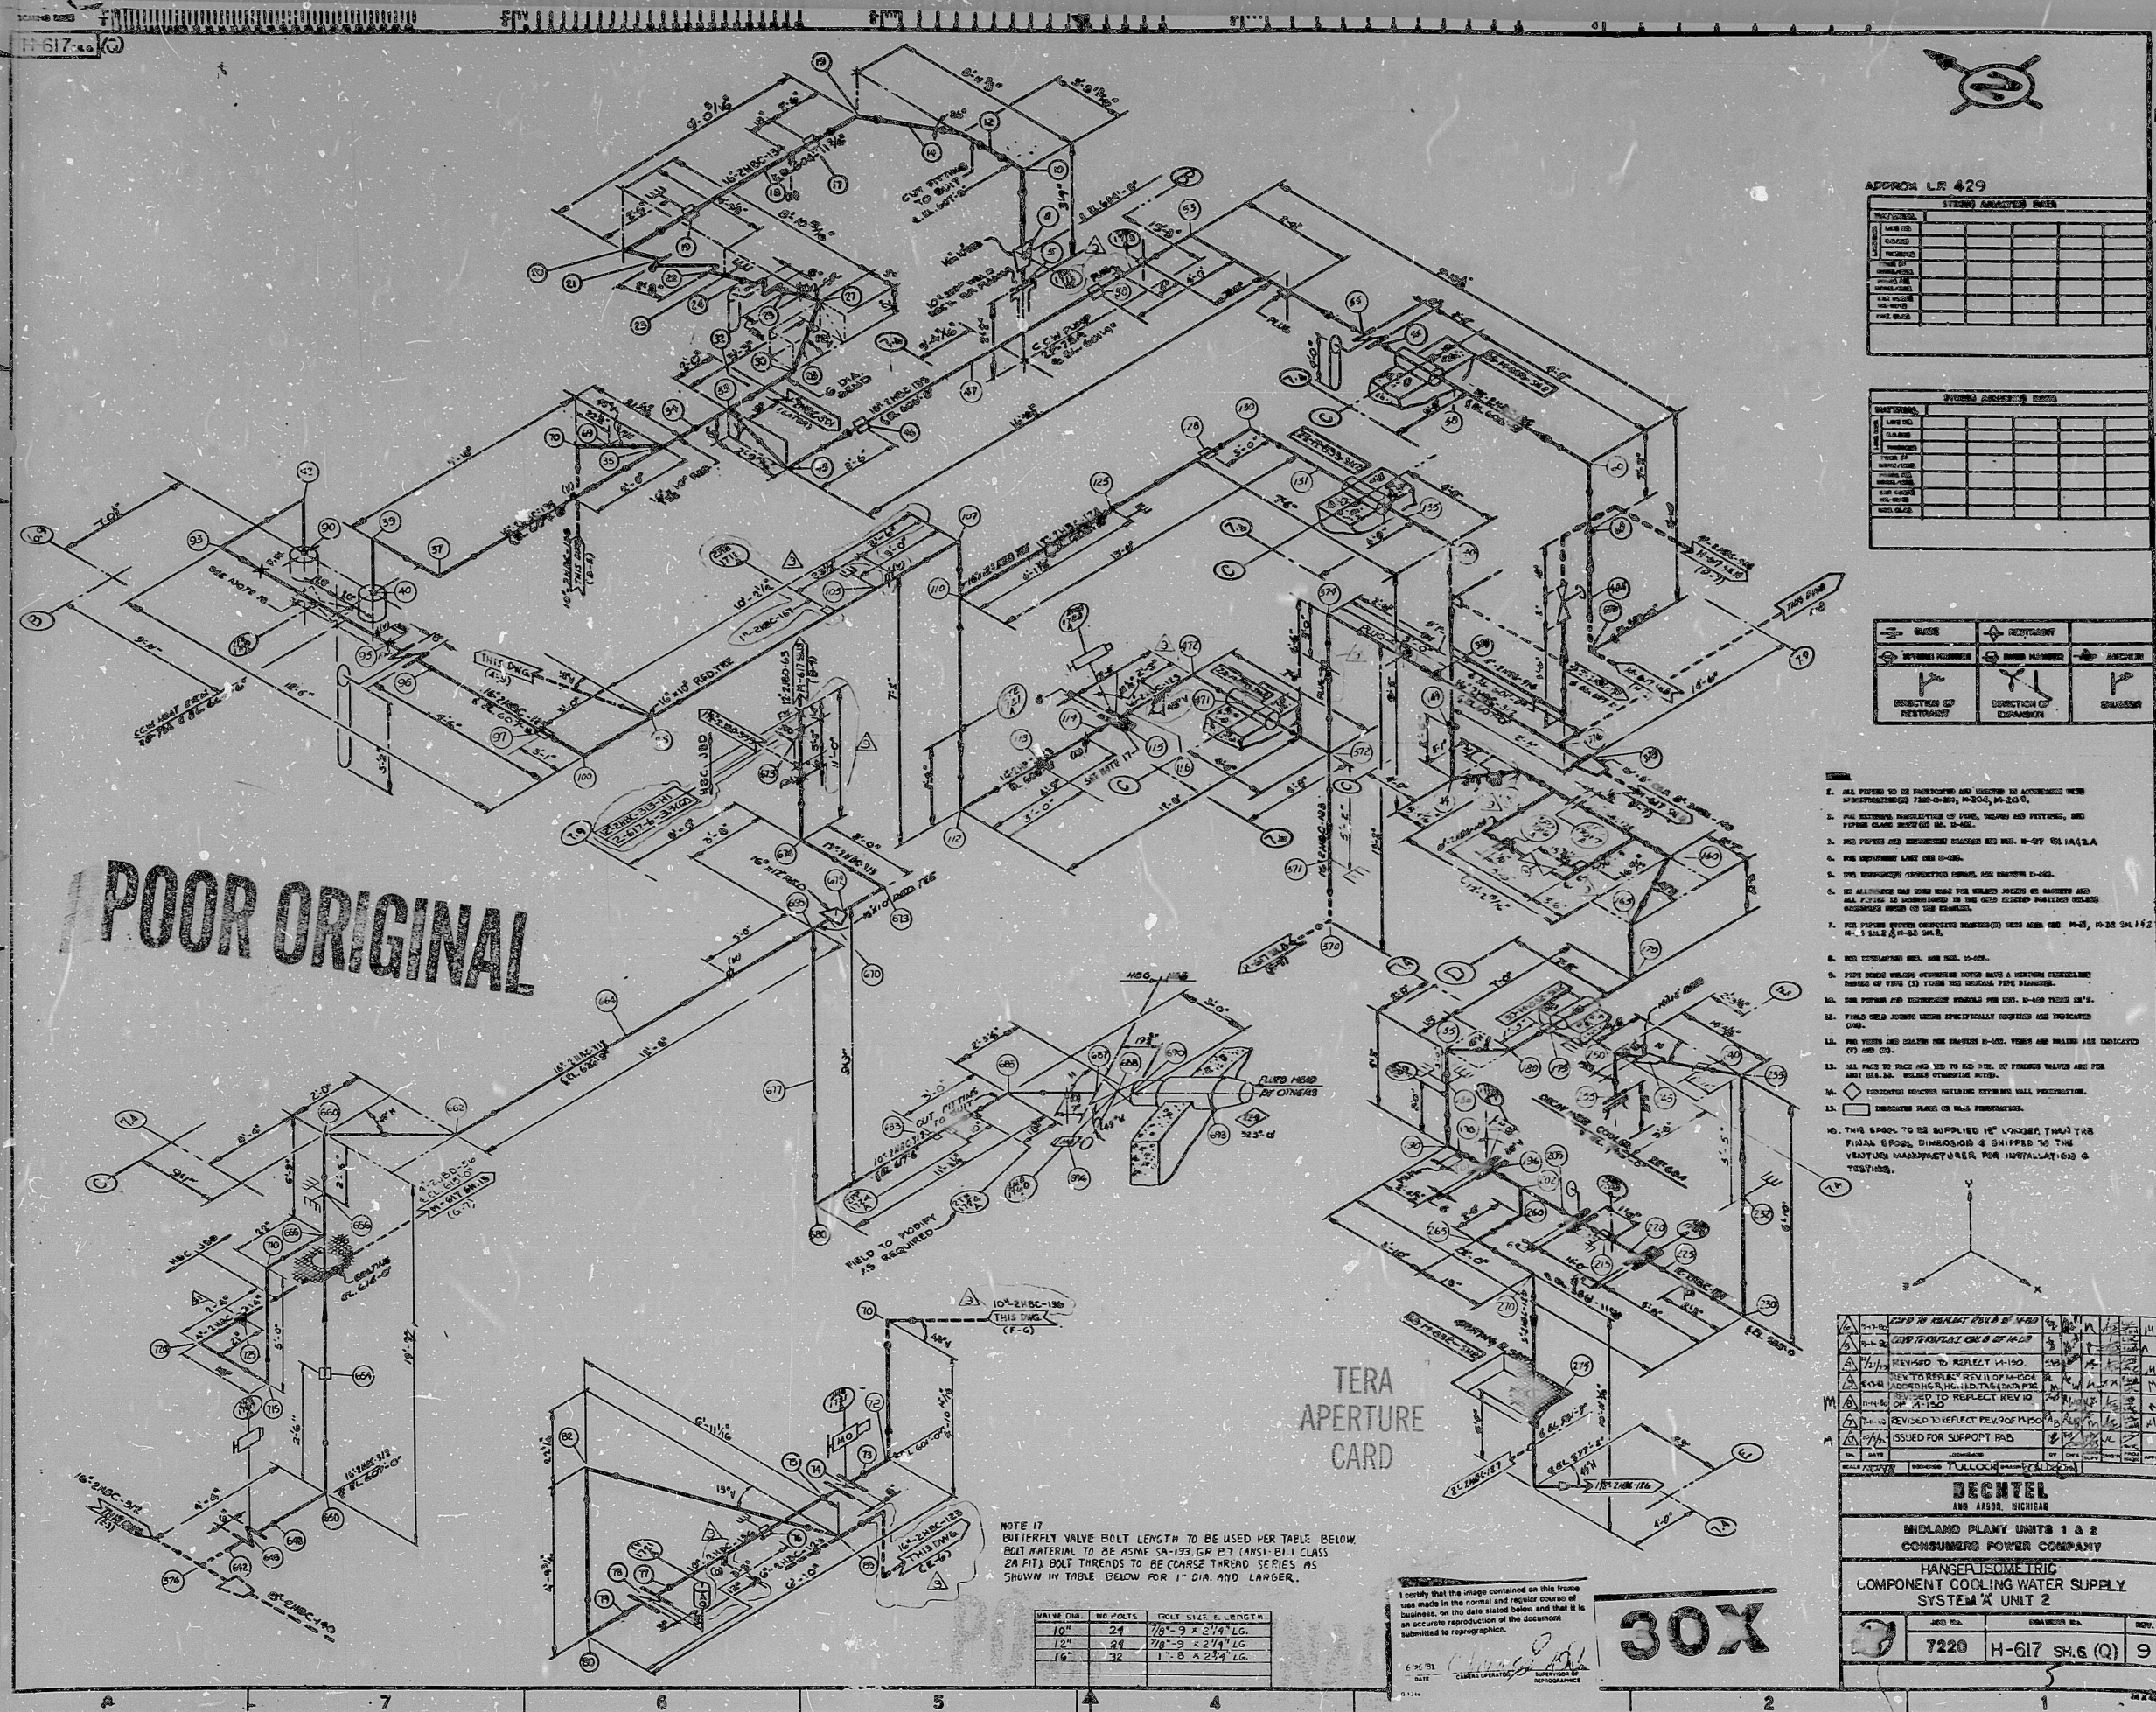

POOR ORIGINAL

TERA
APERTURE
CARD

30X

APPROX LR 429

SYSTEM ANALYSIS DATA	
NAME	
DATE	
DESIGNER	
REVIEWER	
APPROVED	
DATE	

SYSTEM ANALYSIS DATA	
NAME	
DATE	
DESIGNER	
REVIEWER	
APPROVED	
DATE	

DATE	REVISION	APPROVED
SYSTEM NUMBER	REVISION NUMBER	APPROVED
DIRECTION OF RESTRICTION	DIRECTION OF EXPANSION	STATUS

RECHTEL			
MIDLAND PLANT UNIT 1 & 2			
CONSUMERS POWER COMPANY			
HANGER ISOMETRIC			
COMPONENT COOLING WATER SUPPLY			
SYSTEM 'A' UNIT 2			
7220	H-617	SH.6 (Q)	9

VALVE DIA.	NO. BOLTS	BOLT SIZE & LENGTH
10"	24	7/8" - 9 x 2 1/4" LG.
12"	24	7/8" - 9 x 2 1/4" LG.
16"	32	1" - 8 x 2 3/4" LG.

I certify that the image contained on this frame was made in the normal and regular course of business, on the date stated below and that it is an accurate reproduction of the document submitted to me for reproduction.

C. J. [Signature]

RIDS

8109230389

