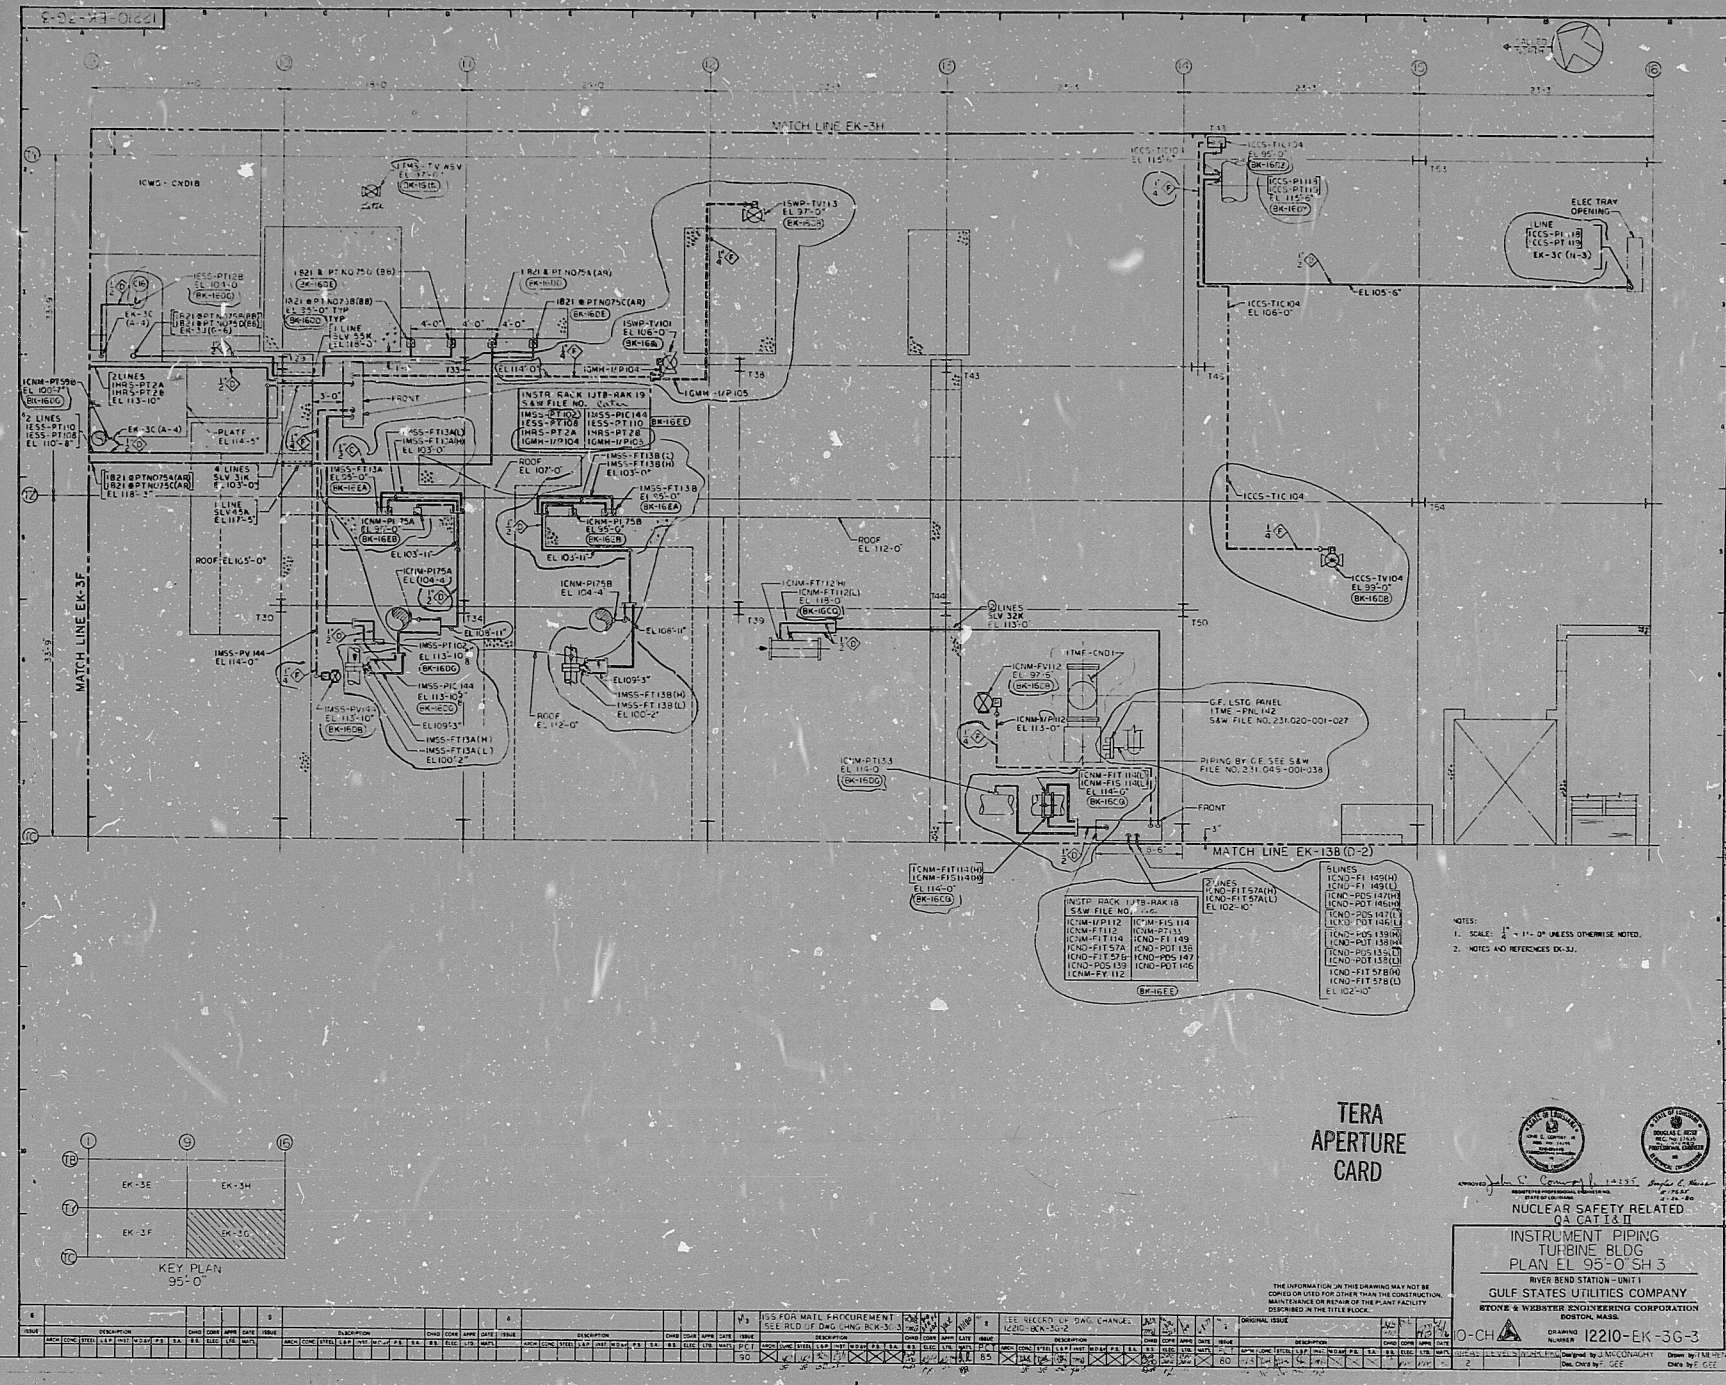


TERA
APERTURE
CARD

NUCLEAR SAFETY RELATED
INSTRUMENT PIPING
TURBINE BLDG
PLAN EL 95'-0" SH 3
RIVER BEND STATION - UNIT 1
GULF STATES UTILITIES COMPANY

12210-EK-3G-3



RIDS

8109230397

