


21

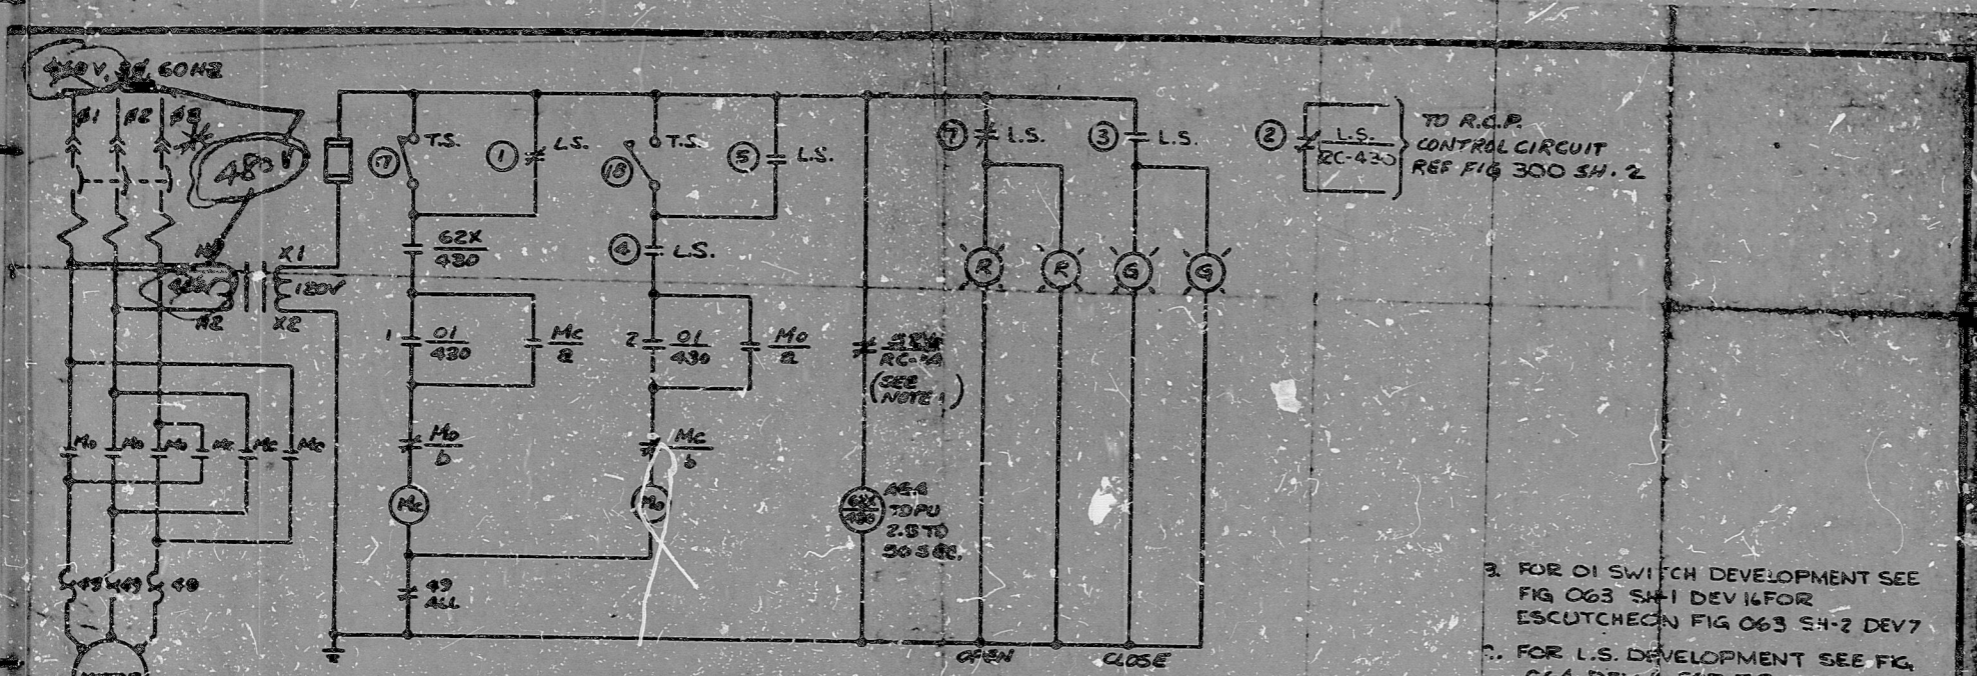

VALVE NO.	DESCRIPTION	CONTROL SW
RC-430	RCP SEAL RETURN ISOLATION	O.I. SW NO. LOC CONTROL ROOM
RC-431		MS-431
RC-432		MS-432
RC-433	RCP SEAL RETURN ISOLATION	MS-433 CONTROL ROOM

APPROVED  
REFERENCE  
DESIGN

- 1. REF FIG 301 SH. 1
- 2. FOR L.S. DEVELOPMENT SEE FIG. 064 DEV 3, FOR T.S. 064 DEV 2
- 3. FOR O.I. SWITCH DEVELOPMENT SEE FIG 063 SH. 1 DEV 16 FOR ESCUTCHEON FIG 063 SH. 2 DEV 7

NOT AN ORIGINAL  
TR-563

REV.	DESCRIPTION	BY & DATE	CHK. & DATE	ENG. APPD.	REV.	DESCRIPTION	PROJ. APPD.	BY & DATE	CHK. & DATE	ENG. APPD.	DRAWN BY: J.B. NUTE / N.S.P.E.R.	DATE	COMP. CODE NO. 14-81-3820	SHEET 1 OF 2
01	REVISES CIRCUITRY; NOTES [CHART] UPGRADED TO APPD REF DES PER REV REC. SYS. 0-1-1	J.B. NUTE / 5/27/77	W.S.P. / 5/27/77								POWER SYSTEMS	5/27/77	85YS80-414-351 01	

WPPSS ENGINEERING GROUP  
MAY 19 1977  
RECEIVED

REV	DATE	BY	APP	DESCRIPTION
				EBASCO REVISION

FOR YOUR REVIEW AND COMMENT  
FILE COPY  
DUE 6-24-77

NOT SEND FROM OFFICE ORIGINAL TO P.R.C. SITE

P.R.C. APERTURE CARD

DESIGN FOR INFO/COMM	DISCIPLINE	ENGINEERING FOR INFO/COMM	
		FOR	NC C
	MECHANICAL		
	CONC-HYD		
	ARCH		
	STRUCT		
	INSTRN		
	CONTROLS		
	PLUMBING		
	HVAC		
	ELECTRICAL		
	WTR TREAT		
	RADWASTE		
	STRESS		
	SHIELDING		
	MATERIALS		
	CONST		
	LICENSING		

3240-931 R 2

WASHINGTON PUBLIC POWER SUPPLY SYSTEM  
WPPSS NUCLEAR PROJECT NO. 3

P.O. CE 2083

REV.	DESCRIPTION	BY	DATE
1	REVISED WITH COMMENTS AS NOTED		
2	NOT APPLICABLE		
3	NO COMMENTS, NO PRINT REQUIRED		
4	FOR INFORMATION ONLY		
5	NO FURTHER REPRODUCIBLE REQUIRED		
6	REVISIT REVISED REPRODUCIBLE		
7	REVISIT REVISED WITH COMMENTS AS NOTED		

DO NOT PROCEED WITH FABRICATION UNLESS REVISED REPRODUCIBLE

PRINT INCLUDED

END MOTOR OPERATED VALVES SH-1

REVIEWED BY: [Signature] DATE: [Date]

DESIGNED BY: [Signature] DATE: [Date]

EBASCO SERVICES INCORPORATED  
AGENT  
2 RECTOR ST., NEW YORK, N.Y. 10008

POOR ORIGINAL

17

RIDS

8392220557

