

11


11

58

8.5

11


17

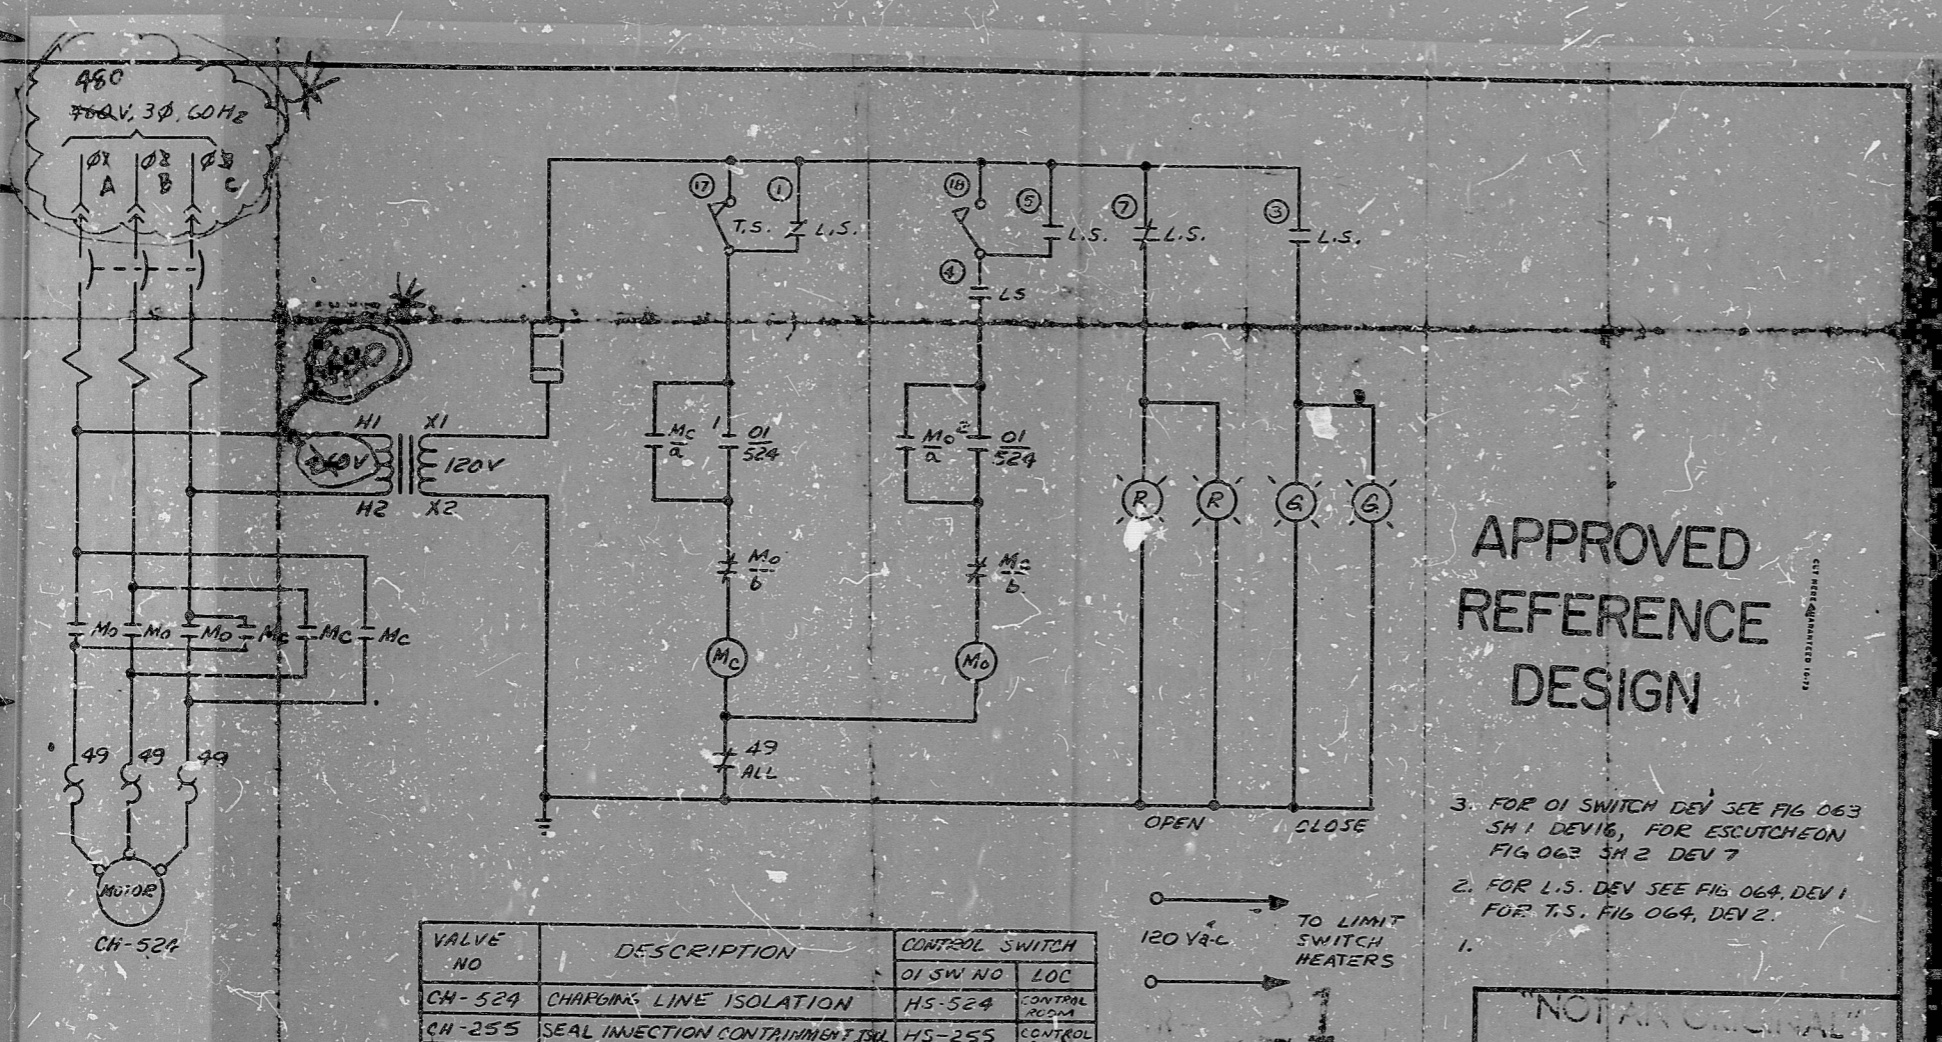

VALVE NO	DESCRIPTION	CONTROL SWITCH	LOC
CH-524	CHARGING LINE ISOLATION	HS-524	CONTROL ROOM
CH-255	SEAL INJECTION CONTAINMENT ISOL	HS-255	CONTROL ROOM

APPROVED REFERENCE DESIGN

- FOR OI SWITCH DEV SEE FIG 063 SH 1 DEV 6, FOR ESCUTCHEON FIG 063 SH 2 DEV 7
- FOR L.S. DEV SEE FIG 064, DEV 1 FOR T.S. FIG 064, DEV 2.

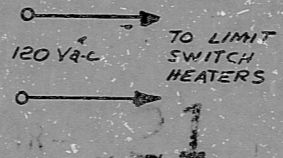

FILE COPY
DO NOT
ORIGINAL

WPPSS-EMDRAC GROUP
APR 25 1977
RECEIVED

REV	DATE	BY	APP	DESCRIPTION
1	1/19/77	PA	W	FOR COMMENTS RE: HOUSE-SEE LETTER CE-82-77-484 PREVIOUS REVISIONS A2, B5
				EBASCO REVISION

APPROPRIATE REVIEW AND COMMENT CARD DUE 7-26-77

POOR ORIGINAL

DESIGN FOR	DISCIPLINE	ENGINEERING FOR
✓	MECHANICAL	✓
	CONC HYD	
	ARCH	
	STRUCT	
	INST R N	✓
✓	CONTROLS	✓
	PLUMBING	
	HVAC	
	ELECTRICAL	
	WTR TREAT	
	RADWASTE	
	STRESS	
	SHIELDING	
	MATERIALS	
	CONST	✓
	LICENSING	
	AGS	
	STANDARD DISTRIBUTION	

3240 935 R 2 1/19/80

WASHINGTON PUBLIC POWER SUPPLY SYSTEM
WPPSS NUCLEAR PROJECT NO. 3

P.O.	CE 2083	ITEM
		REVIEWED WITHOUT COMMENTS
		REVIEWED WITH COMMENTS AS NOTED
		NOT APPLICABLE
		NO COMMENTS, NO PRINT RETURNED
		FOR INFORMATION ONLY
		NO FURTHER REPRODUCIBLE REQUIRED
		RESUBMIT REVISED IF CHECKED HERE
		RESUBMIT CLOTH OR MILLAR REPRODUCIBLE AS SHIPPED
		DO NOT PROCEED WITH FABRICATION RESUBMIT REVISED REPRODUCIBLE
		PRINT INCLUDED
		NOTE
		EWD MOTOR OPERATED VALVES SH3
		REVIEWED BY: JAM/uc DATE: 8/9/77 ORIG. DIV: M DAYS TO COMMENT: 1
		REVIEW OF THIS DOCUMENT WITH OR WITHOUT COMMENTS IS ONLY FOR GENERAL COMPLIANCE WITH THE CHECKED APPROVED SPECIFICATIONS AND FOR CONFIRMATION OF PHYSICAL INTERPRETATION OF TERMS BY CONSTRUCTION PERSONNEL. SUCH REVIEW SHALL IN NO WAY BE CONSIDERED AN ENDORSEMENT OF THE MATERIAL PERFORMANCE OF EQUIPMENT AND MATERIALS AND ALL OTHER LIABILITIES UNDER THE CONTRACT.
		EBASCO SERVICES, INCORPORATED 2 SECTOR ST., SEA HOLE, N.Y. 10006


DRAWN BY: MULCOHY
CHECKER:
APPROVALS:
POWER SYSTEMS
NUCLEAR POWER SYSTEMS

COMP. CODE NO. 16-84-3580
B-5980-714-352 01
SHEET 3 OF 4 REV

RIDS

8302220561

