


17"

17"

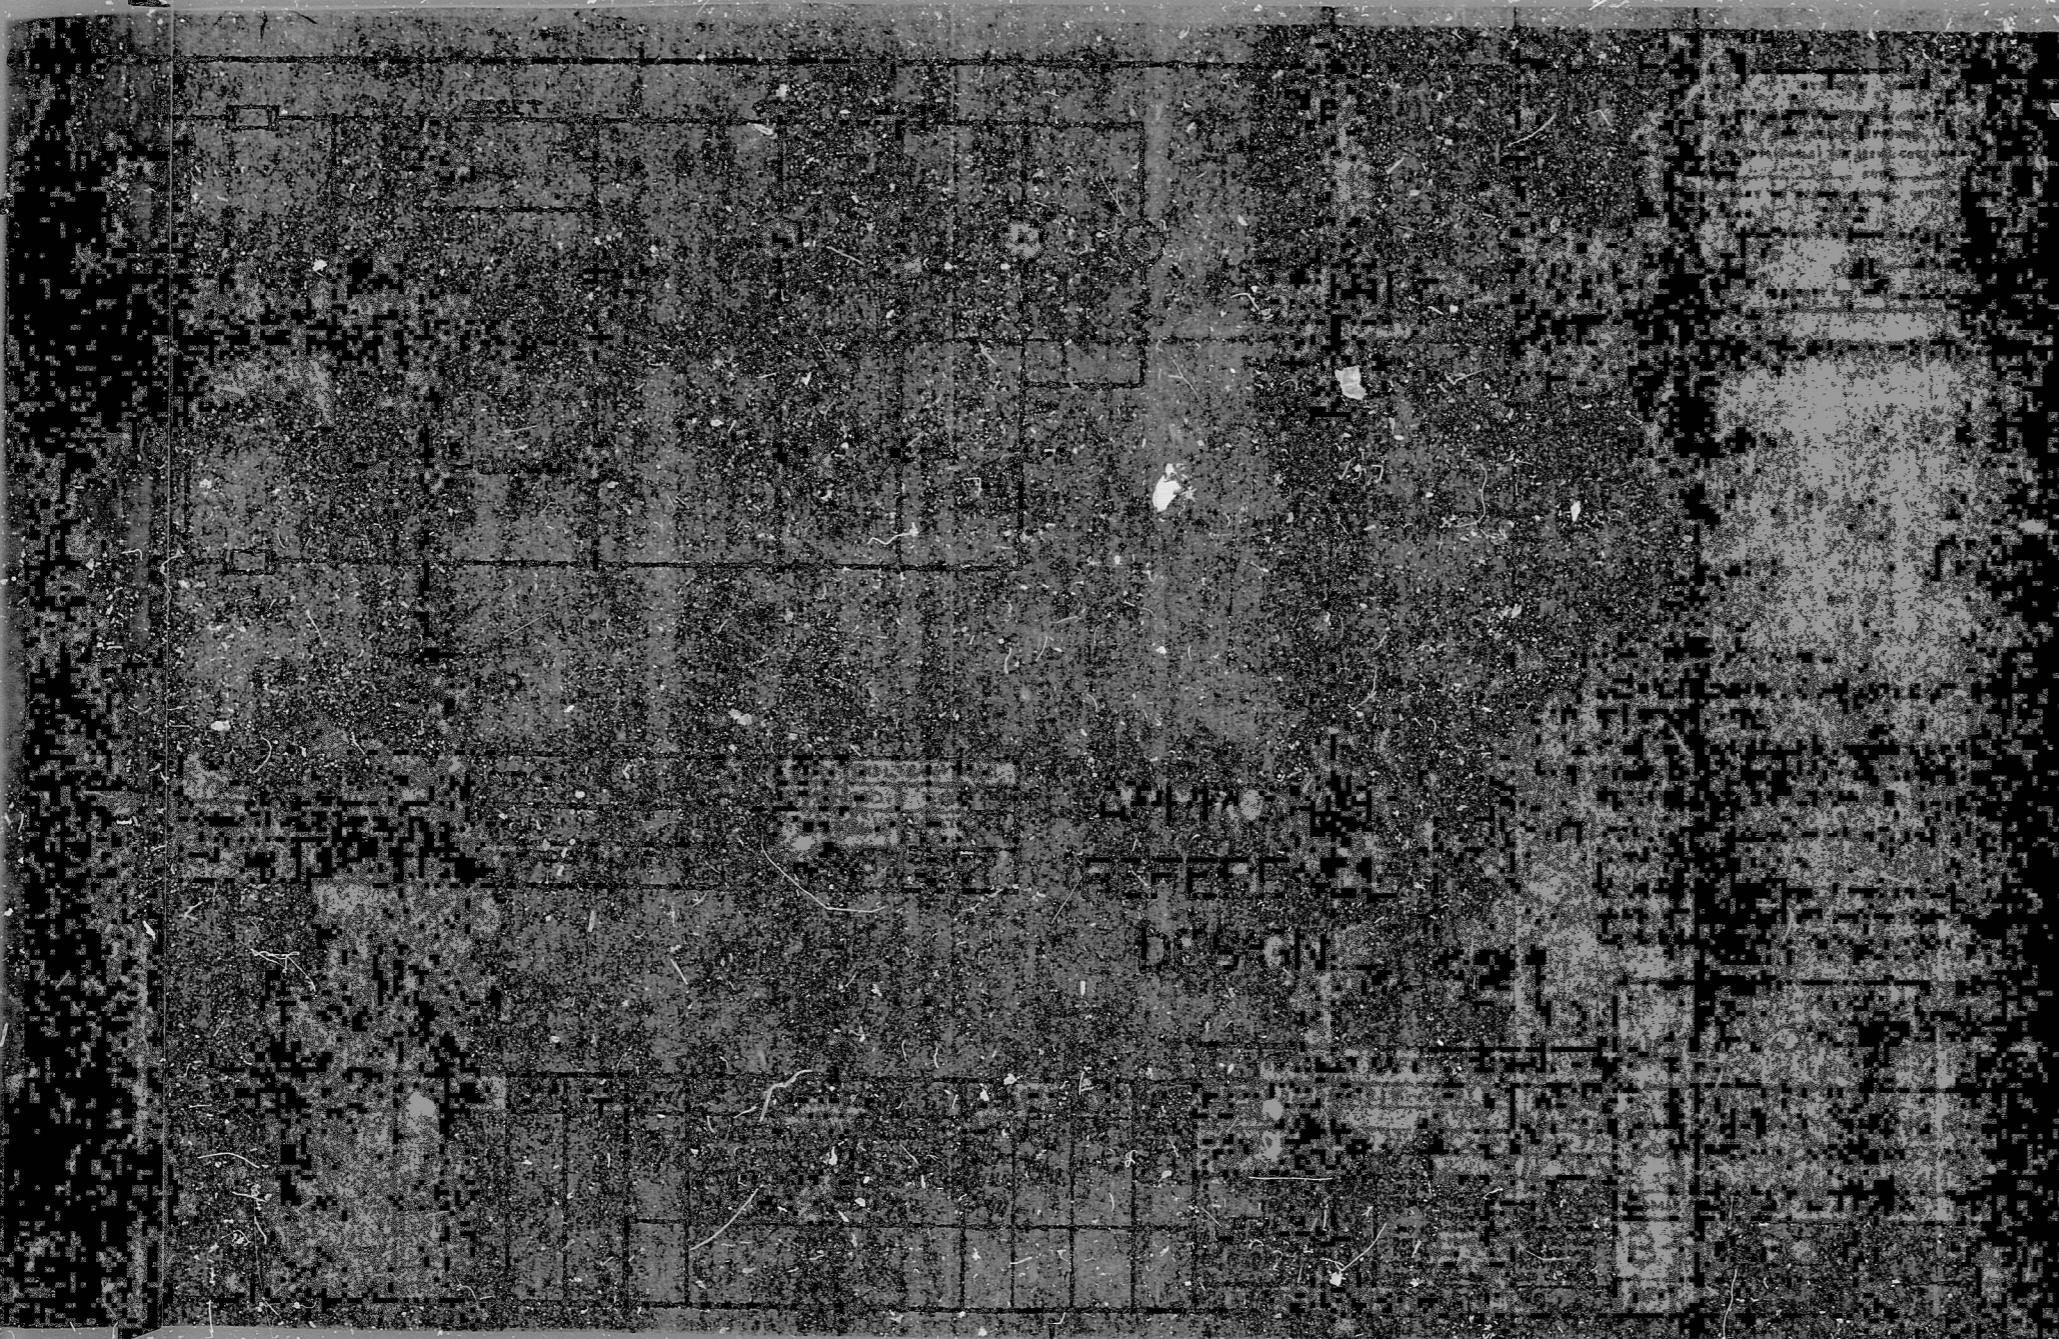

PRO APERTURE CARD

POOR ORIGINAL

WPPSS-EMBRAG GROUP
 APR 26 1977
 RECEIVED

FOR YOUR REVIEW ONLY
 DUE 7-26-77

FILE COPY

SEND FROM OFFICE

SENT TO CLIENT

| DESIGN FOR | DISCIPLINE | REVISIONS FOR |
|------------|------------|---------------|
| ISO CORR | MECHANICAL | |
| | CALC-HYD | |
| | ARCH | |
| | STRUC | |
| | MECH | |
| | PLUMBING | |
| | ELECTRICAL | |
| | PIPE TREAT | |
| | ROCKWELL | |
| | STEEL | |
| | CONCRETE | |
| | PAINTING | |
| | CONCRETE | |
| | LICENSING | |

2240 941 (R)

DESIGNER'S PUBLIC PRINT
 SUPPLY SYSTEM
 WPPSS NUCLEAR PROJECT, U.S.

DATE: 4-26-77

NO NOT REPRODUCED WITHOUT
 PERMISSION OF THE COMPANY

WPPSS

DESIGN SERVICES CORPORATION
 140 WEST 57th STREET
 NEW YORK, N.Y. 10019

17"

17"

11

9'8

8.5"

11"

RIDS

8302220599

