

17


17

11

11

9

9

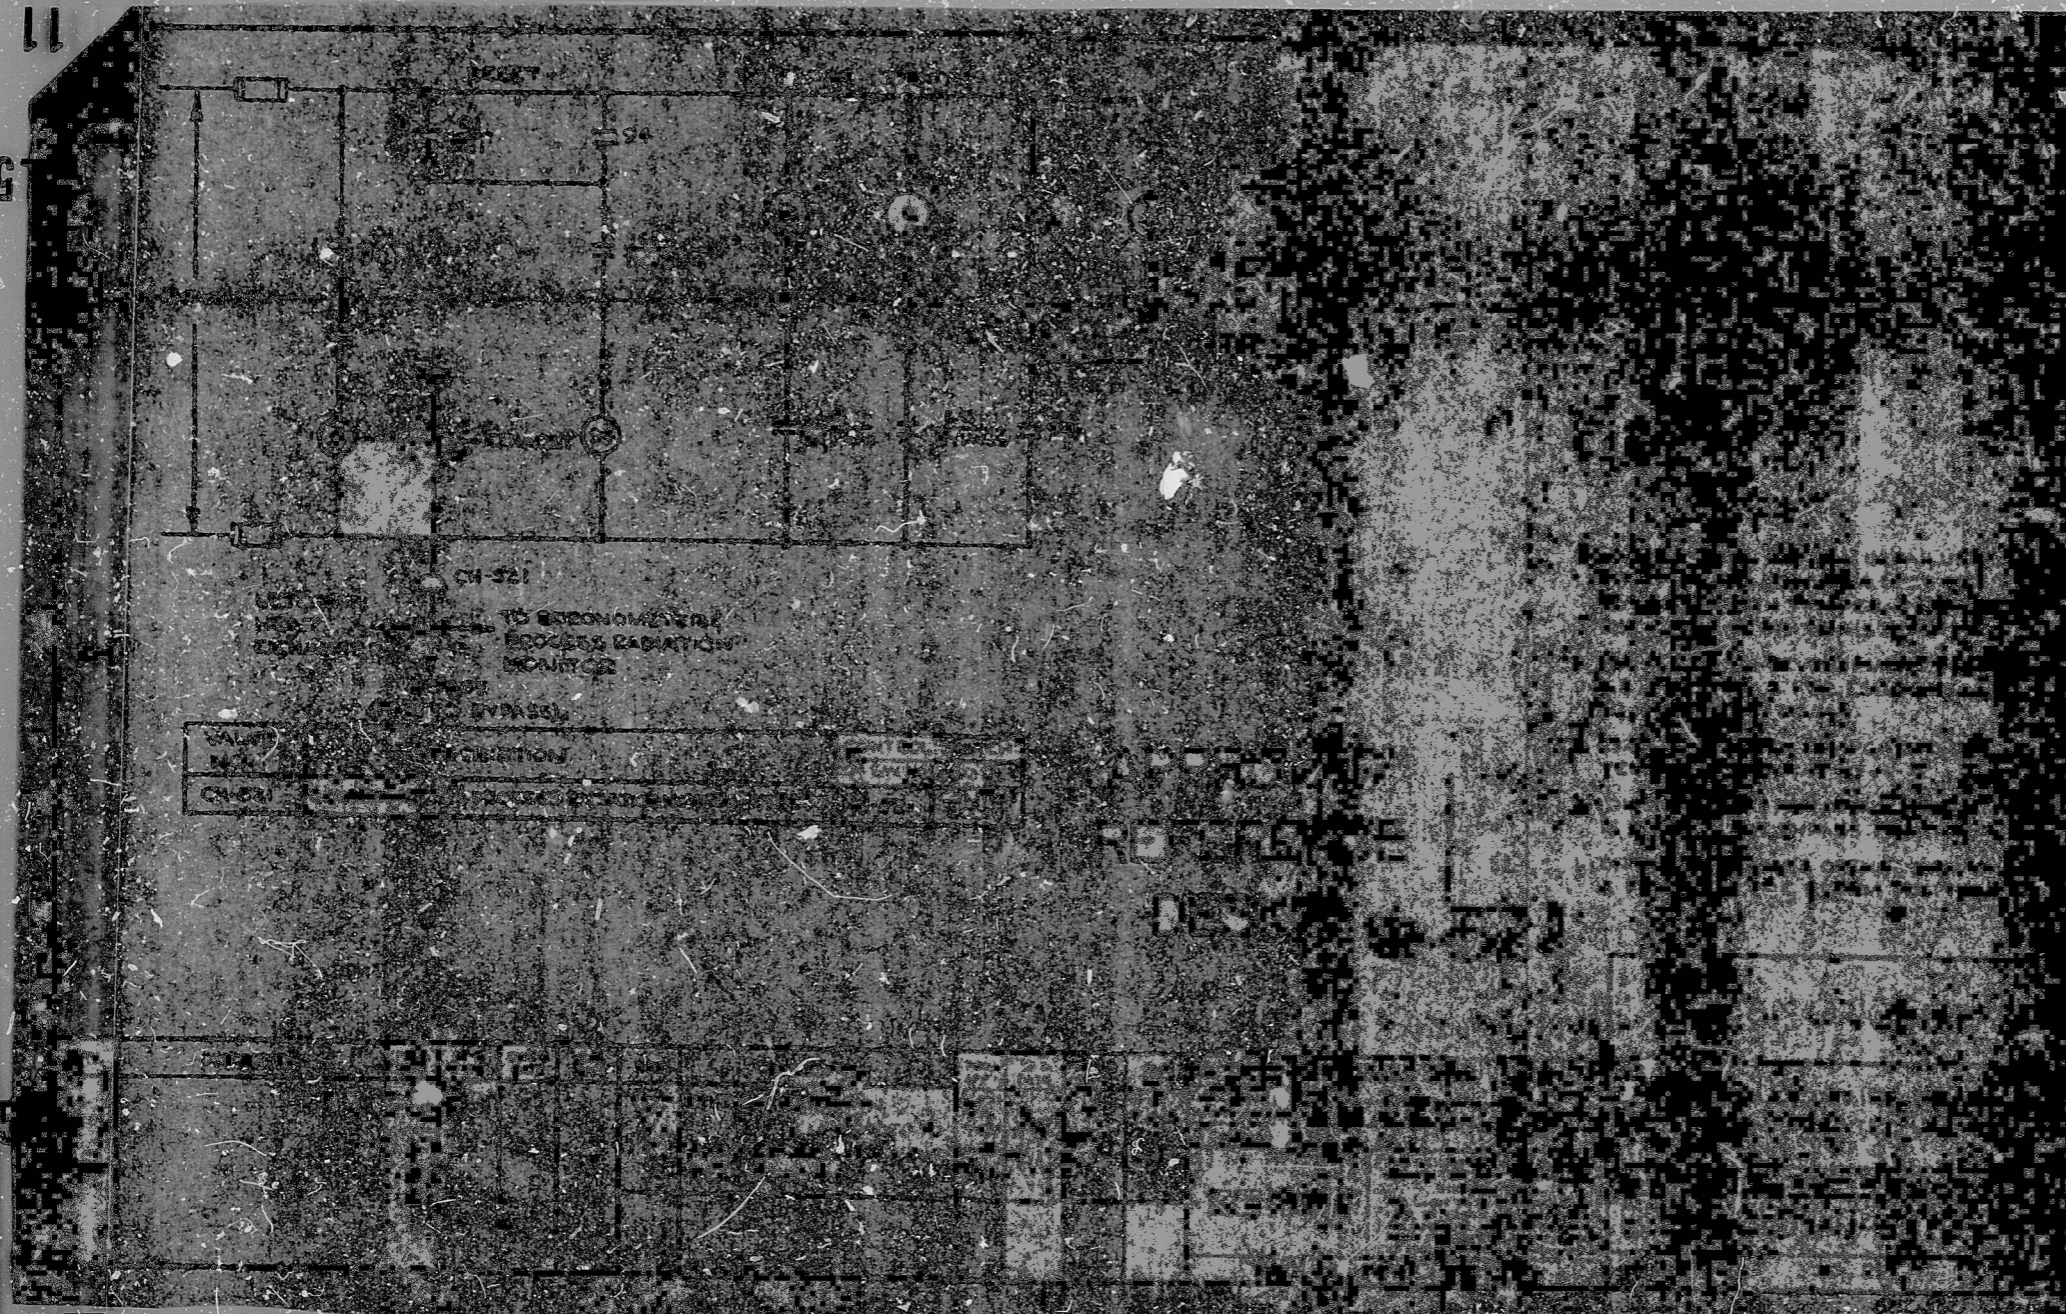

**POOR ORIGINAL**  
 P.R.C.  
 APERTURE  
 BOARD

WPPSS-EMERAC  
 GROUP  
 APR 26 1977  
 RECEIVED

FOR YOUR REVIEW AND COMMENT  
 DUE 7-26-77

**FILE COPY**  
 NOT SEND FROM OFFICE  
 ORIGINAL SENT TO CLIENT

DESIGN	DISCIPLINE	REVISIONS
NO.		
	MET/MECH	
	CONC-INT	
	ARCH	
	STRUCT	
	MECH/E	
	PLUMBING	
	MISC	
	ELECTRICAL	
	WTR TREAT	
	WASTE	
	STEEL	
	CONCRETE	
	MATERIALS	
	CONST	
	LICENSING	

3240 947 R 1

WASHINGTON PUBLIC POWER  
 SUPPLY SYSTEM  
 WPPSS NUCLEAR PROJECT NO. 3

P.S. 2008

REVISIONS

DATE

BY

DESCRIPTION

1. 7/20/77

2. 7/20/77

8.5

11

17

RIDS

8302220604

