


APPROVED REFERENCE DESIGN

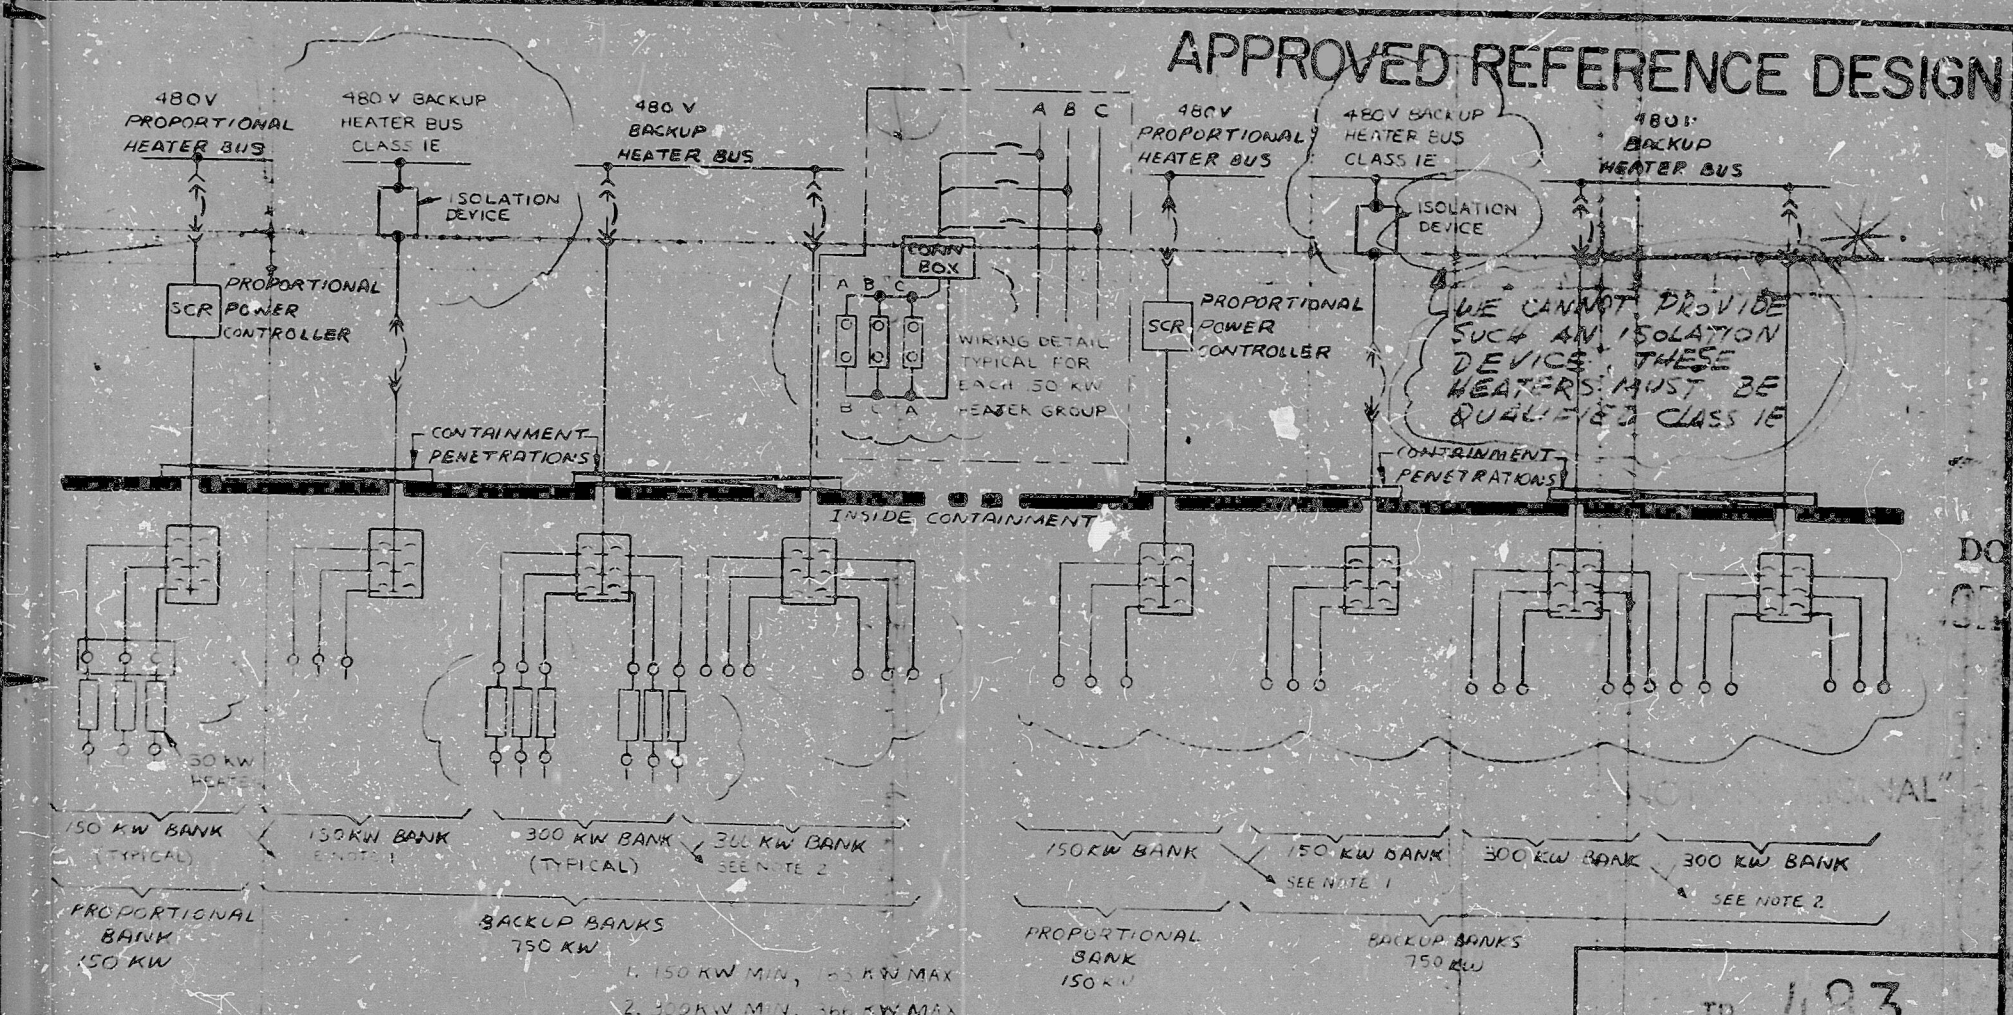

POOR ORIGINAL

WPPSS-EMBRAC GROUP
 APR 1977

REV	DATE	BY	DESCRIPTION
1	1/22/77	W/C	FOR COMMENT REVISED LETTER CEEB-77-415
2	7/9/77	W/C	Comments by ELEC. DESIGN DODEG
3	7/17/77	W/C	Comments by ELEC. DESIGN DODEG
4	7/17/77	W/C	Comments by ELEC. DESIGN DODEG

DESCRIPTION: EBASCO REVISION

FILE COPY
 DO NOT SEND FROM OFFICE
 ORIGINAL SENT TO CLIENT

DESIGN FOR	DISCIPLINE	ENGINEERING FOR
<input type="checkbox"/>	MECHANICAL	<input type="checkbox"/>
<input type="checkbox"/>	COND-MYD	<input type="checkbox"/>
<input type="checkbox"/>	ARCH	<input type="checkbox"/>
<input type="checkbox"/>	CONTRACT	<input type="checkbox"/>
<input type="checkbox"/>	INSTRN	<input type="checkbox"/>
<input type="checkbox"/>	CONTROL	<input type="checkbox"/>
<input type="checkbox"/>	PLANNING	<input type="checkbox"/>
<input type="checkbox"/>	HVAC	<input type="checkbox"/>
<input type="checkbox"/>	ELECTRICAL	<input type="checkbox"/>
<input type="checkbox"/>	WTR TREAT	<input type="checkbox"/>
<input type="checkbox"/>	RADIATION	<input type="checkbox"/>
<input type="checkbox"/>	STEELS	<input type="checkbox"/>
<input type="checkbox"/>	SHIELDING	<input type="checkbox"/>
<input type="checkbox"/>	MATERIALS	<input type="checkbox"/>
<input type="checkbox"/>	CONST	<input type="checkbox"/>
<input type="checkbox"/>	LICENSING	<input type="checkbox"/>

3240 974 R6

WASHINGTON PUBLIC POWER SUPPLY SYSTEM
 WPPSS NUCLEAR PROJECT NO. 3

P.O. CE 2083

REVISIONS:

1	REVISED WITH COMMENTS AS SHOWN
2	REVISED WITH COMMENTS AS SHOWN
3	REVISED WITH COMMENTS AS SHOWN
4	REVISED WITH COMMENTS AS SHOWN

NOTE: DO NOT SEND FROM OFFICE ORIGINAL SENT TO CLIENT

WPPSS HEATER CONTROL

REV	DESCRIPTION	BY & DATE	CHK & DATE	ENG. APPD	REV.	DESCRIPTION	BY & DATE	CHK & DATE	ENG. APPD	REV.	DESCRIPTION	BY & DATE	CHK & DATE	ENG. APPD	REV.
01	REVISED TO 4 WAS (OF 3) REVISED HEATER CONTROL AND RELATED CIRCUITS. UPDATED TO APPROVED DESIGN. REV. REV. 01-500-100														

POWER SYSTEMS

NUCLEAR POWER SYSTEMS

TR-493

SINGLELINE WIRING DIAGRAM
 HEATER CONTROLS

COMP. CODE NO. 05-84-7220

B-5Y580-414-40101

SHEET 1 OF 4

RIDS

8302220614

