

11

11

8

5

11


11

8

8.5

11

17

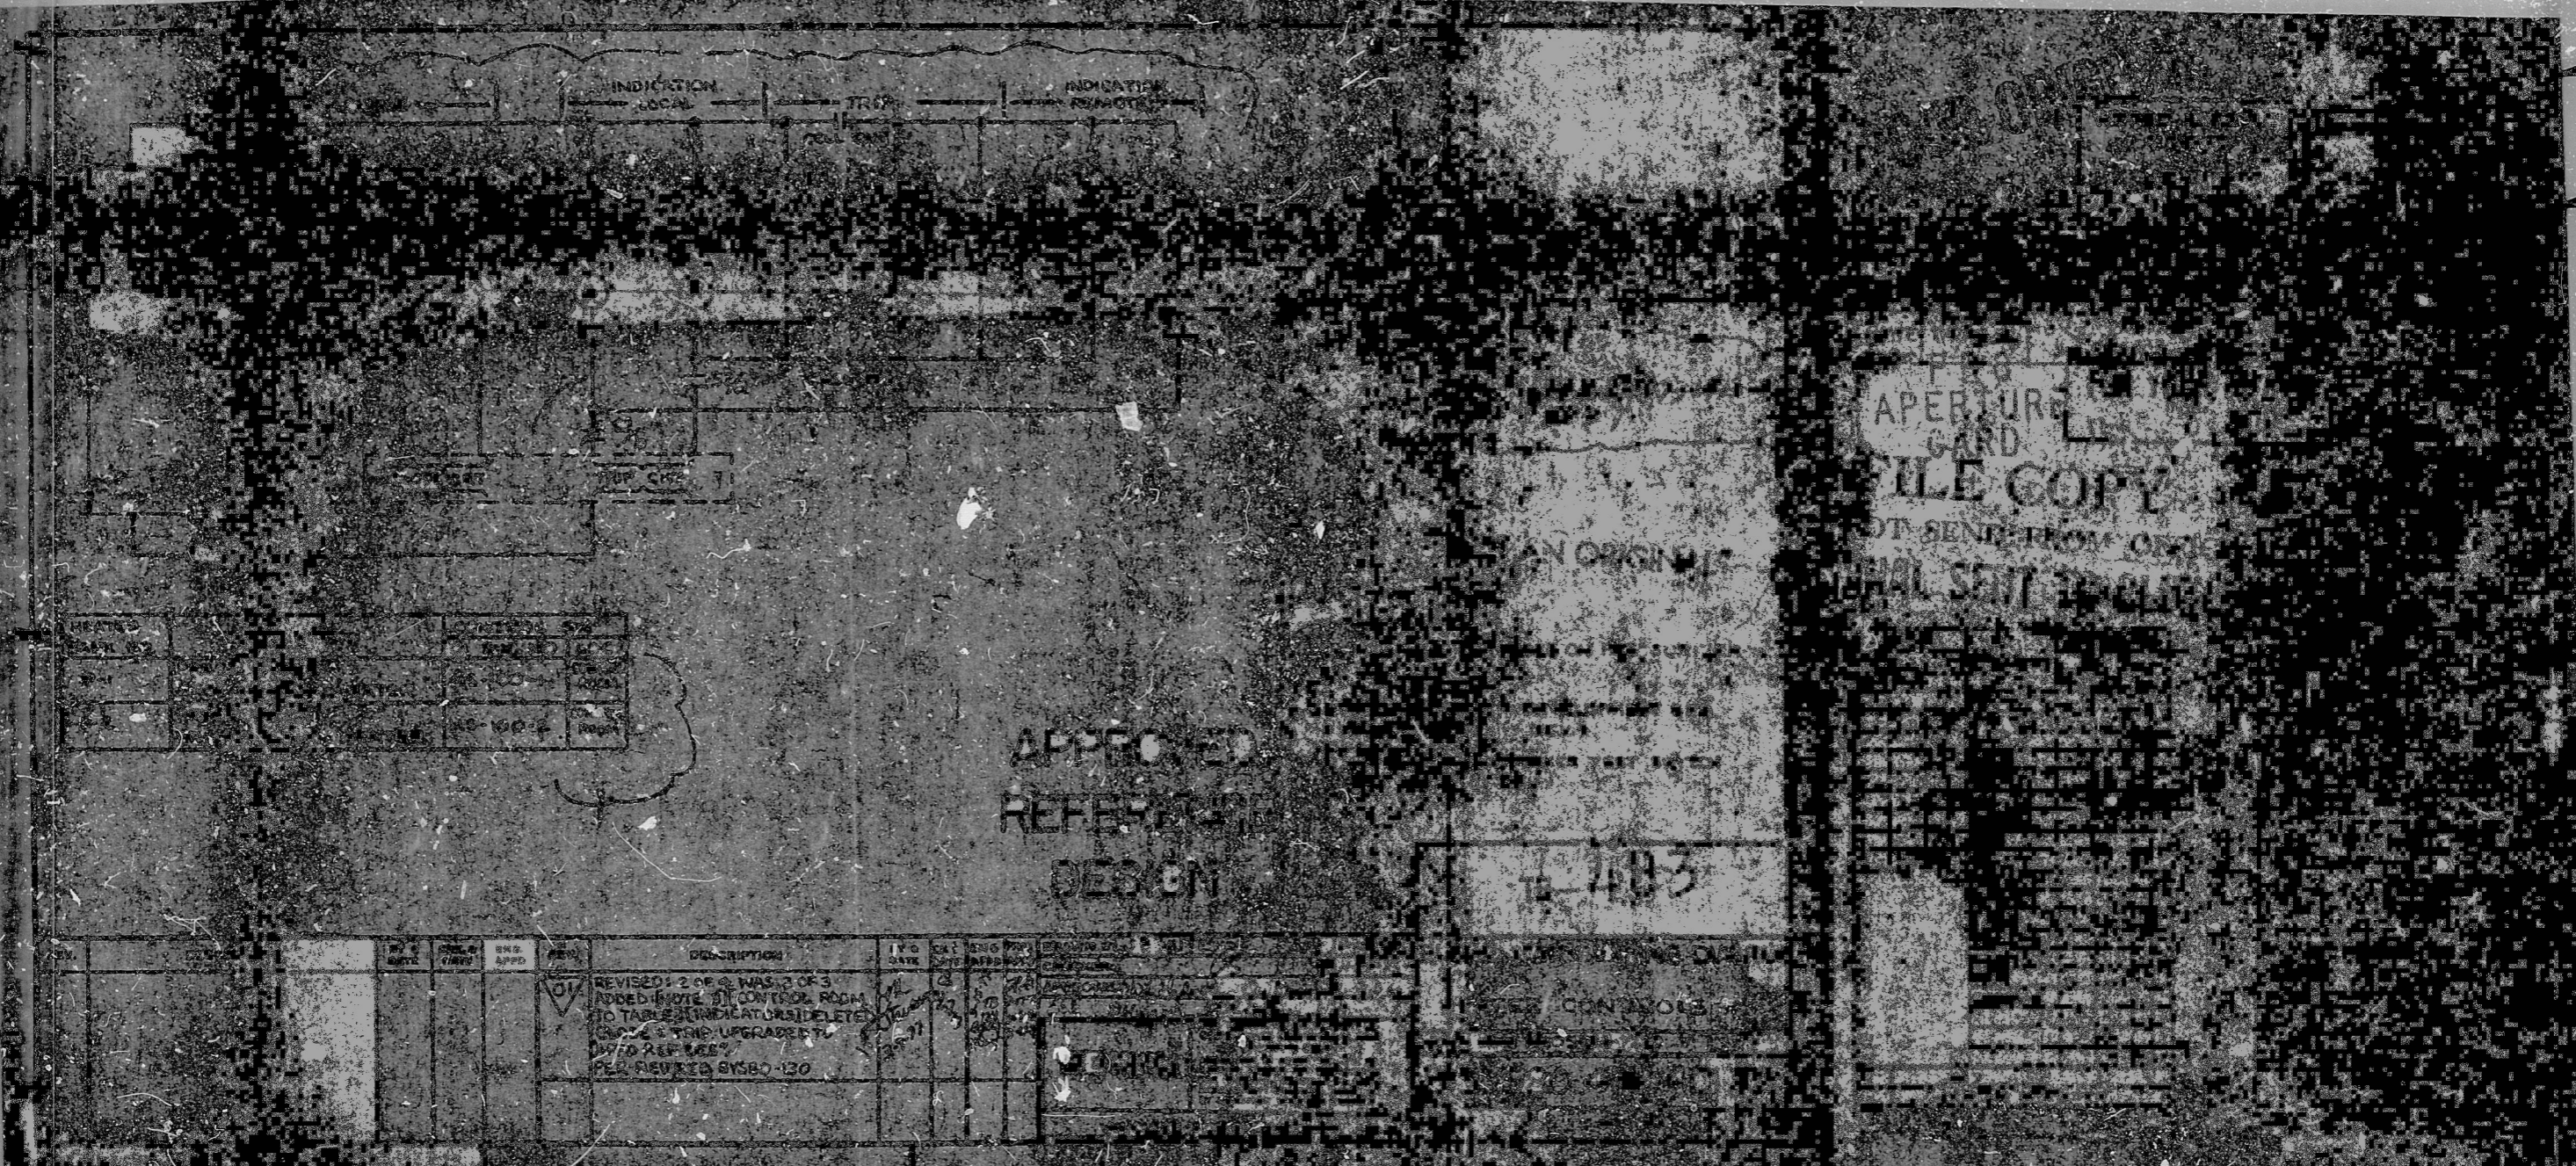

APPROVED  
REFERENCE  
DESIGN

APERTURE  
GARD  
FILE COPY

REV	DATE	DESCRIPTION	BY	CHKD	APPD	REV
01		REVISED: 2 OF 3 WAS 3 OF 3 ADDED INDIC. IN CONTROL ROOM TO TABLE INDICATORS DELETED CIRCUIT & WIND UPGRADED BY DWD REF 1007 PER REVISED SYSBO-130				



RIDS

8302220617

