


17

11

8.8

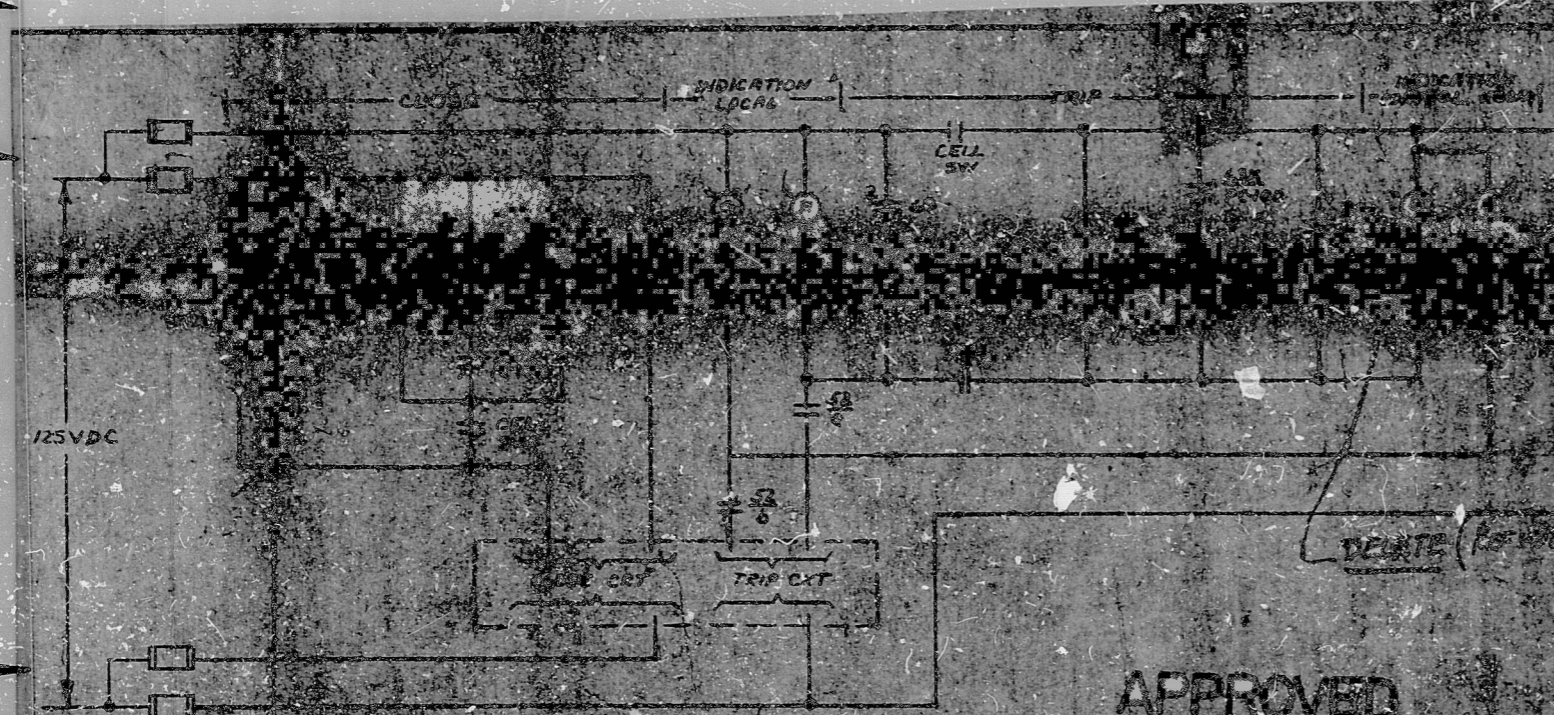


APPROVED  
REFERENCE  
DESIGN



IN ORDER TO BE USED...  
RETURN ORIGINAL

TR-486

EXERCISE CARD  
COPY  
OFFICE  
SENT TO...

3.5"

11"

17"

RIDS

8302230032

