

11

11

8

5"

11


11

11

8

5"

17

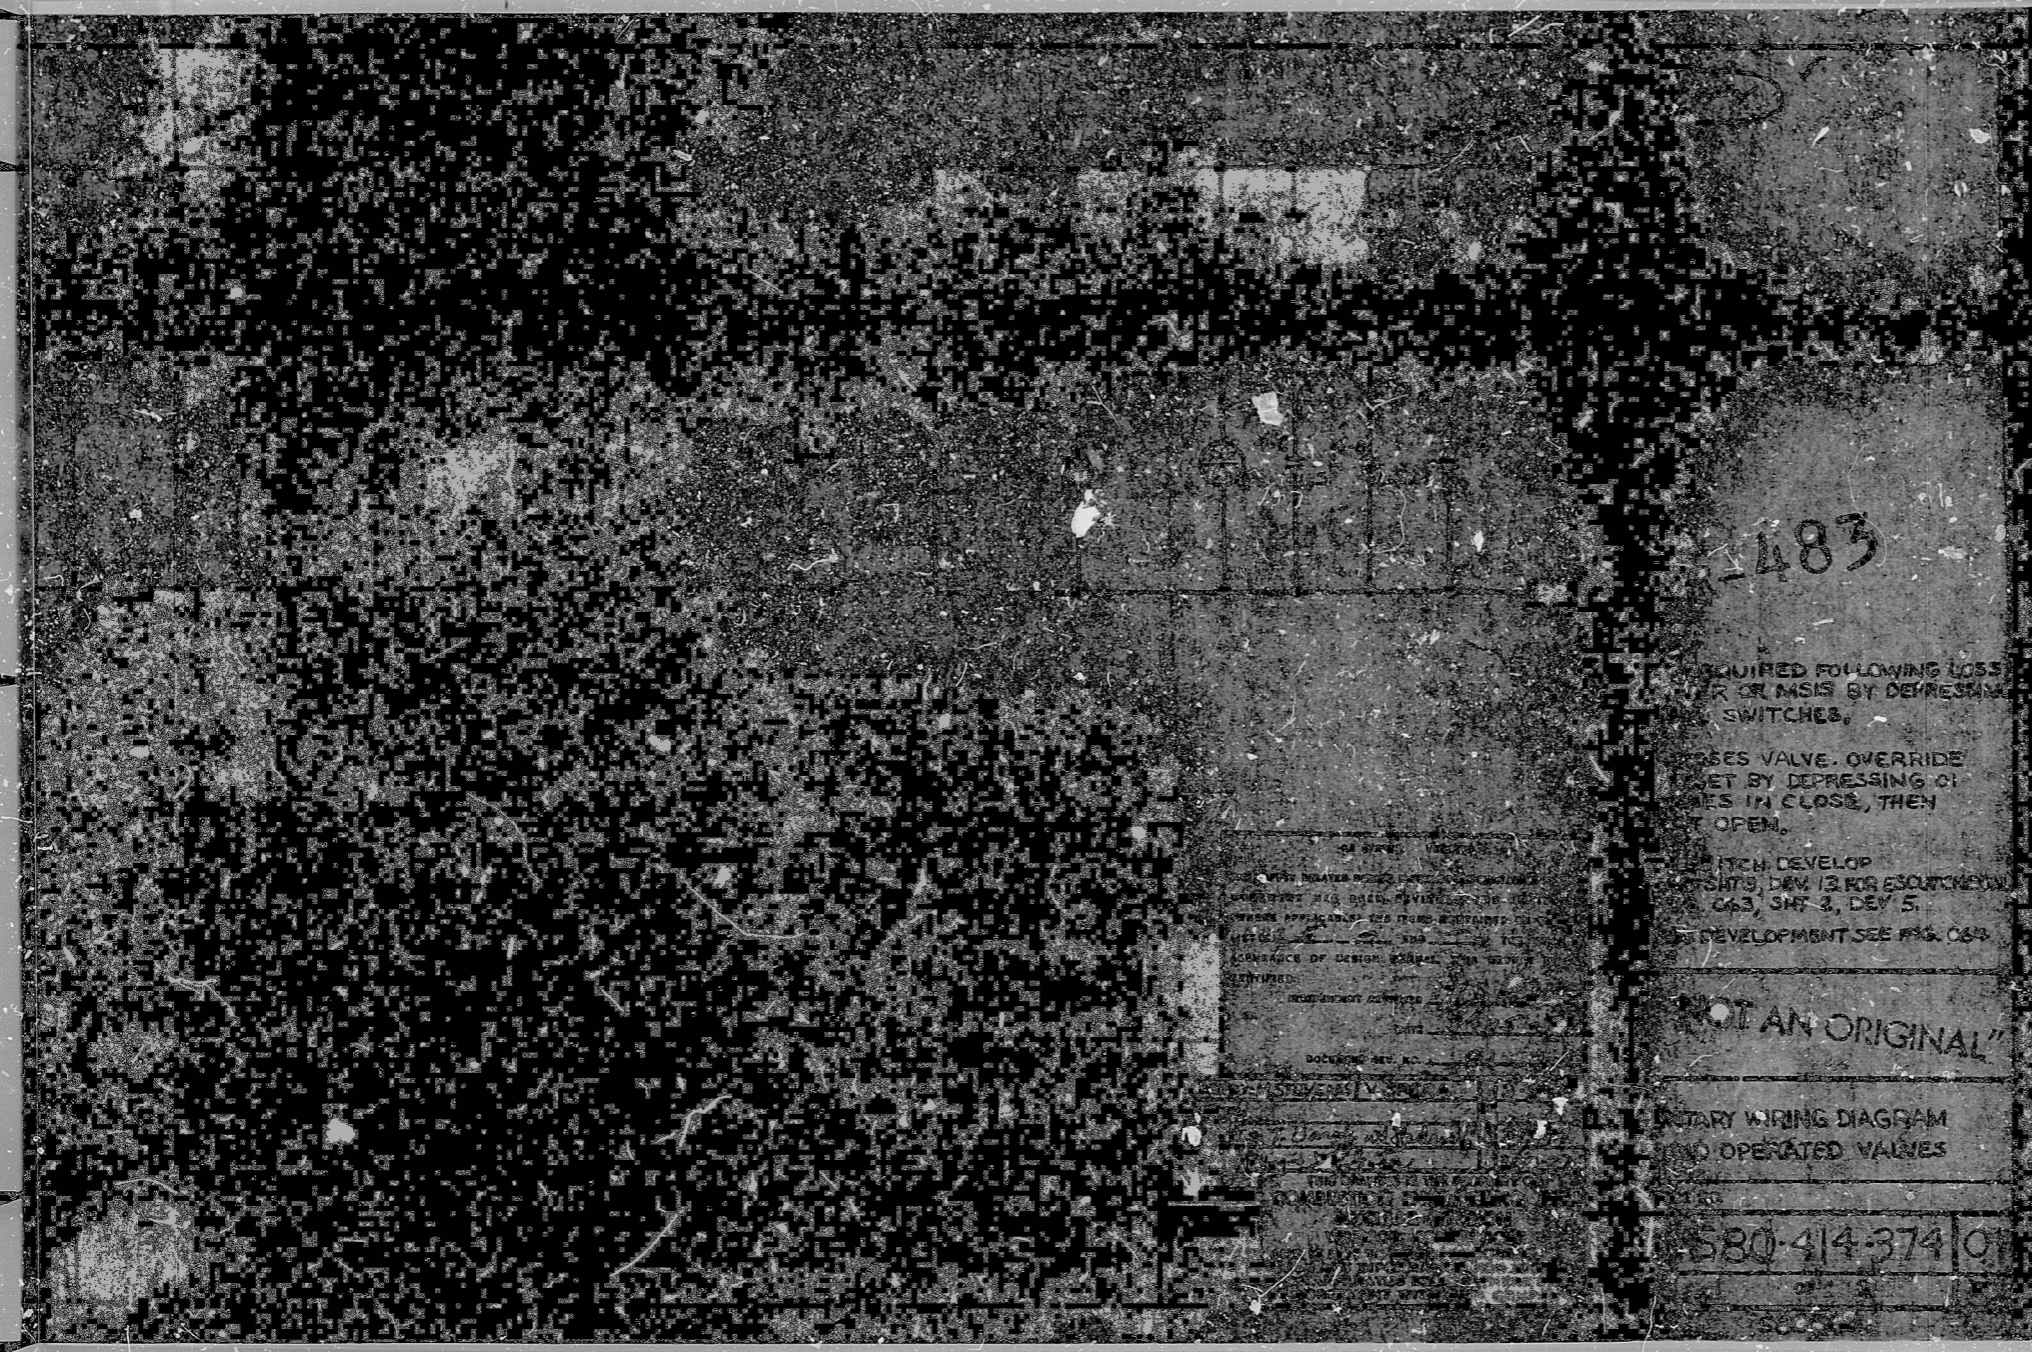

483

REQUIRED FOLLOWING LOSS  
OR MSIS BY DEPRESSING  
SWITCHES.

OPENS VALVE. OVERRIDE  
SET BY DEPRESSING OF  
SWITCHES IN CLOSE, THEN  
TO OPEN.

ITCH DEVELOP  
CHTS, DEV 13 FOR SWITCHES  
463, SHE 3, DEV 5.  
DEVELOPMENT SEE #463, OSB.

NOT AN ORIGINAL

WIRING DIAGRAM  
OPERATED VALVES

580-414-3740

PRC  
APERTURE  
CARD

WPPSS-EMDRAC  
GROUP  
MAY 17 1977  
COMPLETED

WPPSS-EMDRAC  
GROUP  
MAR 28 1977  
RECEIVED

FOR YOUR REVIEW AND COMMENT  
DUE 5-6-77

TR-483

3240 3241 RO E22

WASHINGTON PUBLIC POWER  
SUPPLY SYSTEM  
WPPSS NUCLEAR PROJECT NO. 3

NO.	DESCRIPTION	DATE	INITIALS
1	REVISION		
2	REVISION		
NOTE: NO. 1  
NO. 2  
NO. 3  
DATE TO  
1/7/77 M

FOR THE DIRECTOR  
WASHINGTON PUBLIC POWER  
SUPPLY SYSTEM

WASHINGTON, D.C.



RIDS

8307230036

