

22"

17"

11"

8.5"

8.5"

11"

17"

22"

22"

17"

11"


8.5"

8.5"

11"

17"

22"

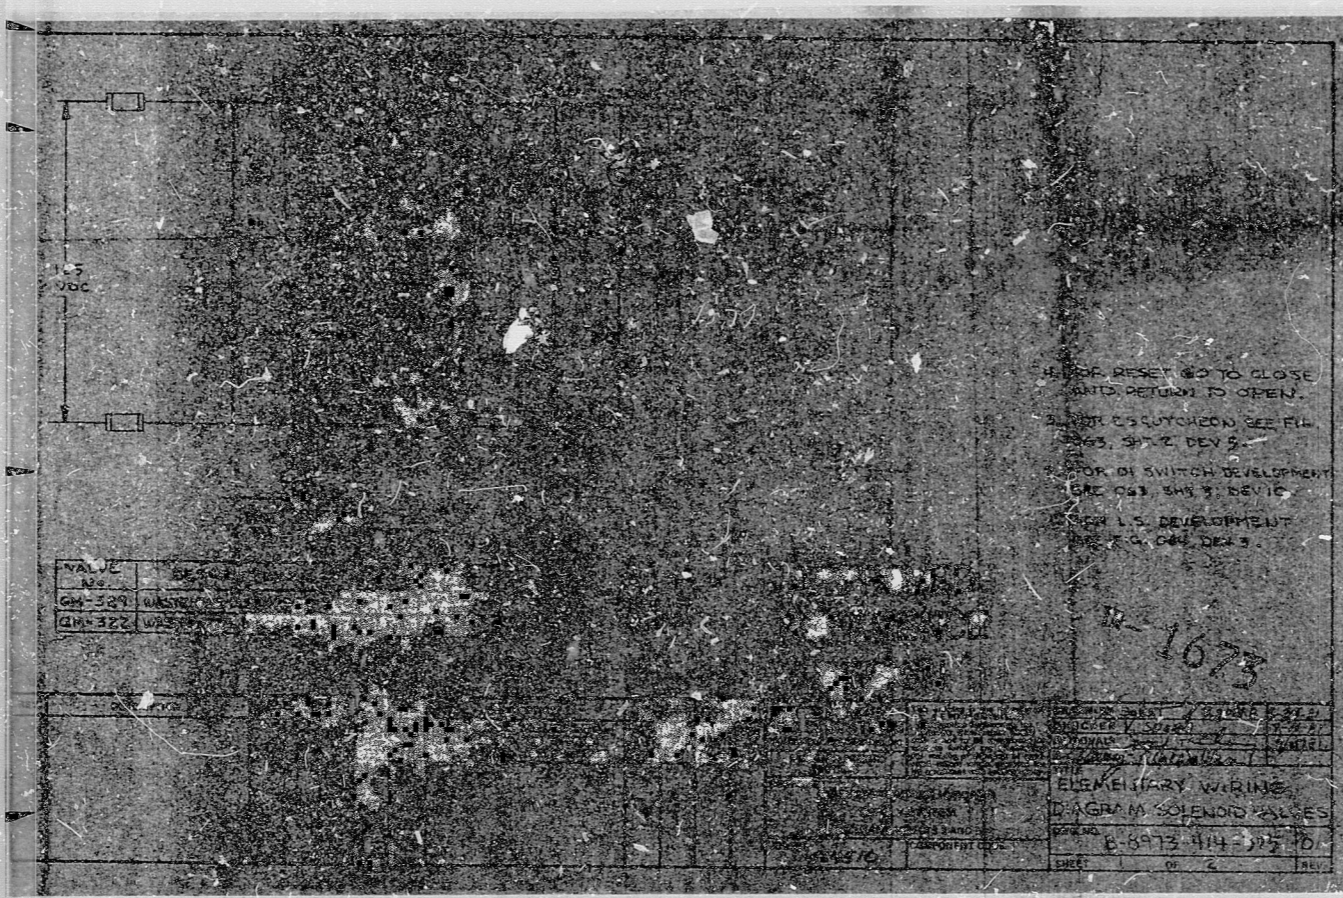

RE-1673
 RE-1673 414-177 D

POOR ORIGINAL

PRO APERTURE CARD




ELEMENTARY WIRING
 DIAGRAM SOLENOID VALVES

DATE 1-21-82
 BY [Signature]
 CHECKED BY [Signature]


RIDS

8302250450

