


WPPSS-3240-G-4006

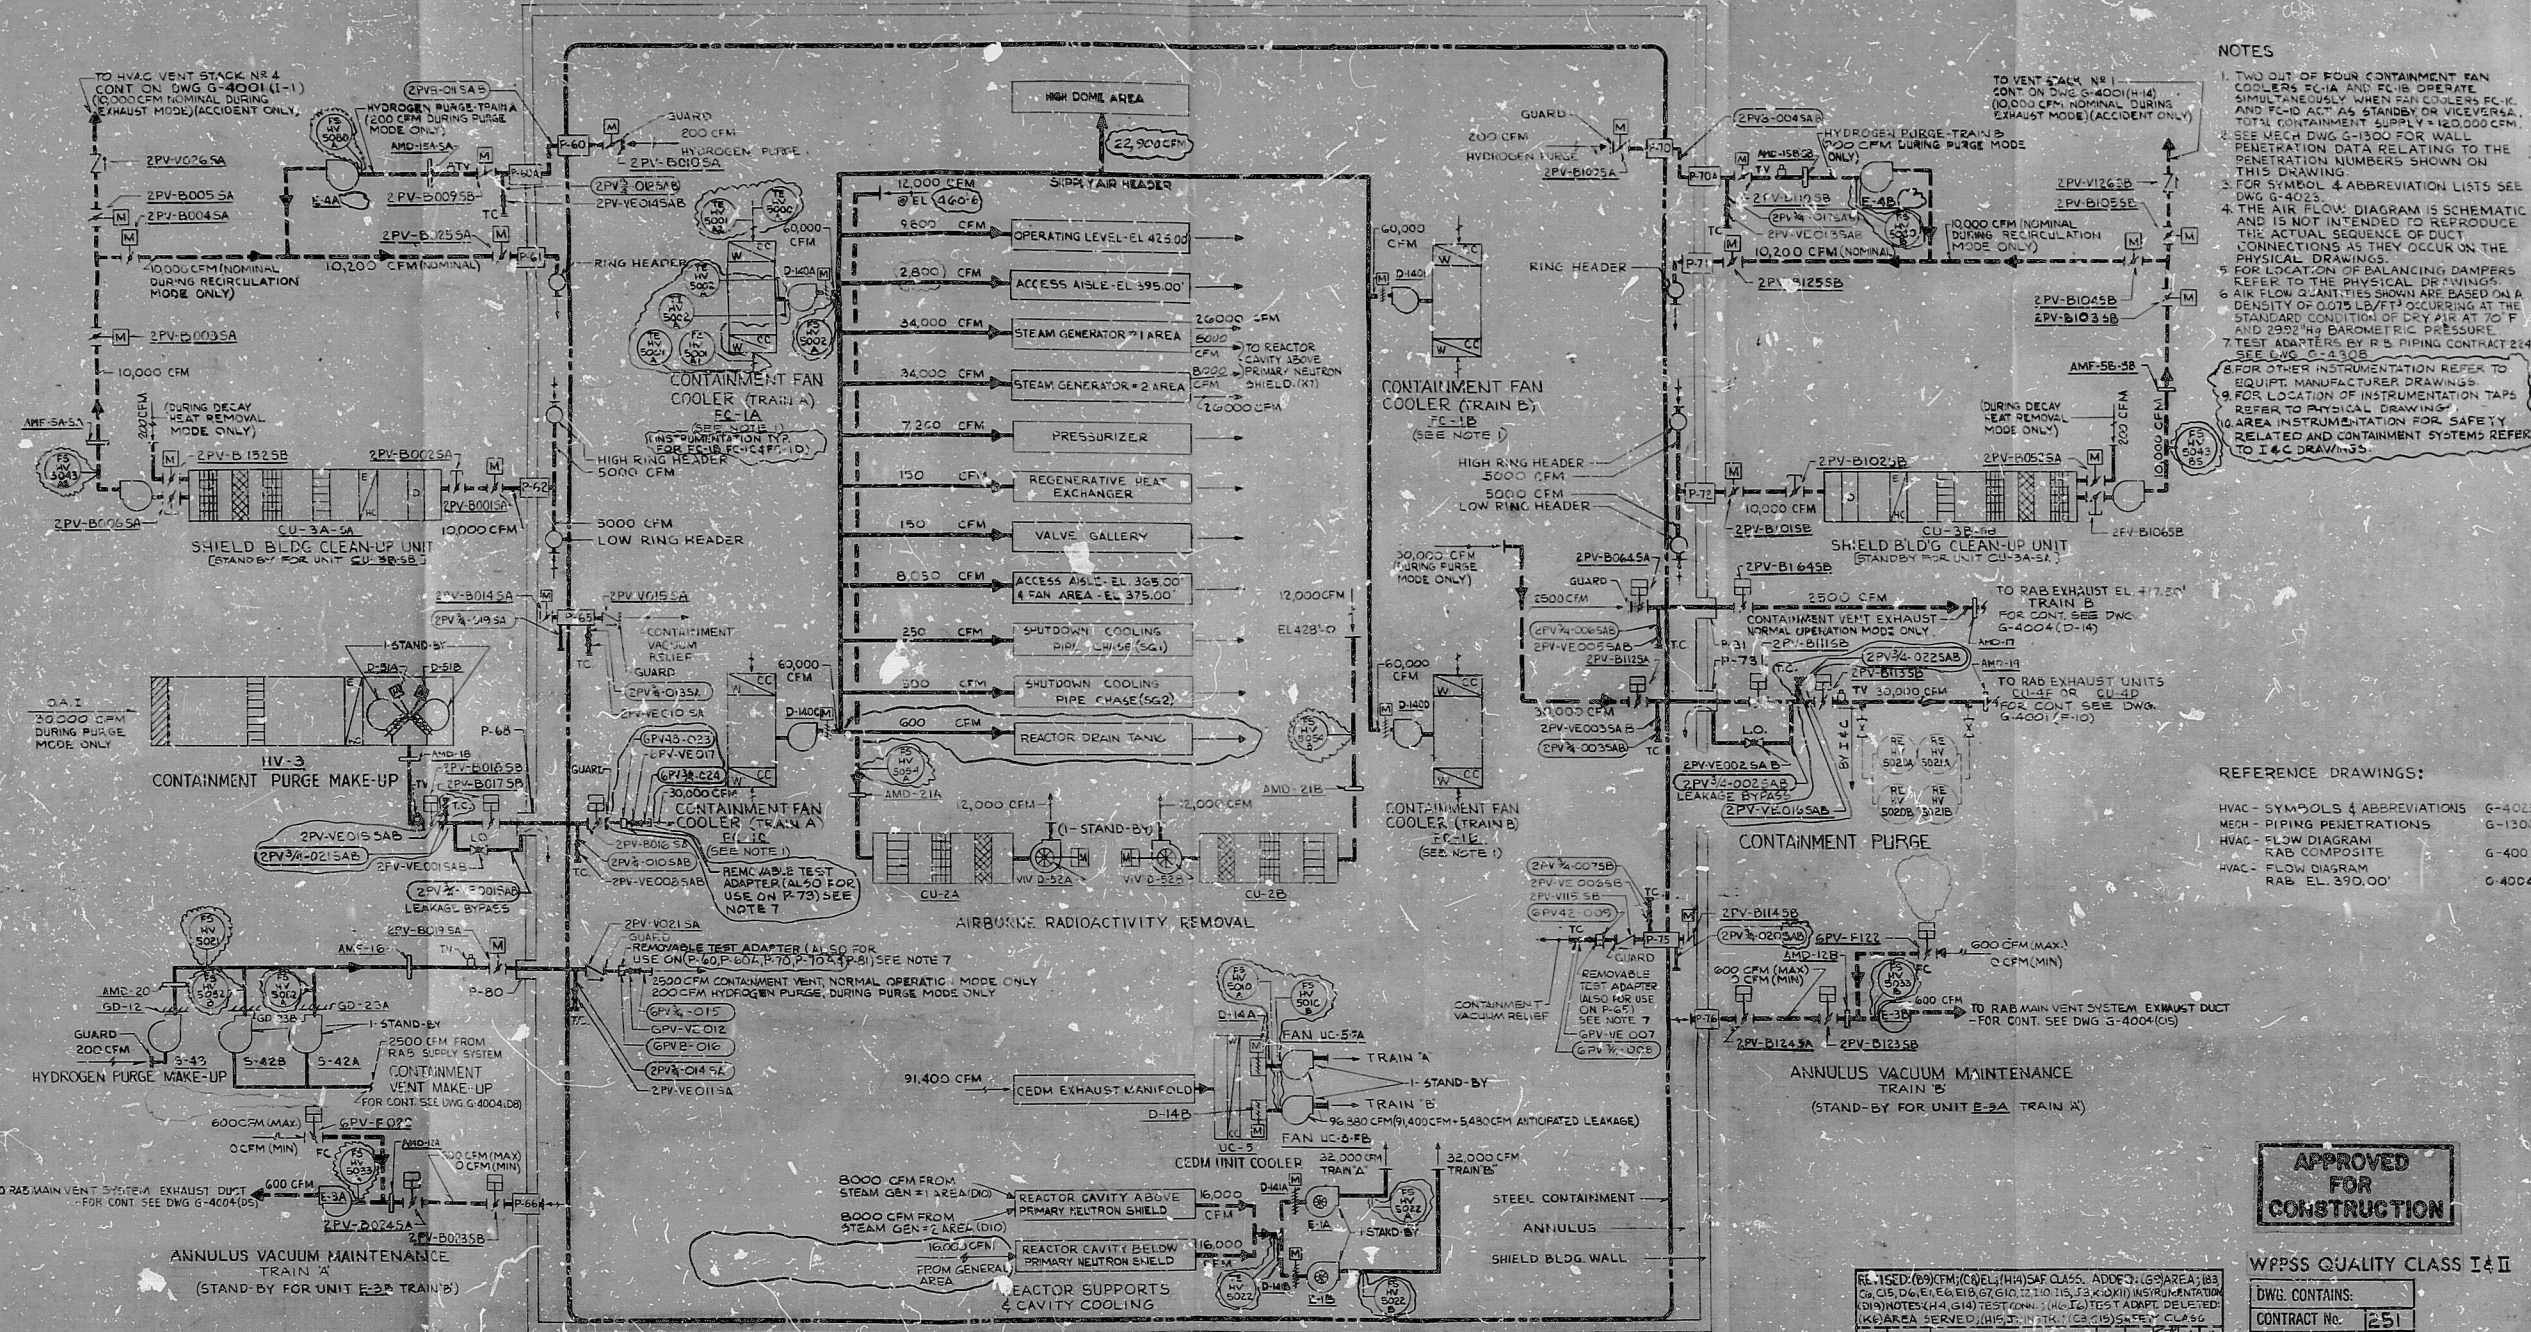

- NOTES**
  - SEE MECH DWG G-1300 FOR WALL PENETRATION DATA RELATING TO THE PENETRATION NUMBERS SHOWN ON THIS DRAWING.
  - FOR SYMBOL & ABBREVIATION LISTS SEE DWG G-4023.
  - THE AIR FLOW DIAGRAM IS SCHEMATIC AND IS NOT INTENDED TO REPRODUCE THE ACTUAL SEQUENCE OF DUCT CONNECTIONS AS THEY OCCUR ON THE PHYSICAL DRAWINGS.
  - FOR LOCATION OF BALANCING DAMPERS REFER TO THE PHYSICAL DRAWINGS.
  - AIR FLOW QUANTITIES SHOWN ARE BASED ON A DENSITY OF 0.075 LB/FT<sup>3</sup> OCCURRING AT 70°F AND 29.92 IN. BAROMETRIC PRESSURE.
  - FOR OTHER INSTRUMENTATION REFER TO EQUIP. MANUFACTURER DRAWINGS.
  - FOR LOCATION OF INSTRUMENTATION TAPS REFER TO PHYSICAL DRAWINGS.
  - AREA INSTRUMENTATION FOR SAFETY RELATED AND CONTAINMENT SYSTEMS REFER TO I & C DRAWINGS.

- REFERENCE DRAWINGS:**
- HVAC - SYMBOLS & ABBREVIATIONS G-4023
  - MECH - PIPING PENETRATIONS G-1300
  - HVAC - FLOW DIAGRAM G-4001
  - RAB - FLOW COMPOSITE G-4004

**APPROVED FOR CONSTRUCTION**

**WPPSS QUALITY CLASS I & II**

DWG. CONTAINS:	
CONTRACT No.	251
CONTRACT No.	232
CONTRACT No.	224

**PRC APERTURE CARD**

**NUCLEAR SAFETY RELATED**


DO NOT REMOVE OR ALTER ANY INSTRUMENTATION OR PIPING

WPPSS AIR FLOW DIAGRAM REACTOR BUILDING



REACTOR BUILDING



RIDS

8302250468

