


34

34

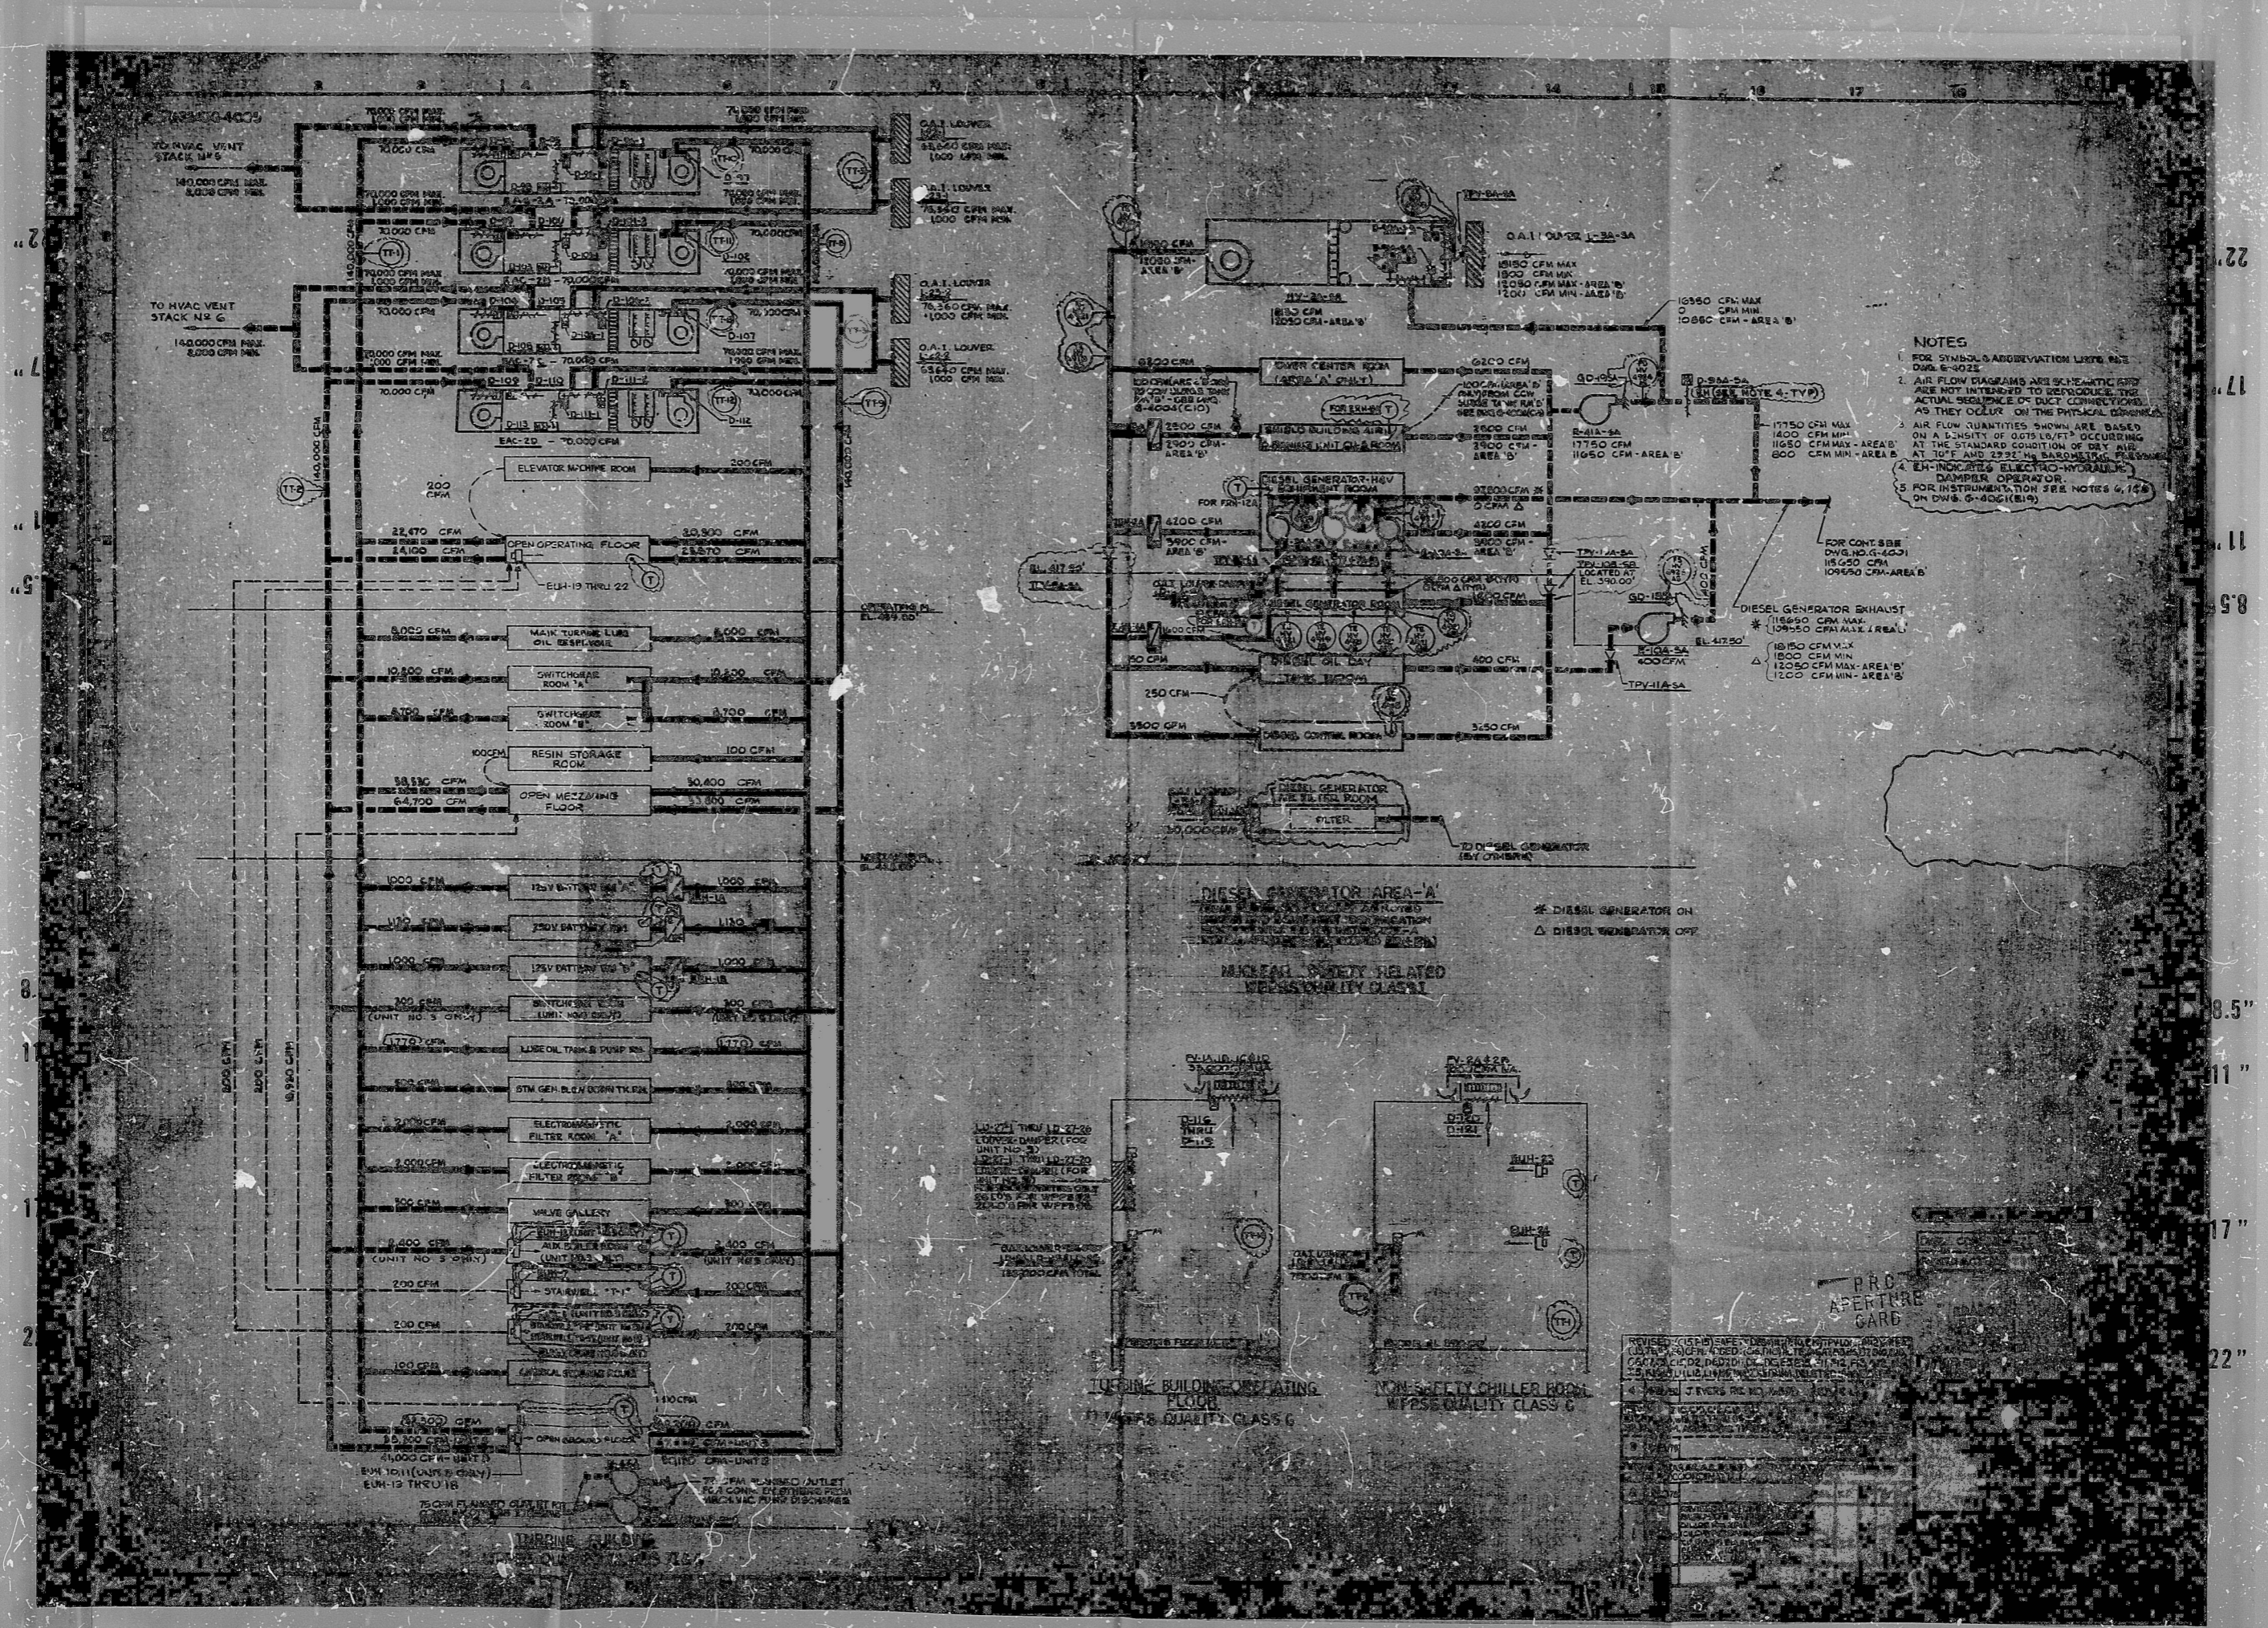

NOTES

- AIR FLOW DIAGRAMS ARE SCHEMATIC AND ARE NOT INTENDED TO REPRESENT THE ACTUAL SEQUENCE OF DUCT CONNECTIONS AS THEY OCCUR ON THE PHYSICAL DESIGN.
- AIR FLOW QUANTITIES SHOWN ARE BASED ON A DENSITY OF 0.075 LB/FT³ OCCURRING AT THE STANDARD CONDITION OF DRY AIR AT 70°F AND 29.92 IN. BAROMETRIC PRESSURE.

PRO APERTURE GARD

REVISION	NO.	DATE	DESCRIPTION

34

34

RIDS

8302250470

