


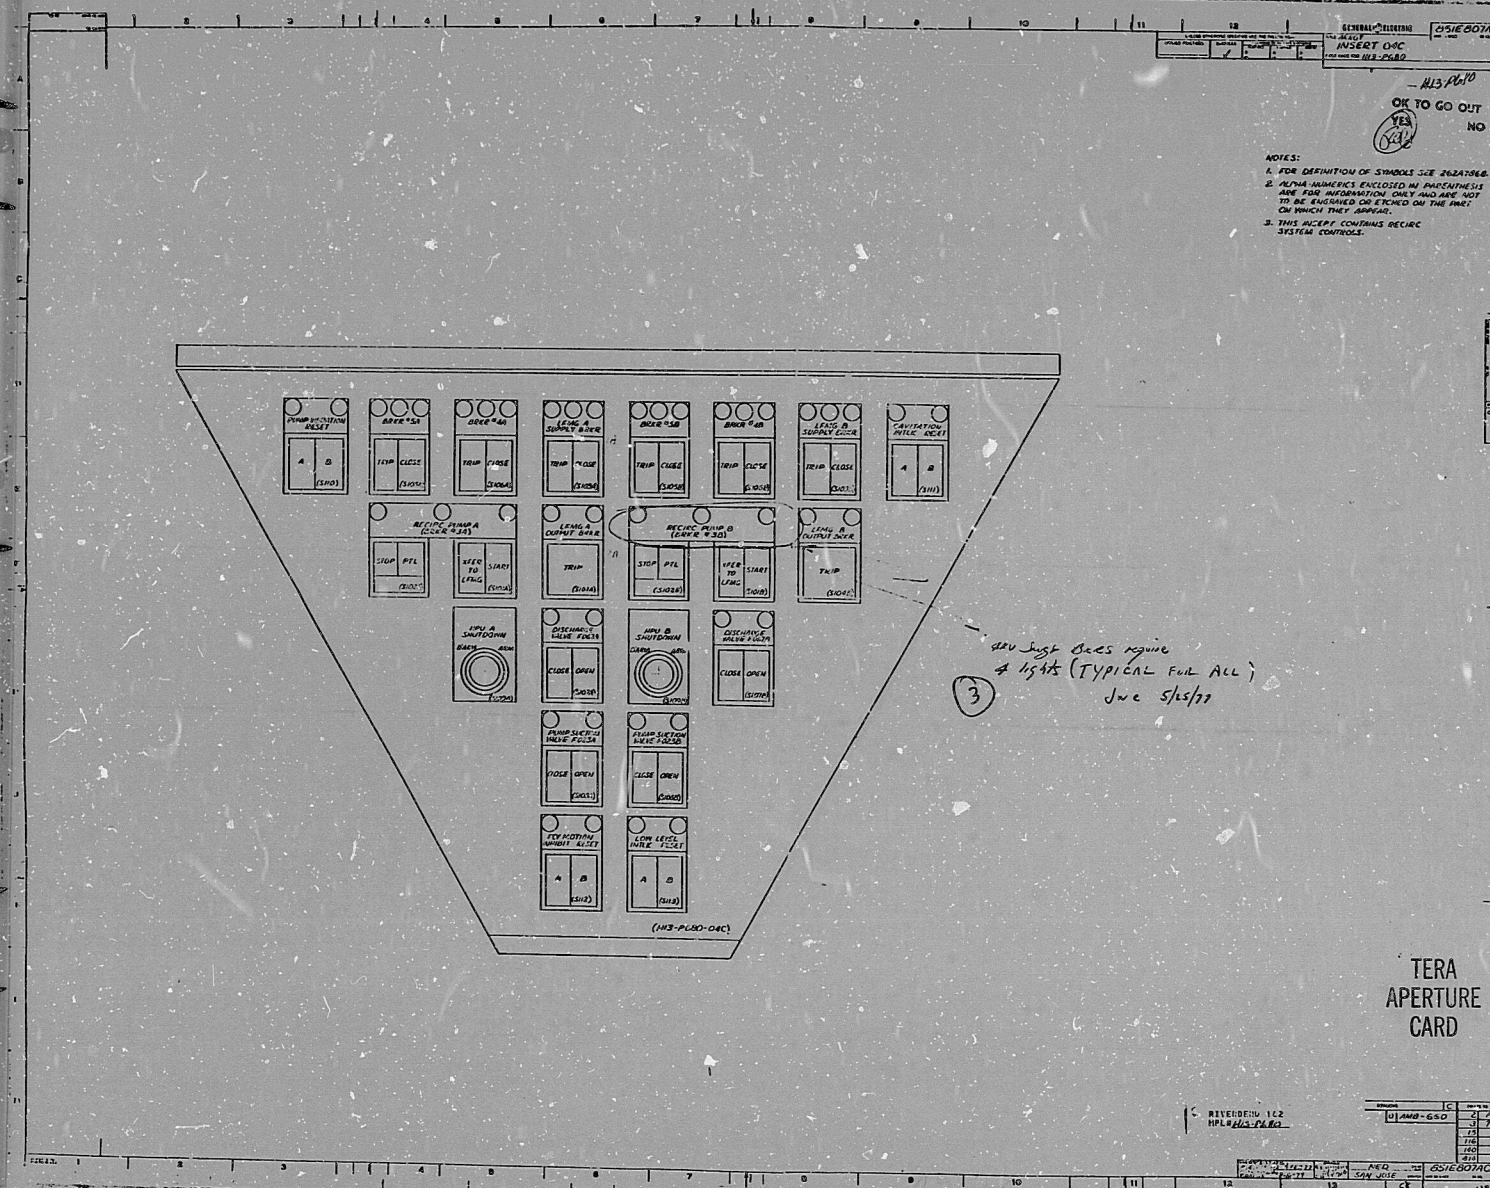



RIDS

8109240200

