


34

34

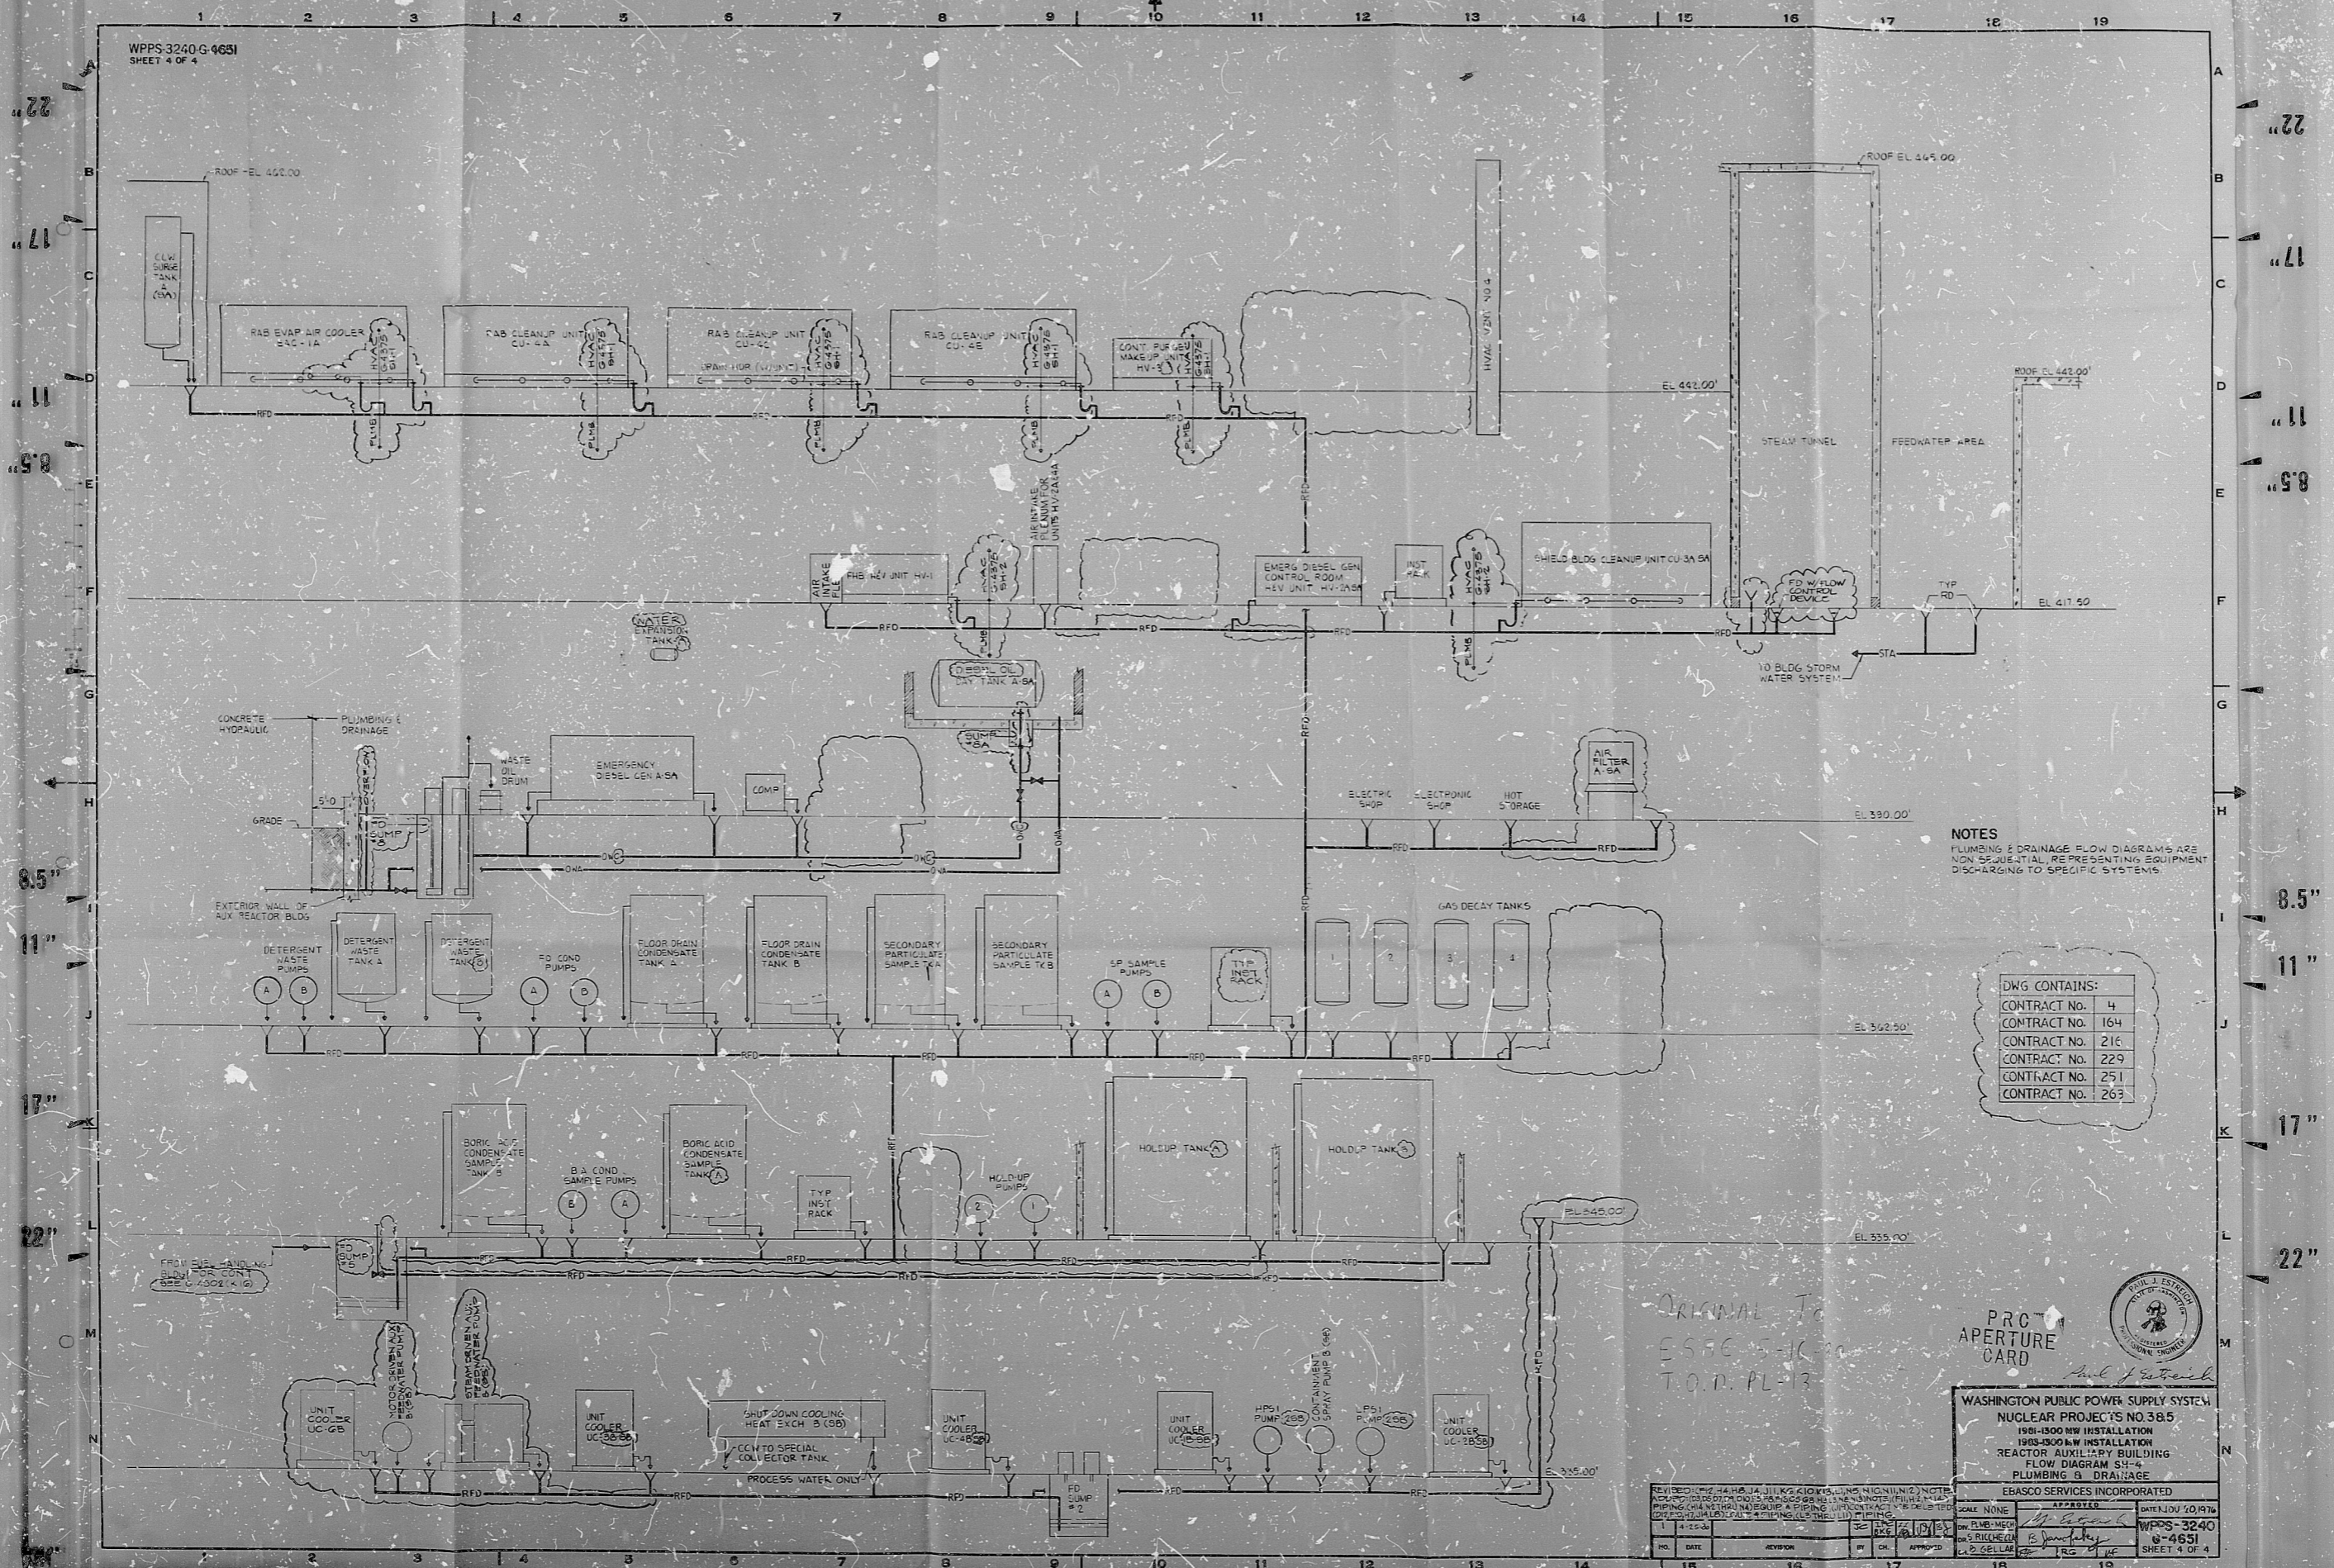

WPPS-3240-G-4651
SHEET 4 OF 4

NOTES
PLUMBING & DRAINAGE FLOW DIAGRAMS ARE
NON SEQUENTIAL REPRESENTING EQUIPMENT
DISCHARGING TO SPECIFIC SYSTEMS.

DWG CONTAINS:

| | |
|--------------|-----|
| CONTRACT NO. | 4 |
| CONTRACT NO. | 164 |
| CONTRACT NO. | 216 |
| CONTRACT NO. | 229 |
| CONTRACT NO. | 251 |
| CONTRACT NO. | 263 |

ORIGINAL TO
ES&C
T.O.D. PL-13

PROJ. APERTURE
CARD



WASHINGTON PUBLIC POWER SUPPLY SYSTEM
NUCLEAR PROJECT'S NO 385
1903-500 MW INSTALLATION
REACTOR AUXILIARY BUILDING
FLOW DIAGRAM S1-4
PLUMBING & DRAINAGE

| NO. | DATE | REVISION | BY | CHK. | APPROVED |
|-----|------|----------|----|------|----------|
| 1 | | | | | |
| 2 | | | | | |
22"
17"
11"
8.5"
8.5"
11"
17"
22"

34

Rev.

8303010/25

