

WPPS-3240-G-4651  
SHEET 3 OF 4

34"

34"

22"

22"

17"

17"

11"

11"

9.5"

9.5"

0.5"

0.5"

11"

11"

17"


17"

22"

22"

34"

34"

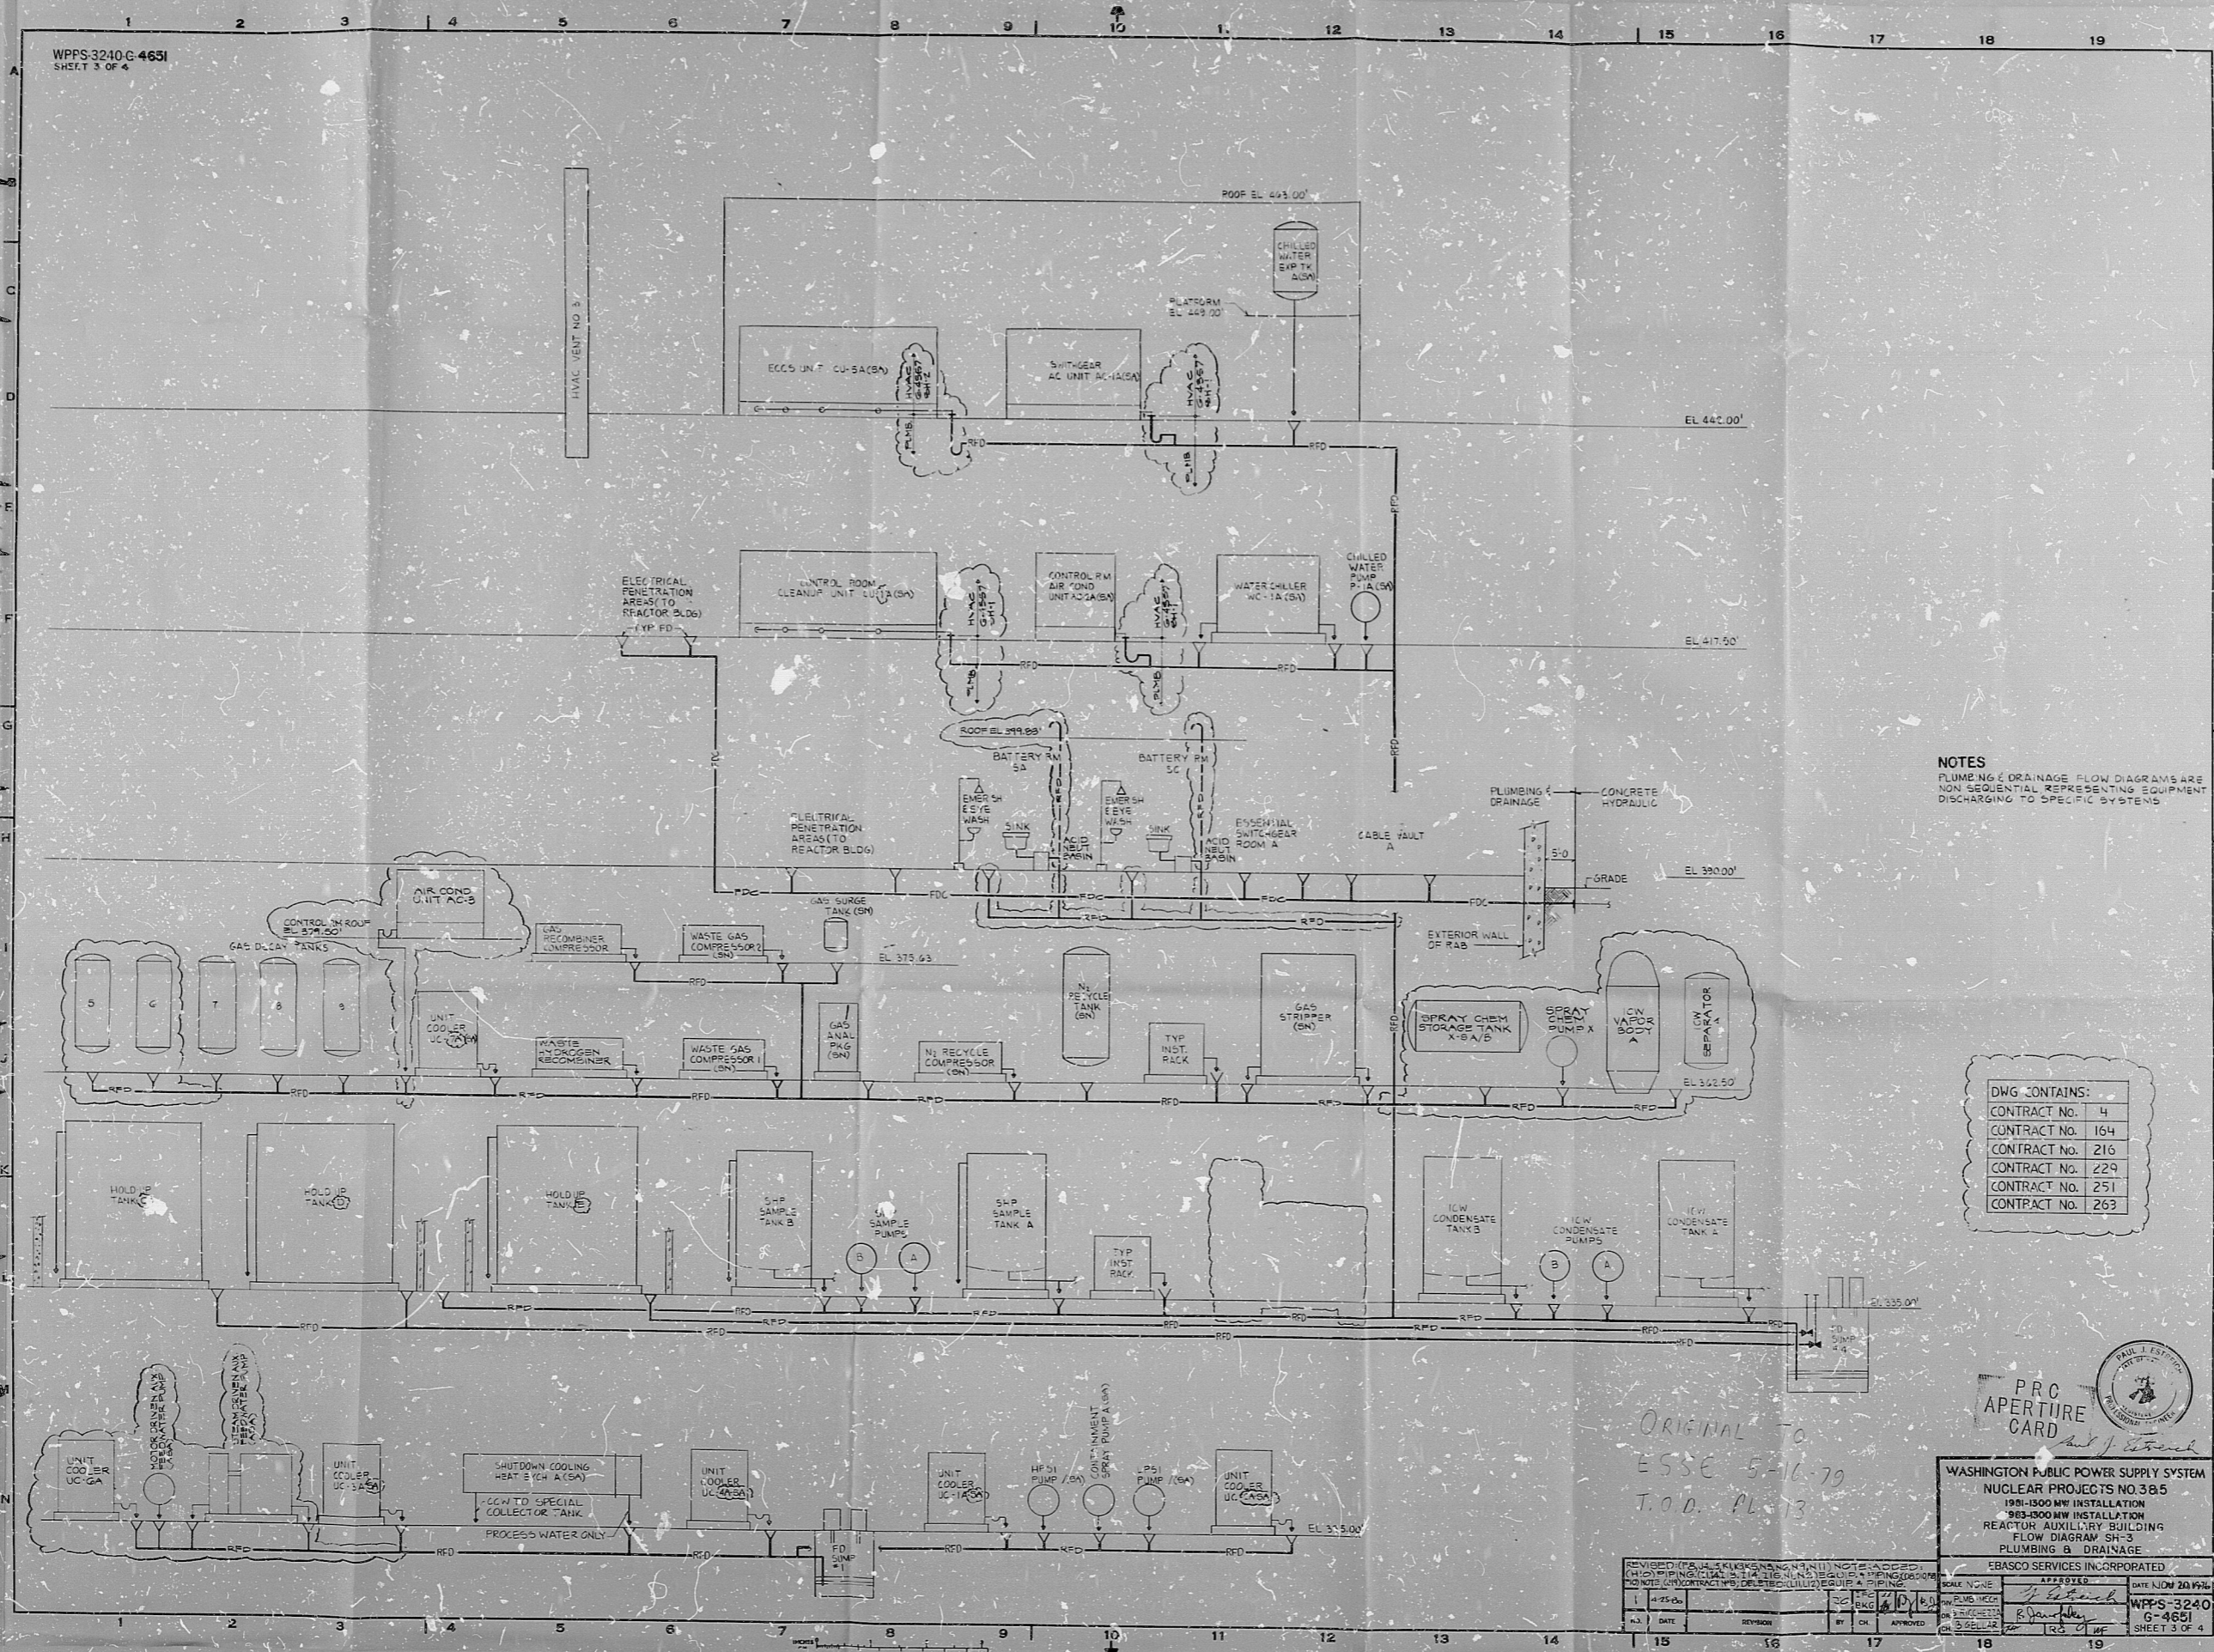

**NOTES**  
PLUMBING & DRAINAGE FLOW DIAGRAMS ARE  
NON SEQUENTIAL REPRESENTING EQUIPMENT  
DISCHARGING TO SPECIFIC SYSTEMS

DWG CONTAINS:  
CONTRACT NO. 4  
CONTRACT NO. 164  
CONTRACT NO. 216  
CONTRACT NO. 229  
CONTRACT NO. 251  
CONTRACT NO. 263

ORIGINAL TO  
ESSE 5-16-79  
T.O.D. PL-13



WASHINGTON PUBLIC POWER SUPPLY SYSTEM  
NUCLEAR PROJECTS NO 3&5  
REACTOR AUXILIARY BUILDING  
FLOW DIAGRAM SH-3  
PLUMBING & DRAINAGE


ESBSCO SERVICES INCORPORATED  
SCALE: NONE  
DATE: NOV 20 1977  
WPPS-3240  
G-4651  
SHEET 3 OF 4

RIDS

8303010127

