


34"

34"

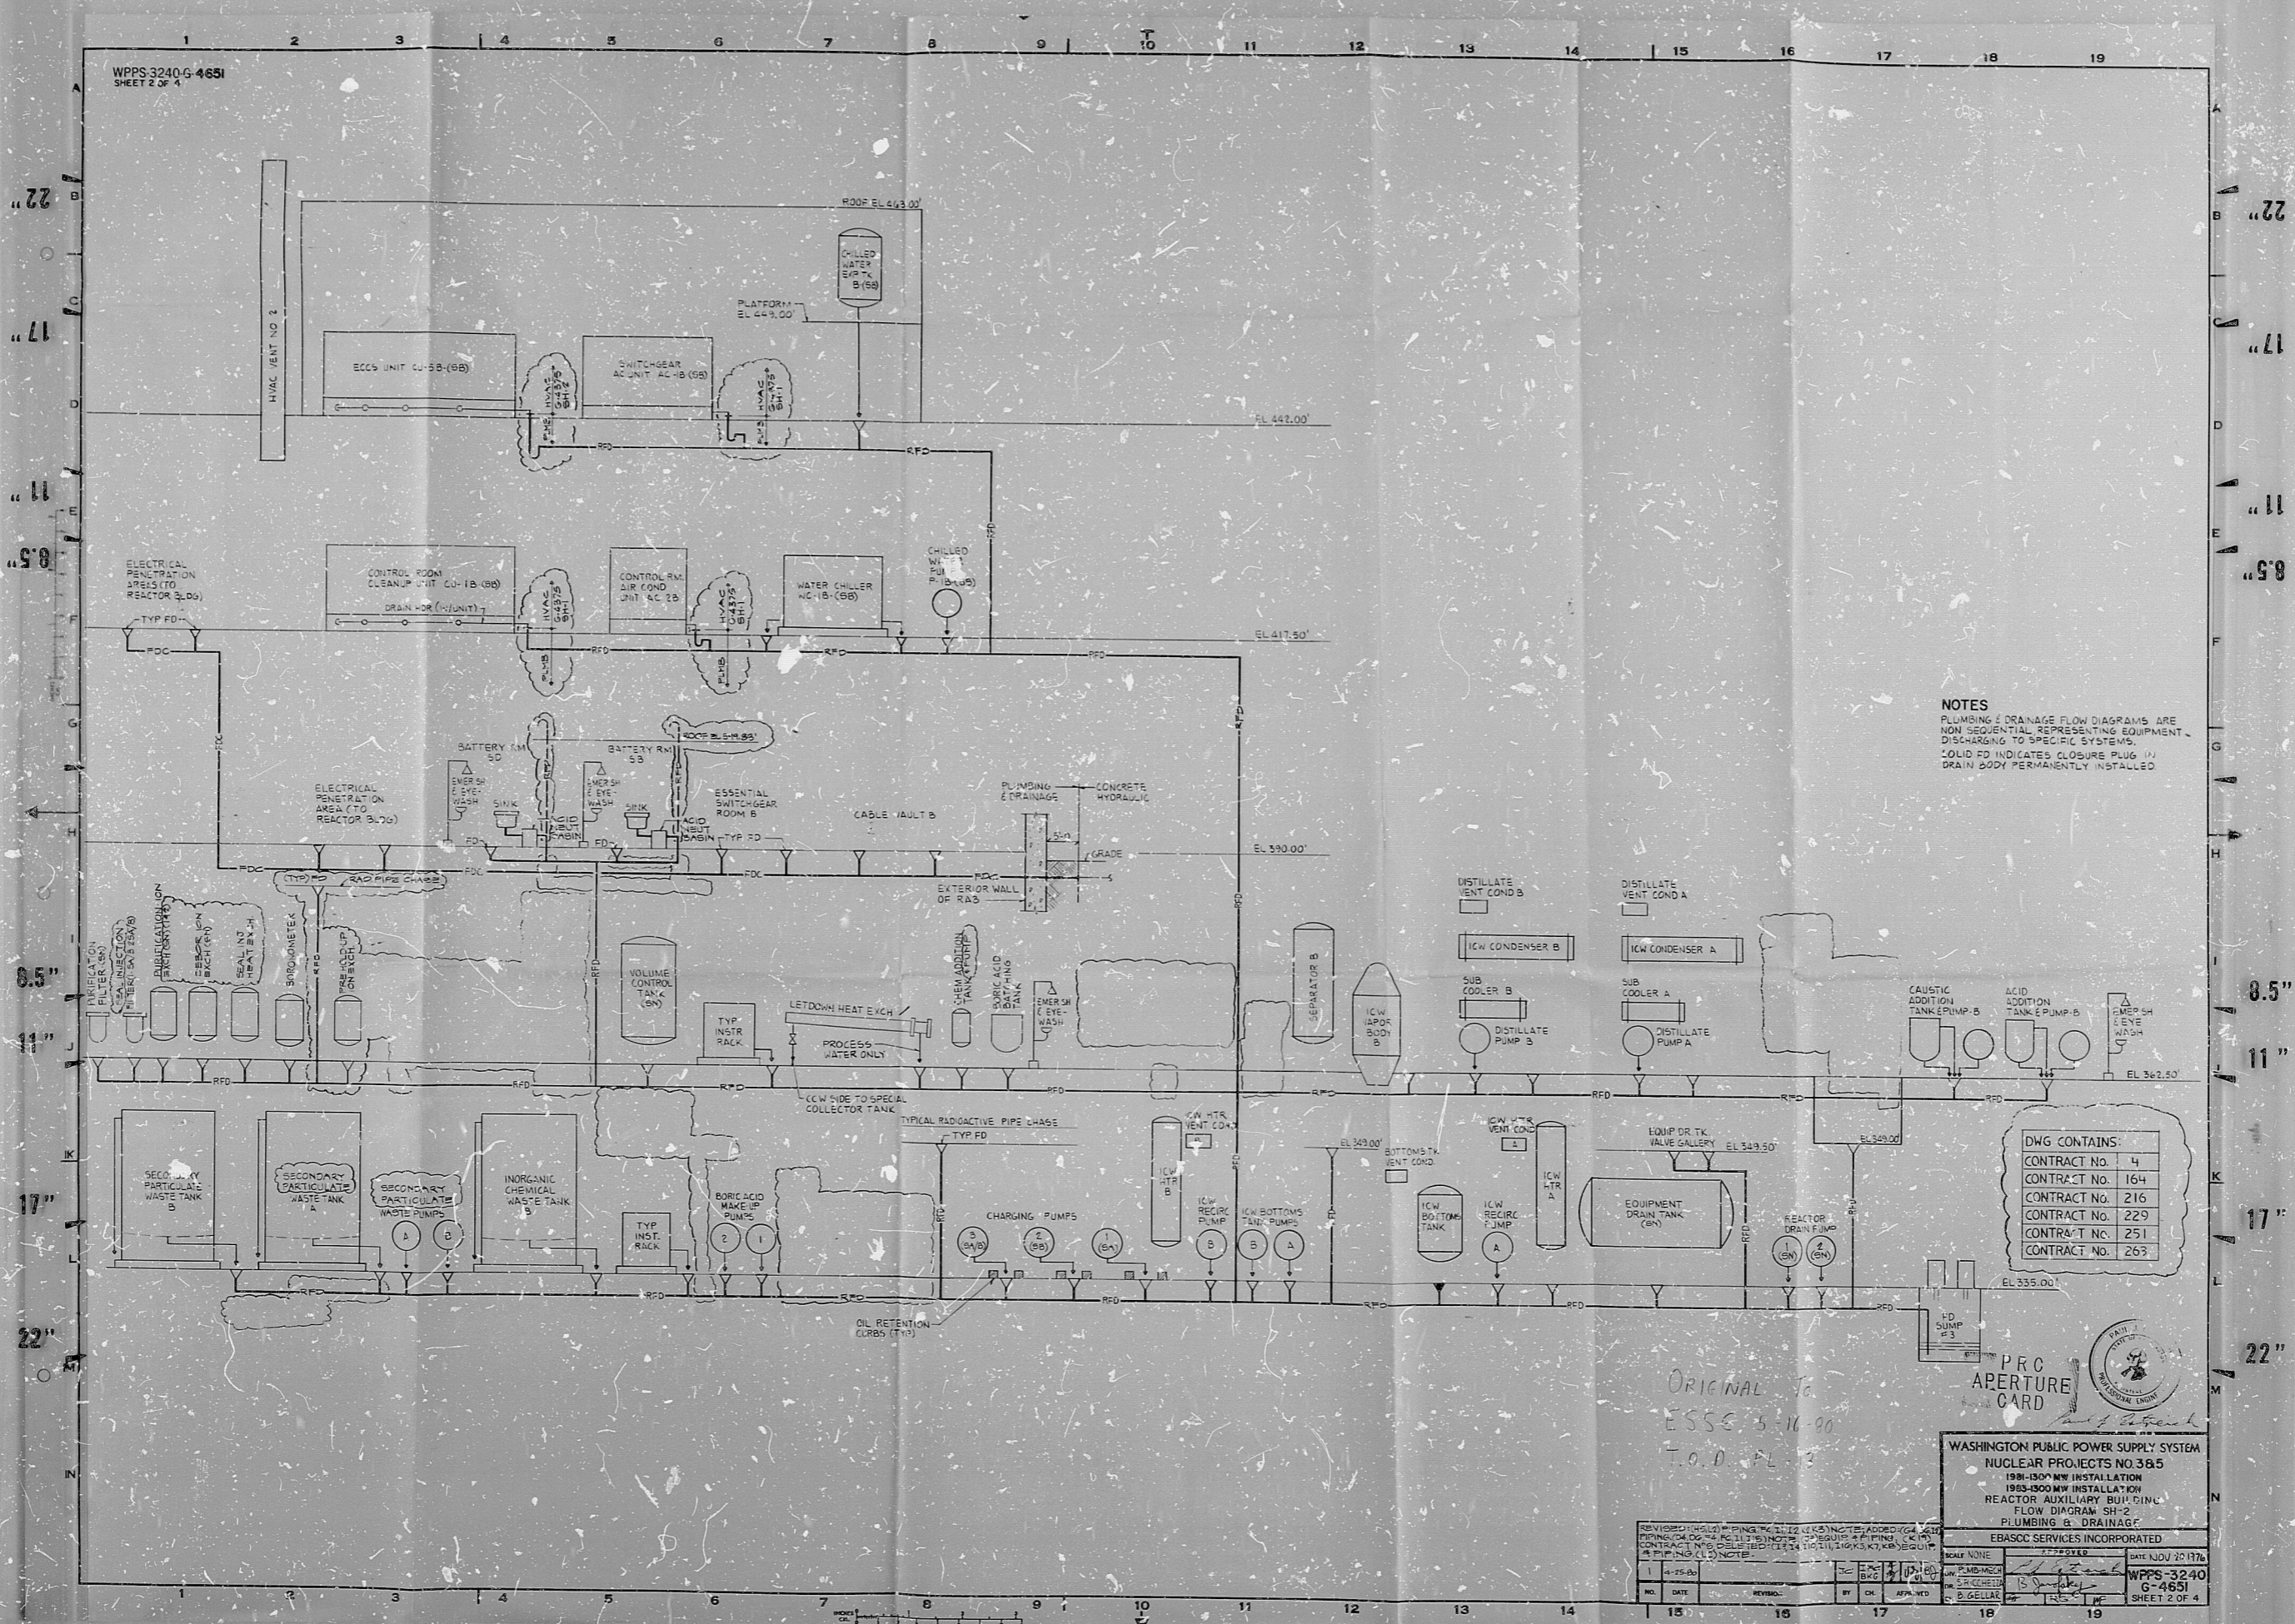

WPPS-3240-G-4651
SHEET 2 OF 4

NOTES
PLUMBING & DRAINAGE FLOW DIAGRAMS ARE NON SEQUENTIAL REPRESENTING EQUIPMENT DISCHARGING TO SPECIFIC SYSTEMS.
SOLID FD INDICATES CLOSURE PLUG IN DRAIN BODY PERMANENTLY INSTALLED

DWG CONTAINS:	
CONTRACT NO. 4	
CONTRACT NO. 164	
CONTRACT NO. 216	
CONTRACT NO. 229	
CONTRACT NO. 251	
CONTRACT NO. 263	

ORIGINAL TO
ESSE 3-16-90
T.O.D. FL-3



WASHINGTON PUBLIC POWER SUPPLY SYSTEM
REACTOR AUXILIARY BUILDING
FLOW DIAGRAM SH-2
PLUMBING & DRAINAGE

1 11-25-80	DESIGNED BY B. J. [Signature]	WPPS-3240
	CHECKED BY [Signature]	G-4651
	APPROVED BY [Signature]	SHEET 2 OF 4

34"

34"

RIDS

8303010130

