


WPPS-3240-G-455C
SHEET 1 OF 2

34"
22"
17"
11"
8.5"
11"
17"
22"
34"

34"
22"
17"
11"
8.5"
11"
17"
22"
34"

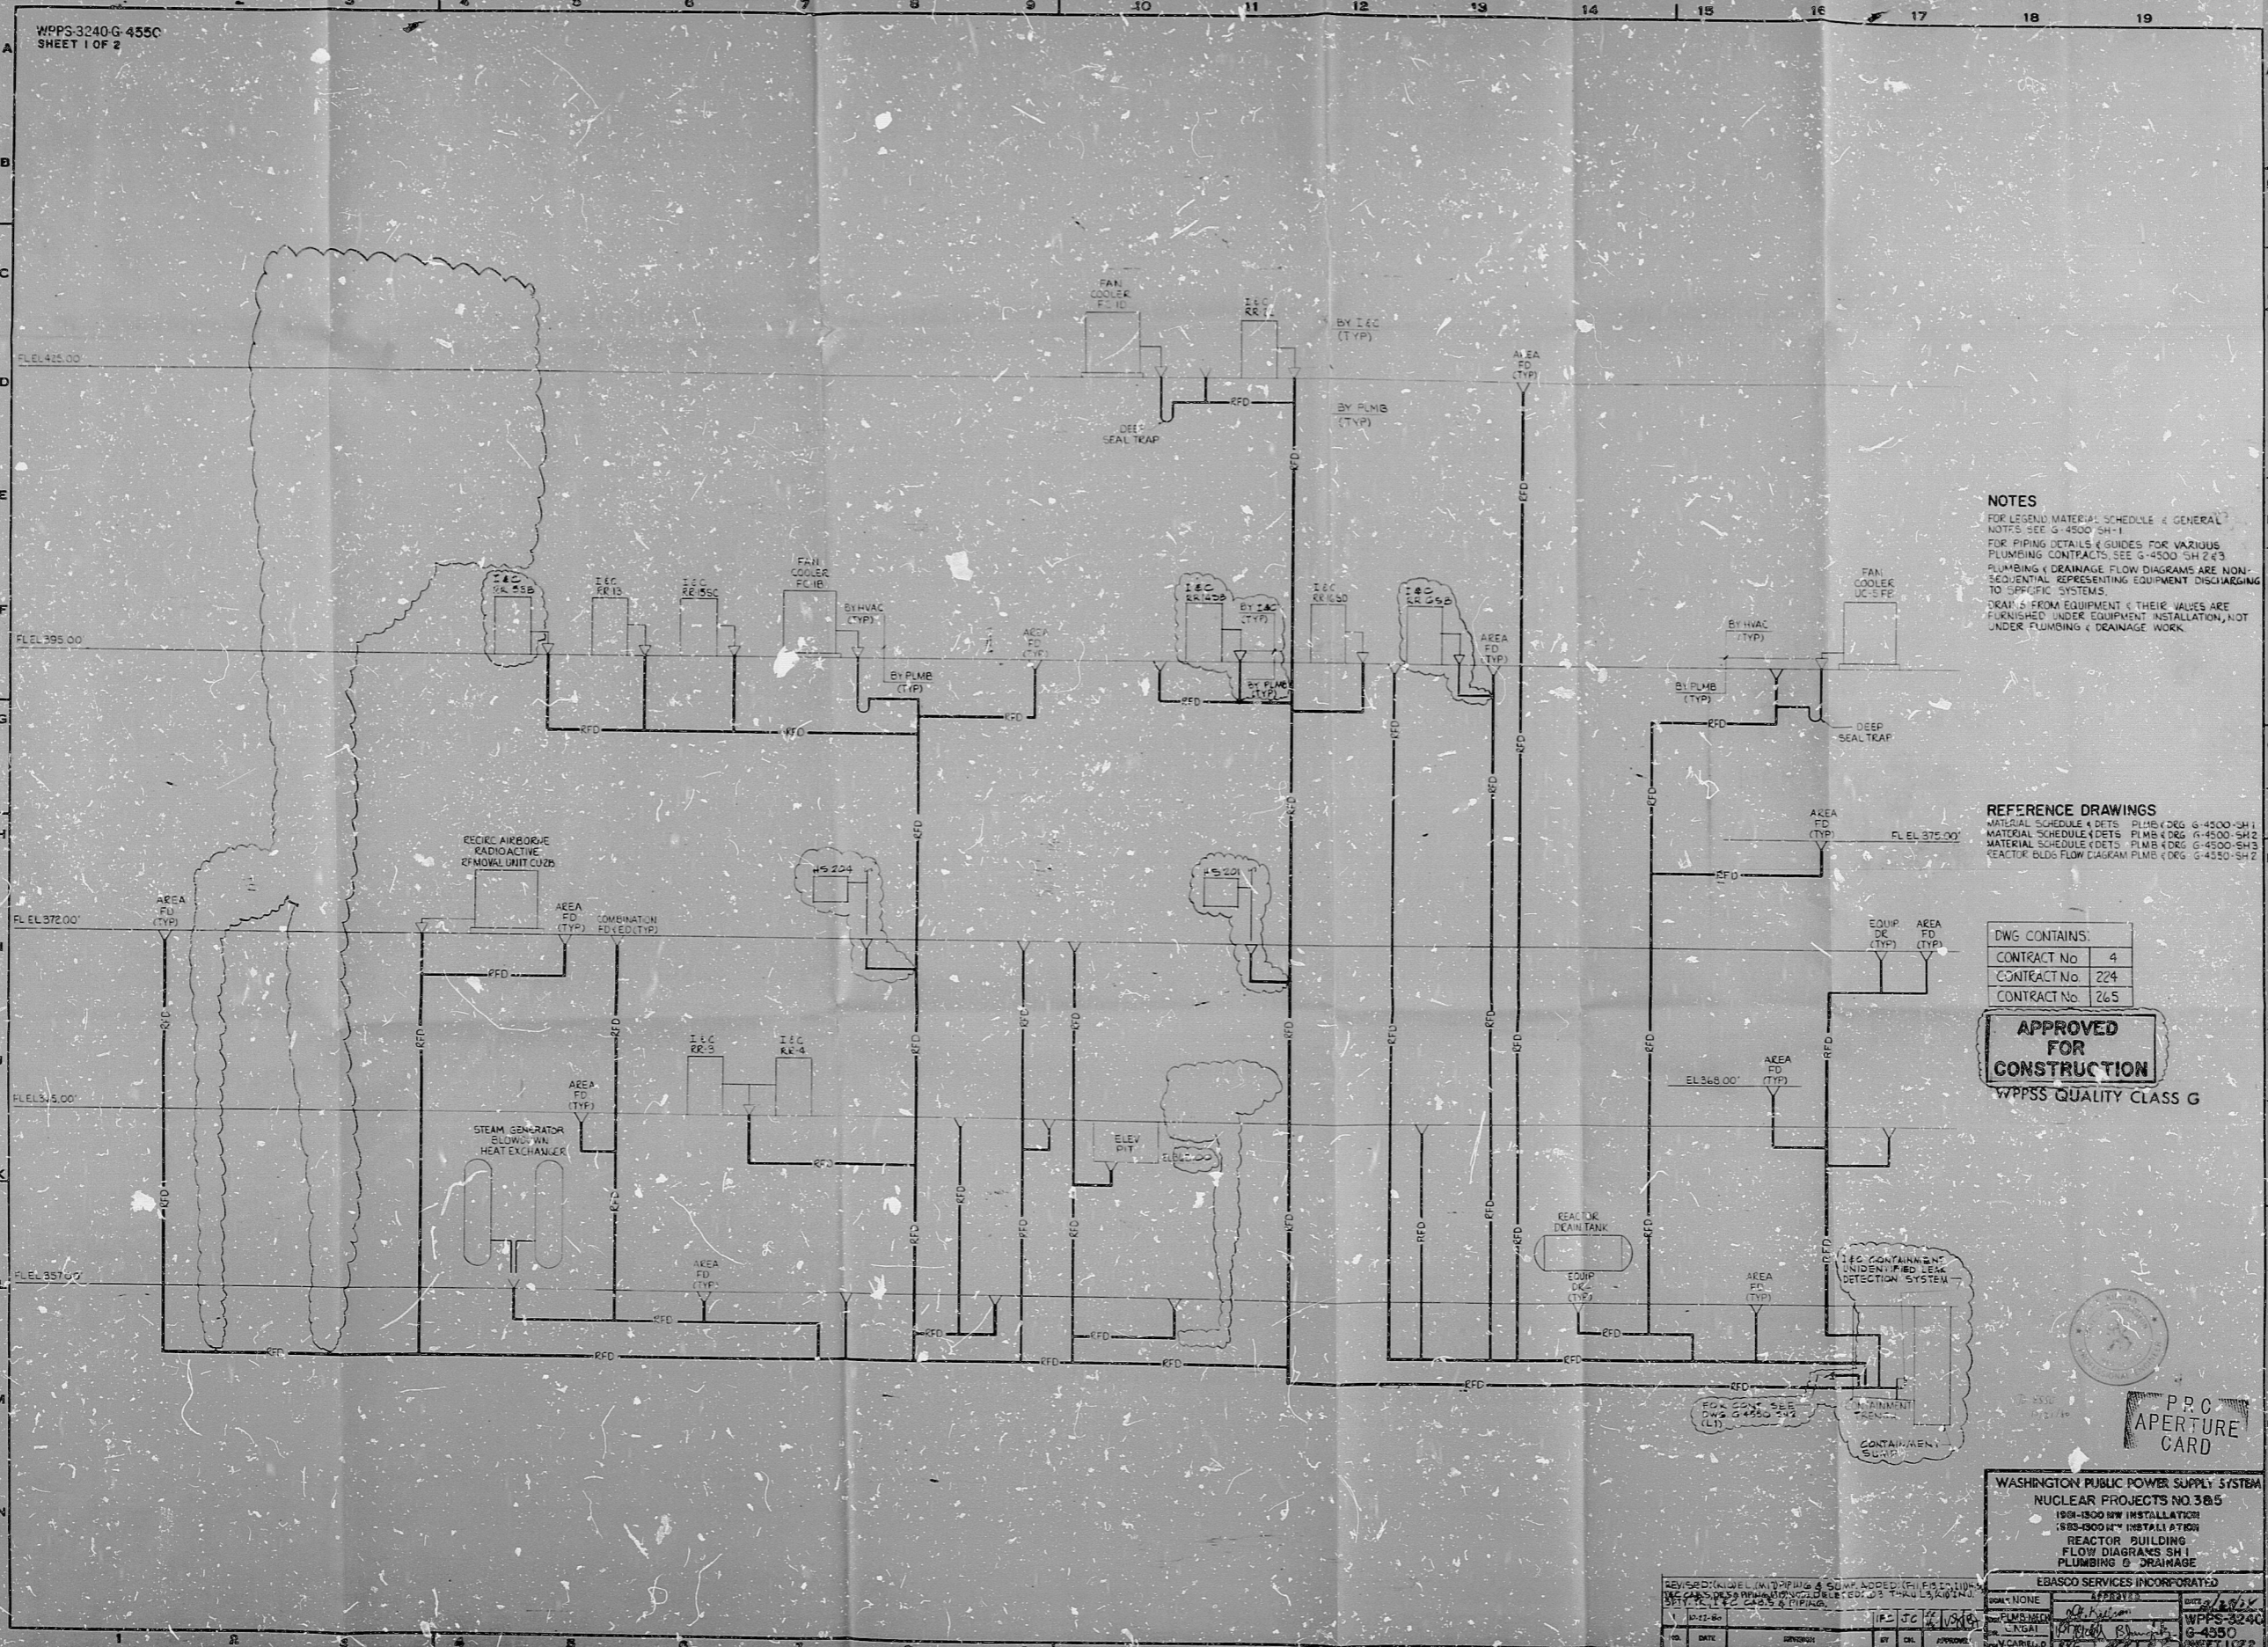


NOTES
FOR LEGEND MATERIAL SCHEDULE & GENERAL NOTES SEE G-4500-SH-1
FOR PIPING DETAILS & GUIDES FOR VARIOUS PLUMBING CONTRACTS SEE G-4500-SH-2 & 3
PLUMBING & DRAINAGE FLOW DIAGRAMS ARE NON-SCHEMATICAL REPRESENTING EQUIPMENT DISCHARGING TO SPECIFIC SYSTEMS
DRAINS FROM EQUIPMENT & THEIR VALVES ARE FURNISHED UNDER EQUIPMENT INSTALLATION, NOT UNDER PLUMBING & DRAINAGE WORK

REFERENCE DRAWINGS
MATERIAL SCHEDULE & DETS. PLMB (DRG) G-4500-SH-1
MATERIAL SCHEDULE & DETS. PLMB (DRG) G-4500-SH-2
MATERIAL SCHEDULE & DETS. PLMB (DRG) G-4500-SH-3
REACTOR BLDG FLOW DIAGRAM PLMB (DRG) G-4500-SH-2

DWG CONTAINS:	
CONTRACT No.	4
CONTRACT No.	224
CONTRACT No.	265

APPROVED FOR CONSTRUCTION
WPPSS QUALITY CLASS G

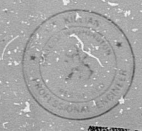

P.P.C. APERTURE CARD

WASHINGTON PUBLIC POWER SUPPLY SYSTEM
NUCLEAR PROJECTS NO. 385
1800-1800 MW INSTALLATION
1800-1800 MW INSTALLATION
REACTOR BUILDING
FLOW DIAGRAMS SH-1
PLUMBING & DRAINAGE

EASCO SERVICES INCORPORATED	

RIDS

8303910143

