

34"

34"

22"

22"

17"

17"

11"

11"

8.5"

8.5"

11"

11"

8.5"

8.5"

17"

17"

22"

22"

17"

17"

22"


22"

17"

17"

34"

34"

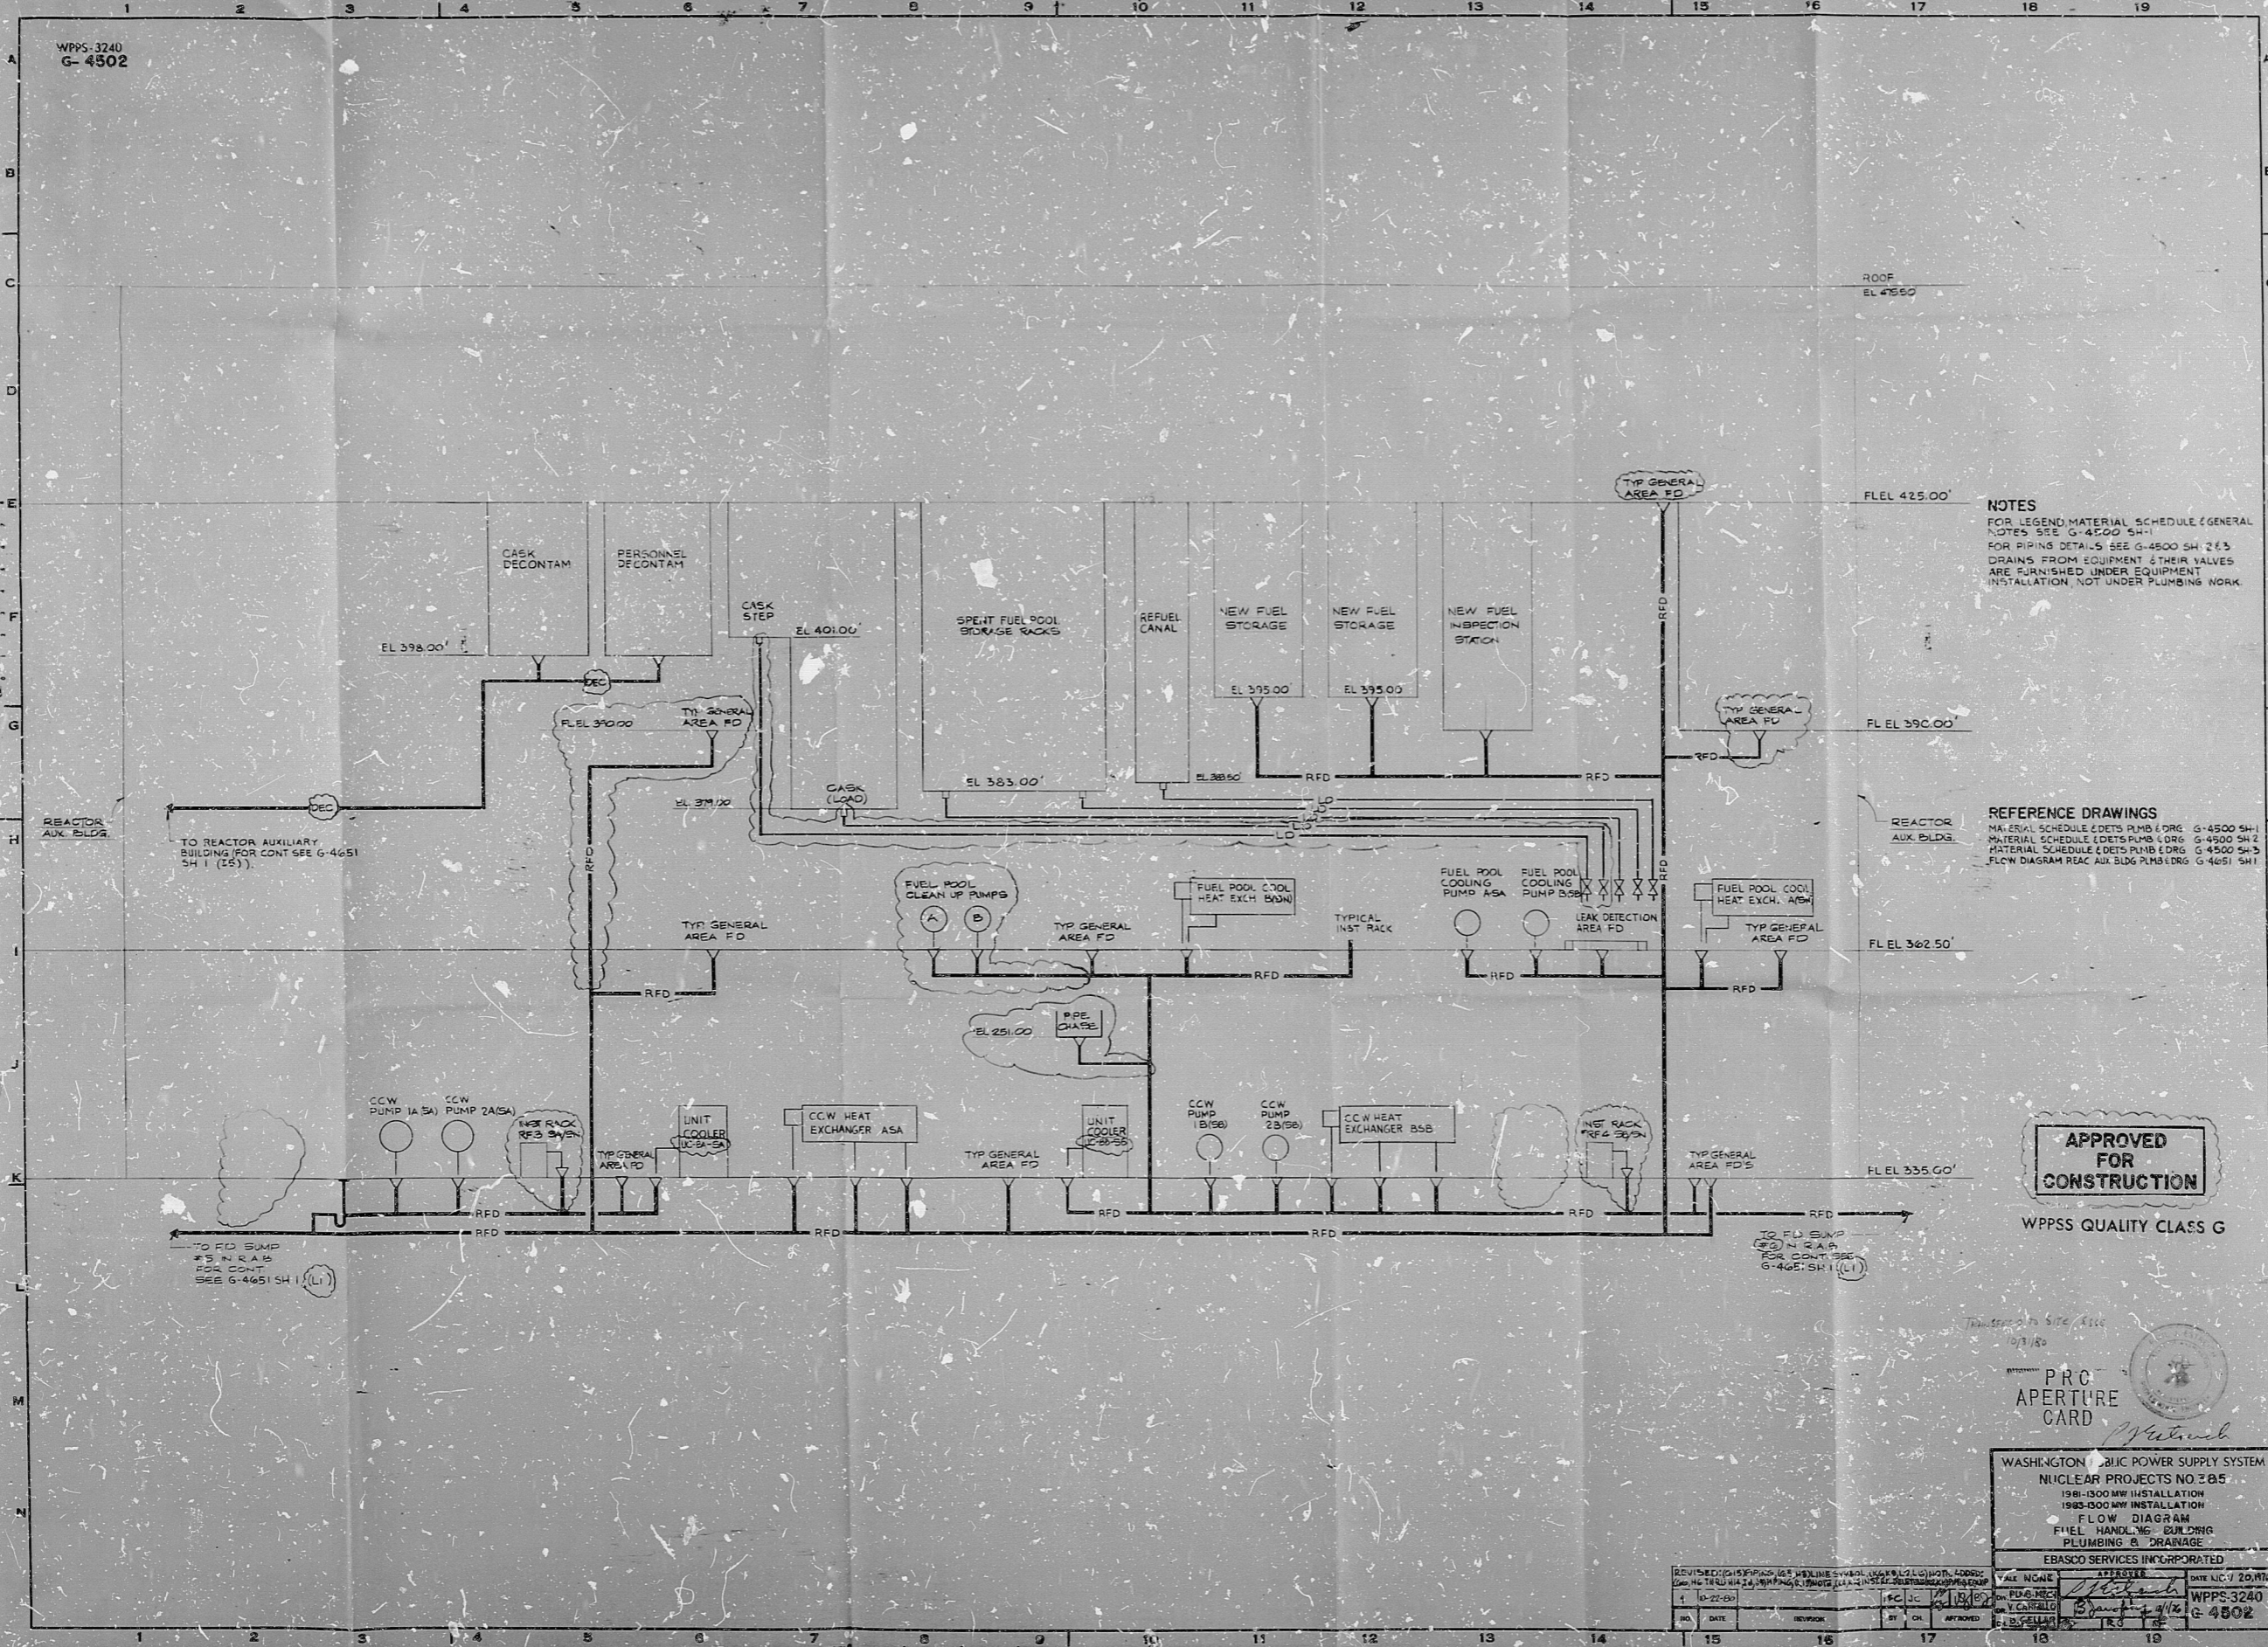

NOTES
 FOR LEGEND MATERIAL SCHEDULE & GENERAL NOTES SEE G-4500 SH-1
 FOR PIPING DETAILS SEE G-4500 SH-2 & 3
 DRAINS FROM EQUIPMENT & THEIR VALVES ARE FURNISHED UNDER EQUIPMENT INSTALLATION, NOT UNDER PLUMBING WORK

REFERENCE DRAWINGS
 MATERIAL SCHEDULE & DETS PLMB & DRG G-4500 SH-1
 MATERIAL SCHEDULE & DETS PLMB & DRG G-4500 SH-2
 MATERIAL SCHEDULE & DETS PLMB & DRG G-4500 SH-3
 FLOW DIAGRAM REAC AUX BLDG PLMB & DRG G-4651 SH-1

APPROVED FOR CONSTRUCTION
 WPPSS QUALITY CLASS G

PRO APERTURE CARD
 WASHINGTON PUBLIC POWER SUPPLY SYSTEM
 NUCLEAR PROJECTS NO. 2 & 5
 1981-1900 MW INSTALLATION
 1983-1900 MW INSTALLATION
 FLOW DIAGRAM
 FUEL HANDLING BUILDING
 PLUMBING & DRAINAGE
 EBASCO SERVICES INCORPORATED

REVISED	DATE	BY	CHKD	APPROVED	DATE	BY
1	10-22-80	JC	JC	JC	10/22/80	JC
2						
3						
RIDS

8303010146

