


34

34

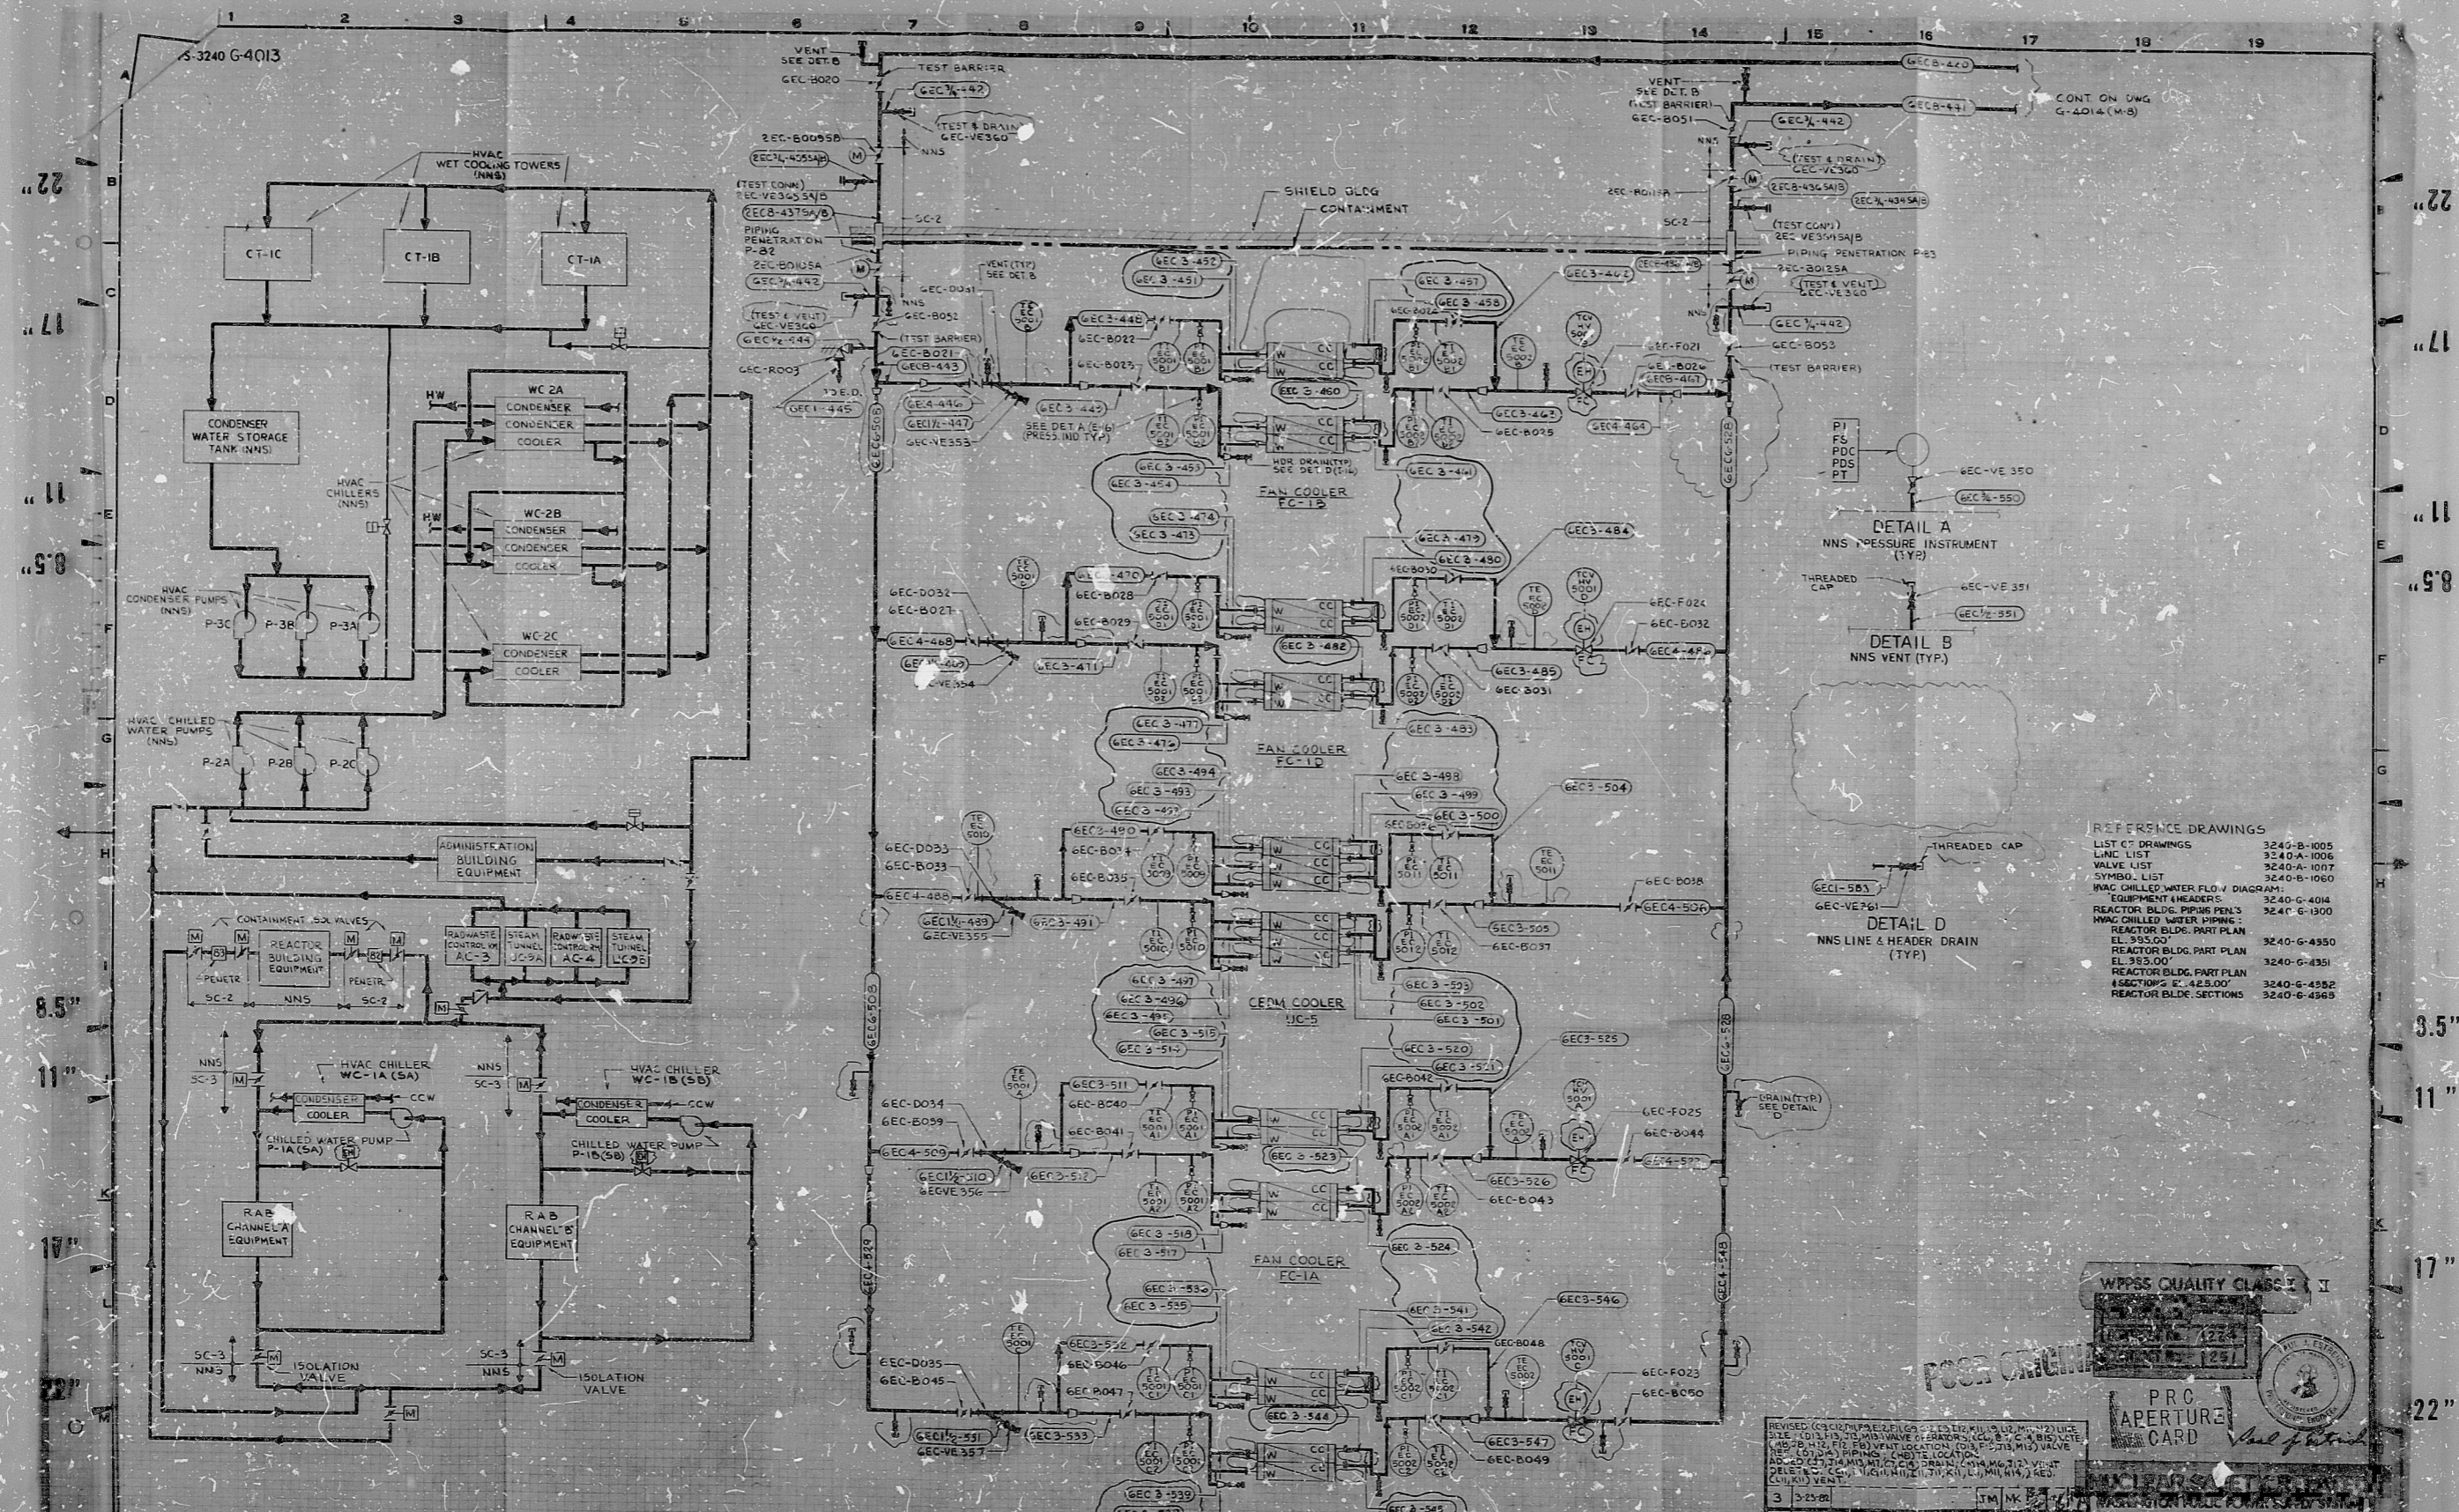

22

22

17

17

11

11



8.5

8.5

11

11

17

17

22

22

27

27


34

34

HVAC CHILLED WATER SYSTEM (KEY DIAGRAM)

REACTOR BUILDING BRANCH

- REFERENCE DRAWINGS
- LIST OF DRAWINGS 3240-B-1005
  - LINE LIST 3240-A-1006
  - VALVE LIST 3240-A-1017
  - SYMBOL LIST 3240-B-1050
  - EQUIPMENT HEADERS 3240-G-404
  - REACTOR BLDG. PIPING PEN'S 3240-G-1300
  - REACTOR BLDG. PART PLAN EL. 383.00' 3240-G-4351
  - REACTOR BLDG. PART PLAN SECTIONS E' & E3.00' 3240-G-4352
  - REACTOR BLDG. SECTIONS 3240-G-4353

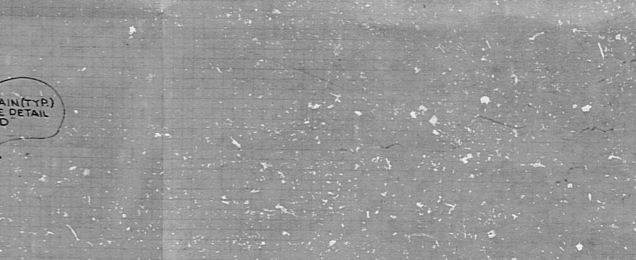

WPPSS QUALITY CLASS 1


PRC APERTURE CARD

REVISIONS

3	3/25/81	JTM	OK
2	11/27/78	PL	OK

NUCLEAR PROJECTS DIVISION  
NVA-C  
CHILLED WATER FLOW PROGRAM



RIDS

8303010150

