



WPPS-3240 G-6406

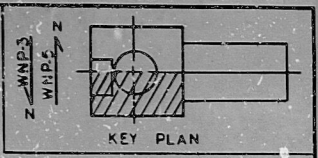

MATCH LINE - CONT. ON DWG G-6405

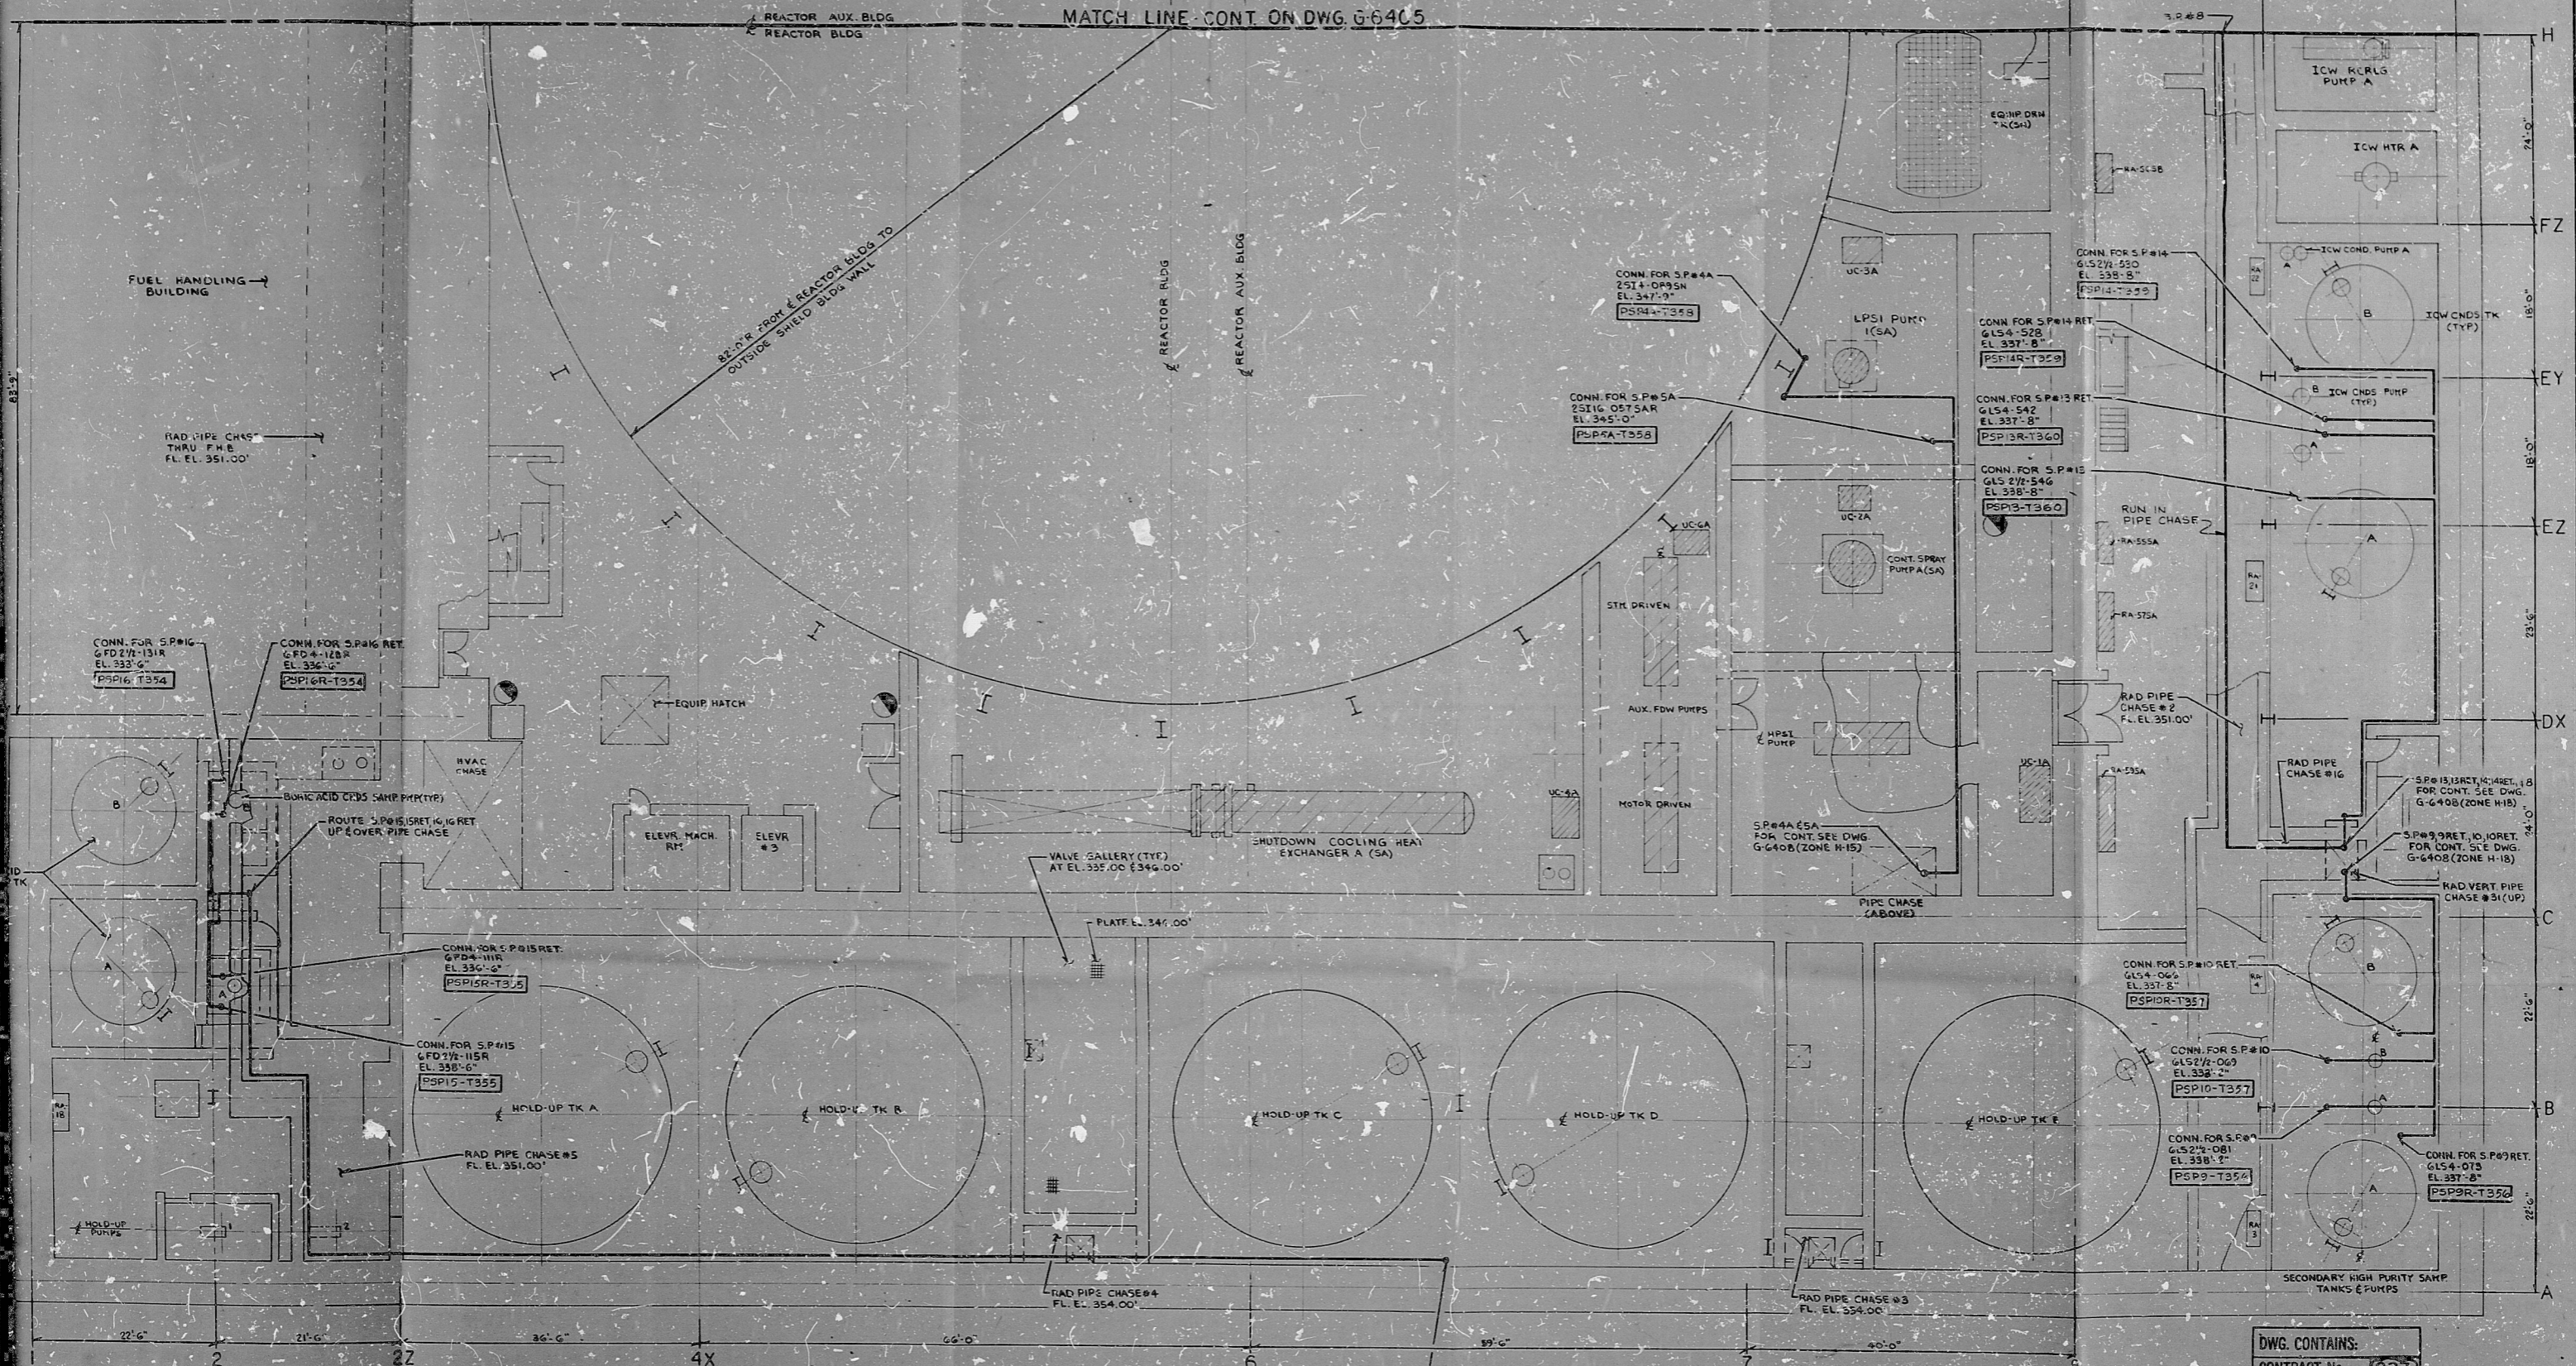

PLAN AT EL. 335.00'

APPROVED FOR CONSTRUCTION

DWG. CONTAINS:  
CONTRACT No. 227  
CONTRACT No.

NOTE:  
FOR GENERAL NOTES, SYMBOLS & REFERENCES SEE DWG. NO. D-6087.

WPPSS QUALITY CLASS I-II



NUCLEAR SAFETY RELATED

WASHINGTON PUBLIC POWER SUPPLY SYSTEM  
NUCLEAR PROJECTS NO. 385  
REACTOR AUXILIARY BUILDING  
PLAN AT ELEV. 335.00'  
SAMPLING SYSTEM ARHG7

PRO APERTURE CARD

ALL DETAILS SHOWN ON THIS DRAWING WITHIN THE SCOPE OF THE CONTRACT SHALL BE INCLUDED IN THE CONTRACT.

REVISED - CONTRACT NO. 19 AS PER DCN-10-1  
ADDED A.F.C. APPLICATION (M-12)

RIDS

8303010173

