
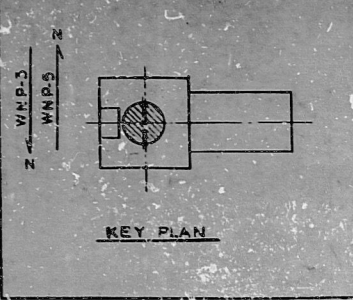


6-3240-G-6401

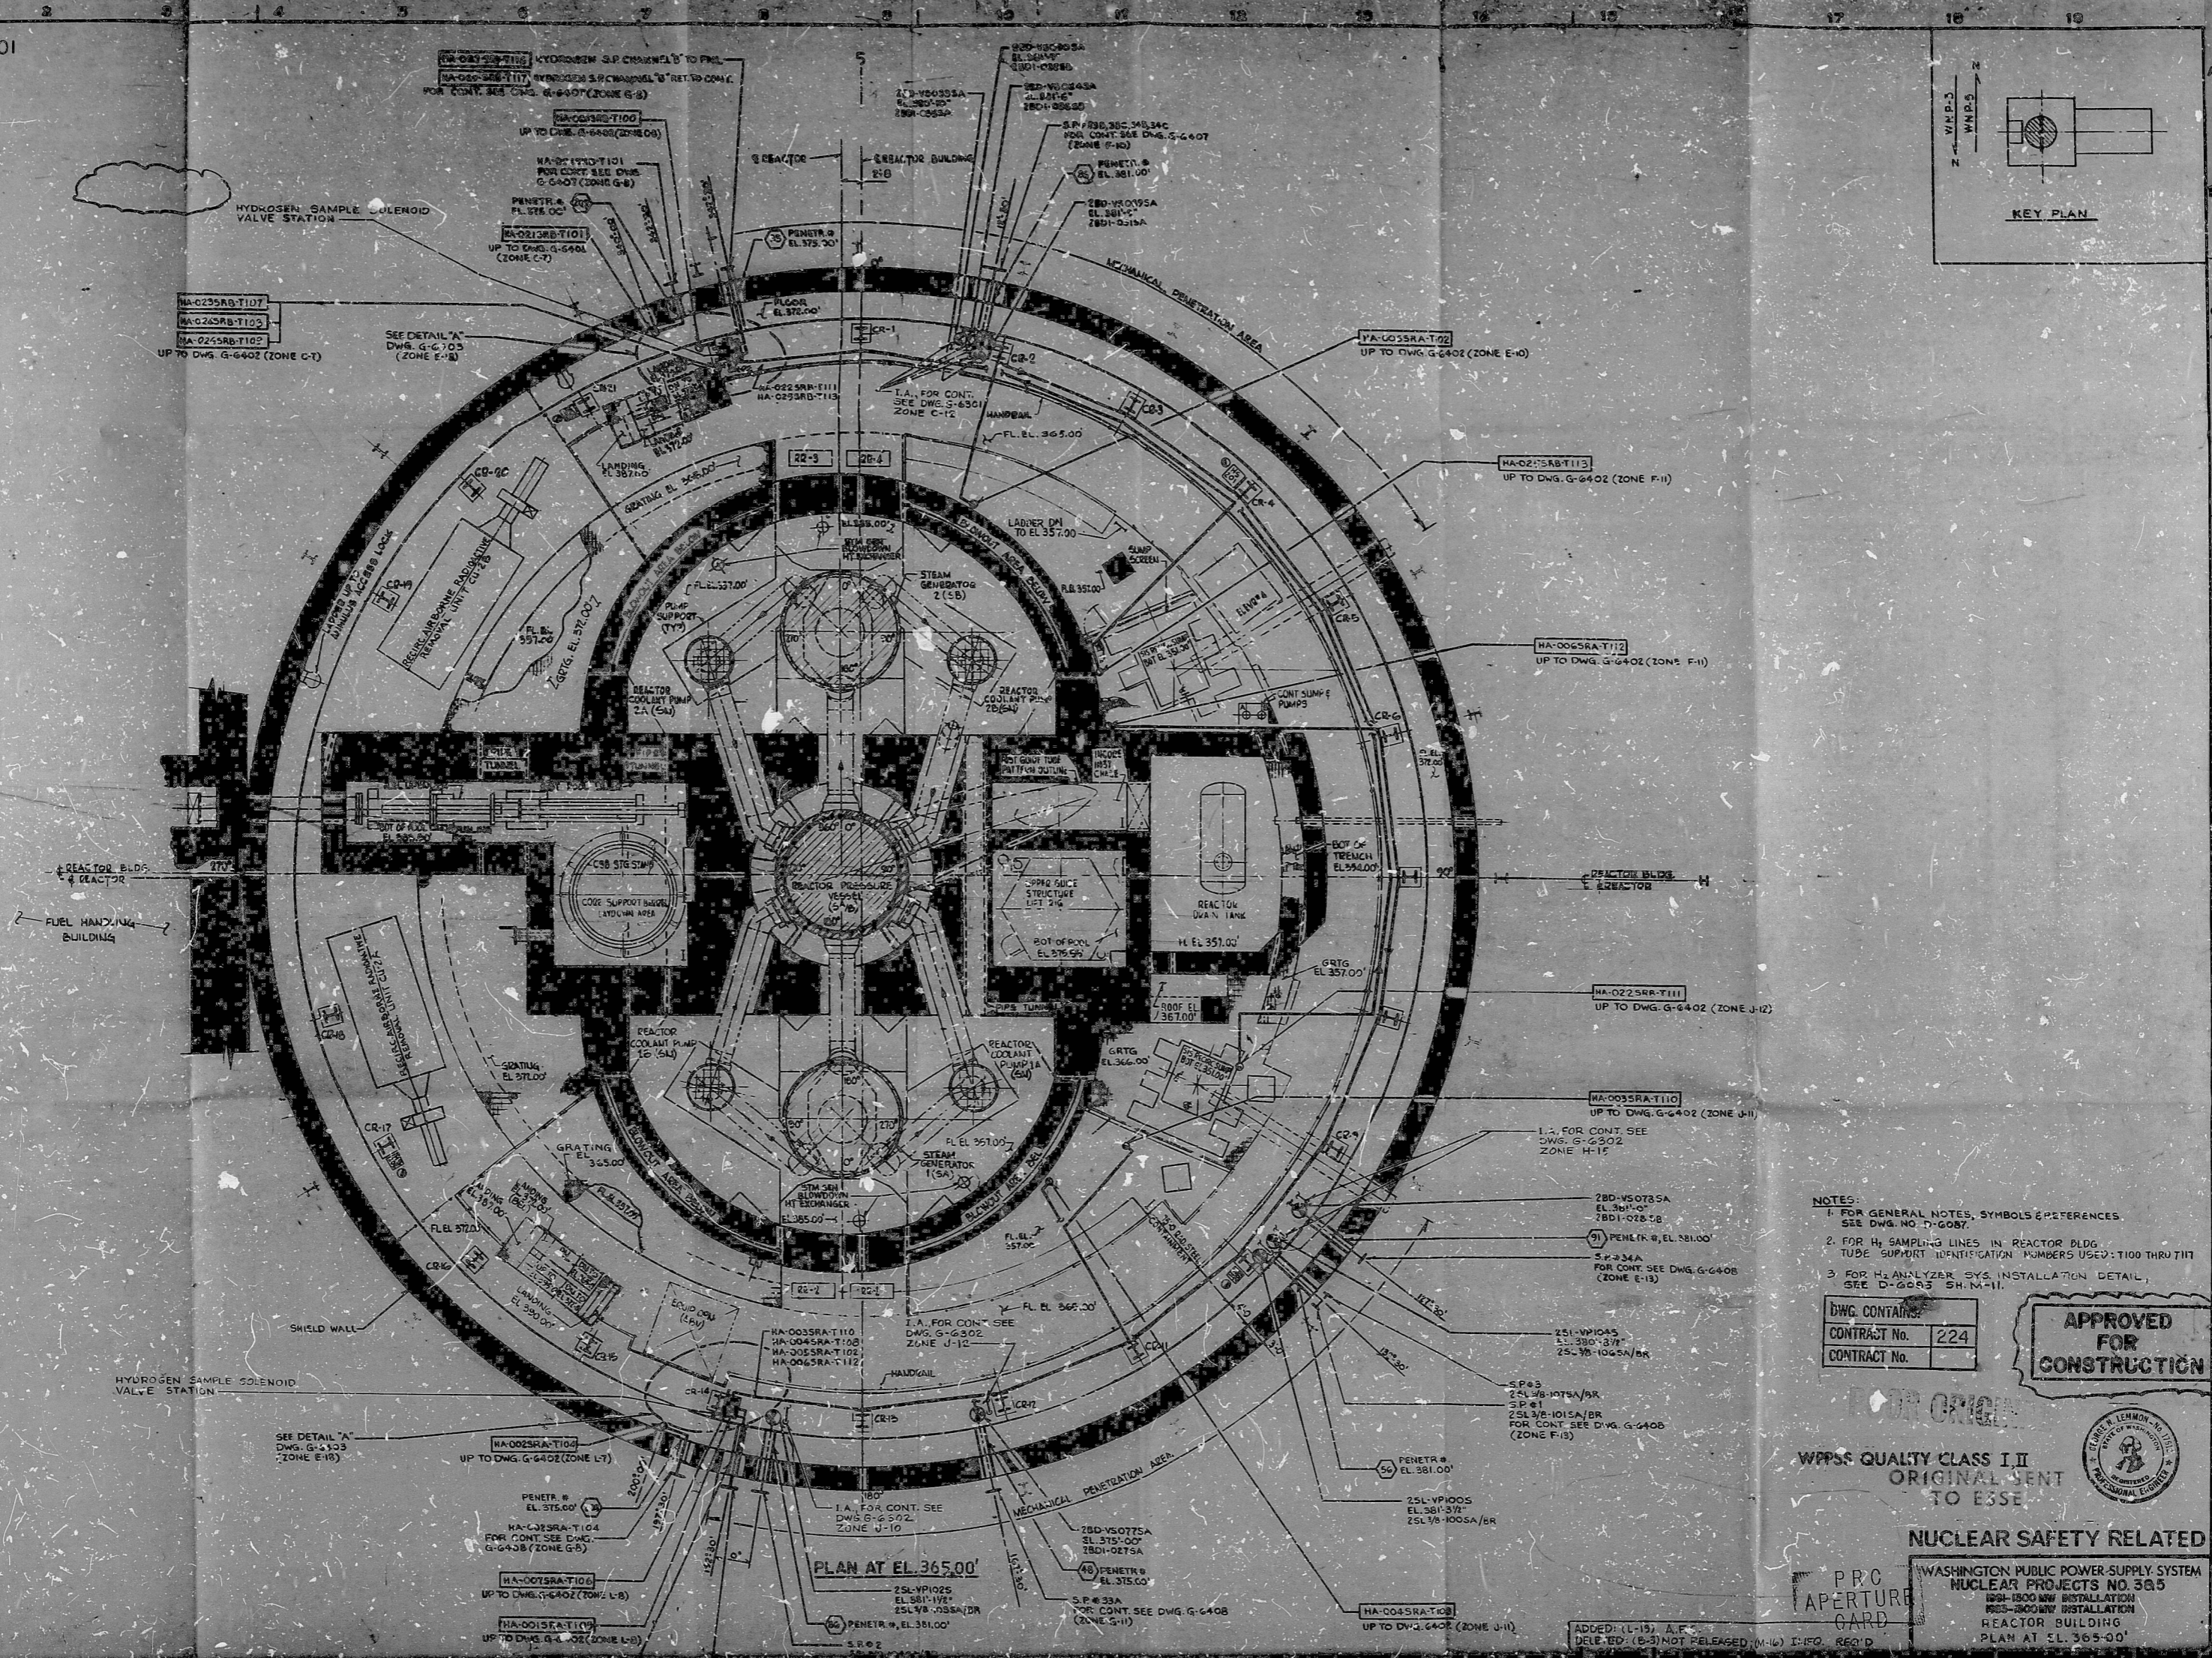

- NOTES:
- FOR GENERAL NOTES, SYMBOLS & PREFERENCES, SEE DWG. NO. D-6087.
  - FOR H<sub>2</sub> SAMPLING LINES IN REACTOR BLDG. TUBE SUPPORT IDENTIFICATION NUMBERS USED: T100 THRU T117.
  - FOR H<sub>2</sub> ANALYZER SYS. INSTALLATION DETAIL, SEE D-6085 SH.M-11.

DWG. CONTAINS:	
CONTRACT No.	224
CONTRACT No.	

**APPROVED FOR CONSTRUCTION**



WPPSS QUALITY CLASS II ORIGINAL SENT TO ESSE

**NUCLEAR SAFETY RELATED**

PRO APERTURE GARD

WASHINGTON PUBLIC POWER SUPPLY SYSTEM  
 NUCLEAR PROJECTS NO. 385  
 REACTOR BUILDING  
 PLAN AT EL. 365.00'

ADDED: (L-15) A.F.  
 DELETED: (B-3) NOT RELEASED, (M-16) INFO. REQ'D

RIDS

8303010176

