


WPPS-3240-G-6341

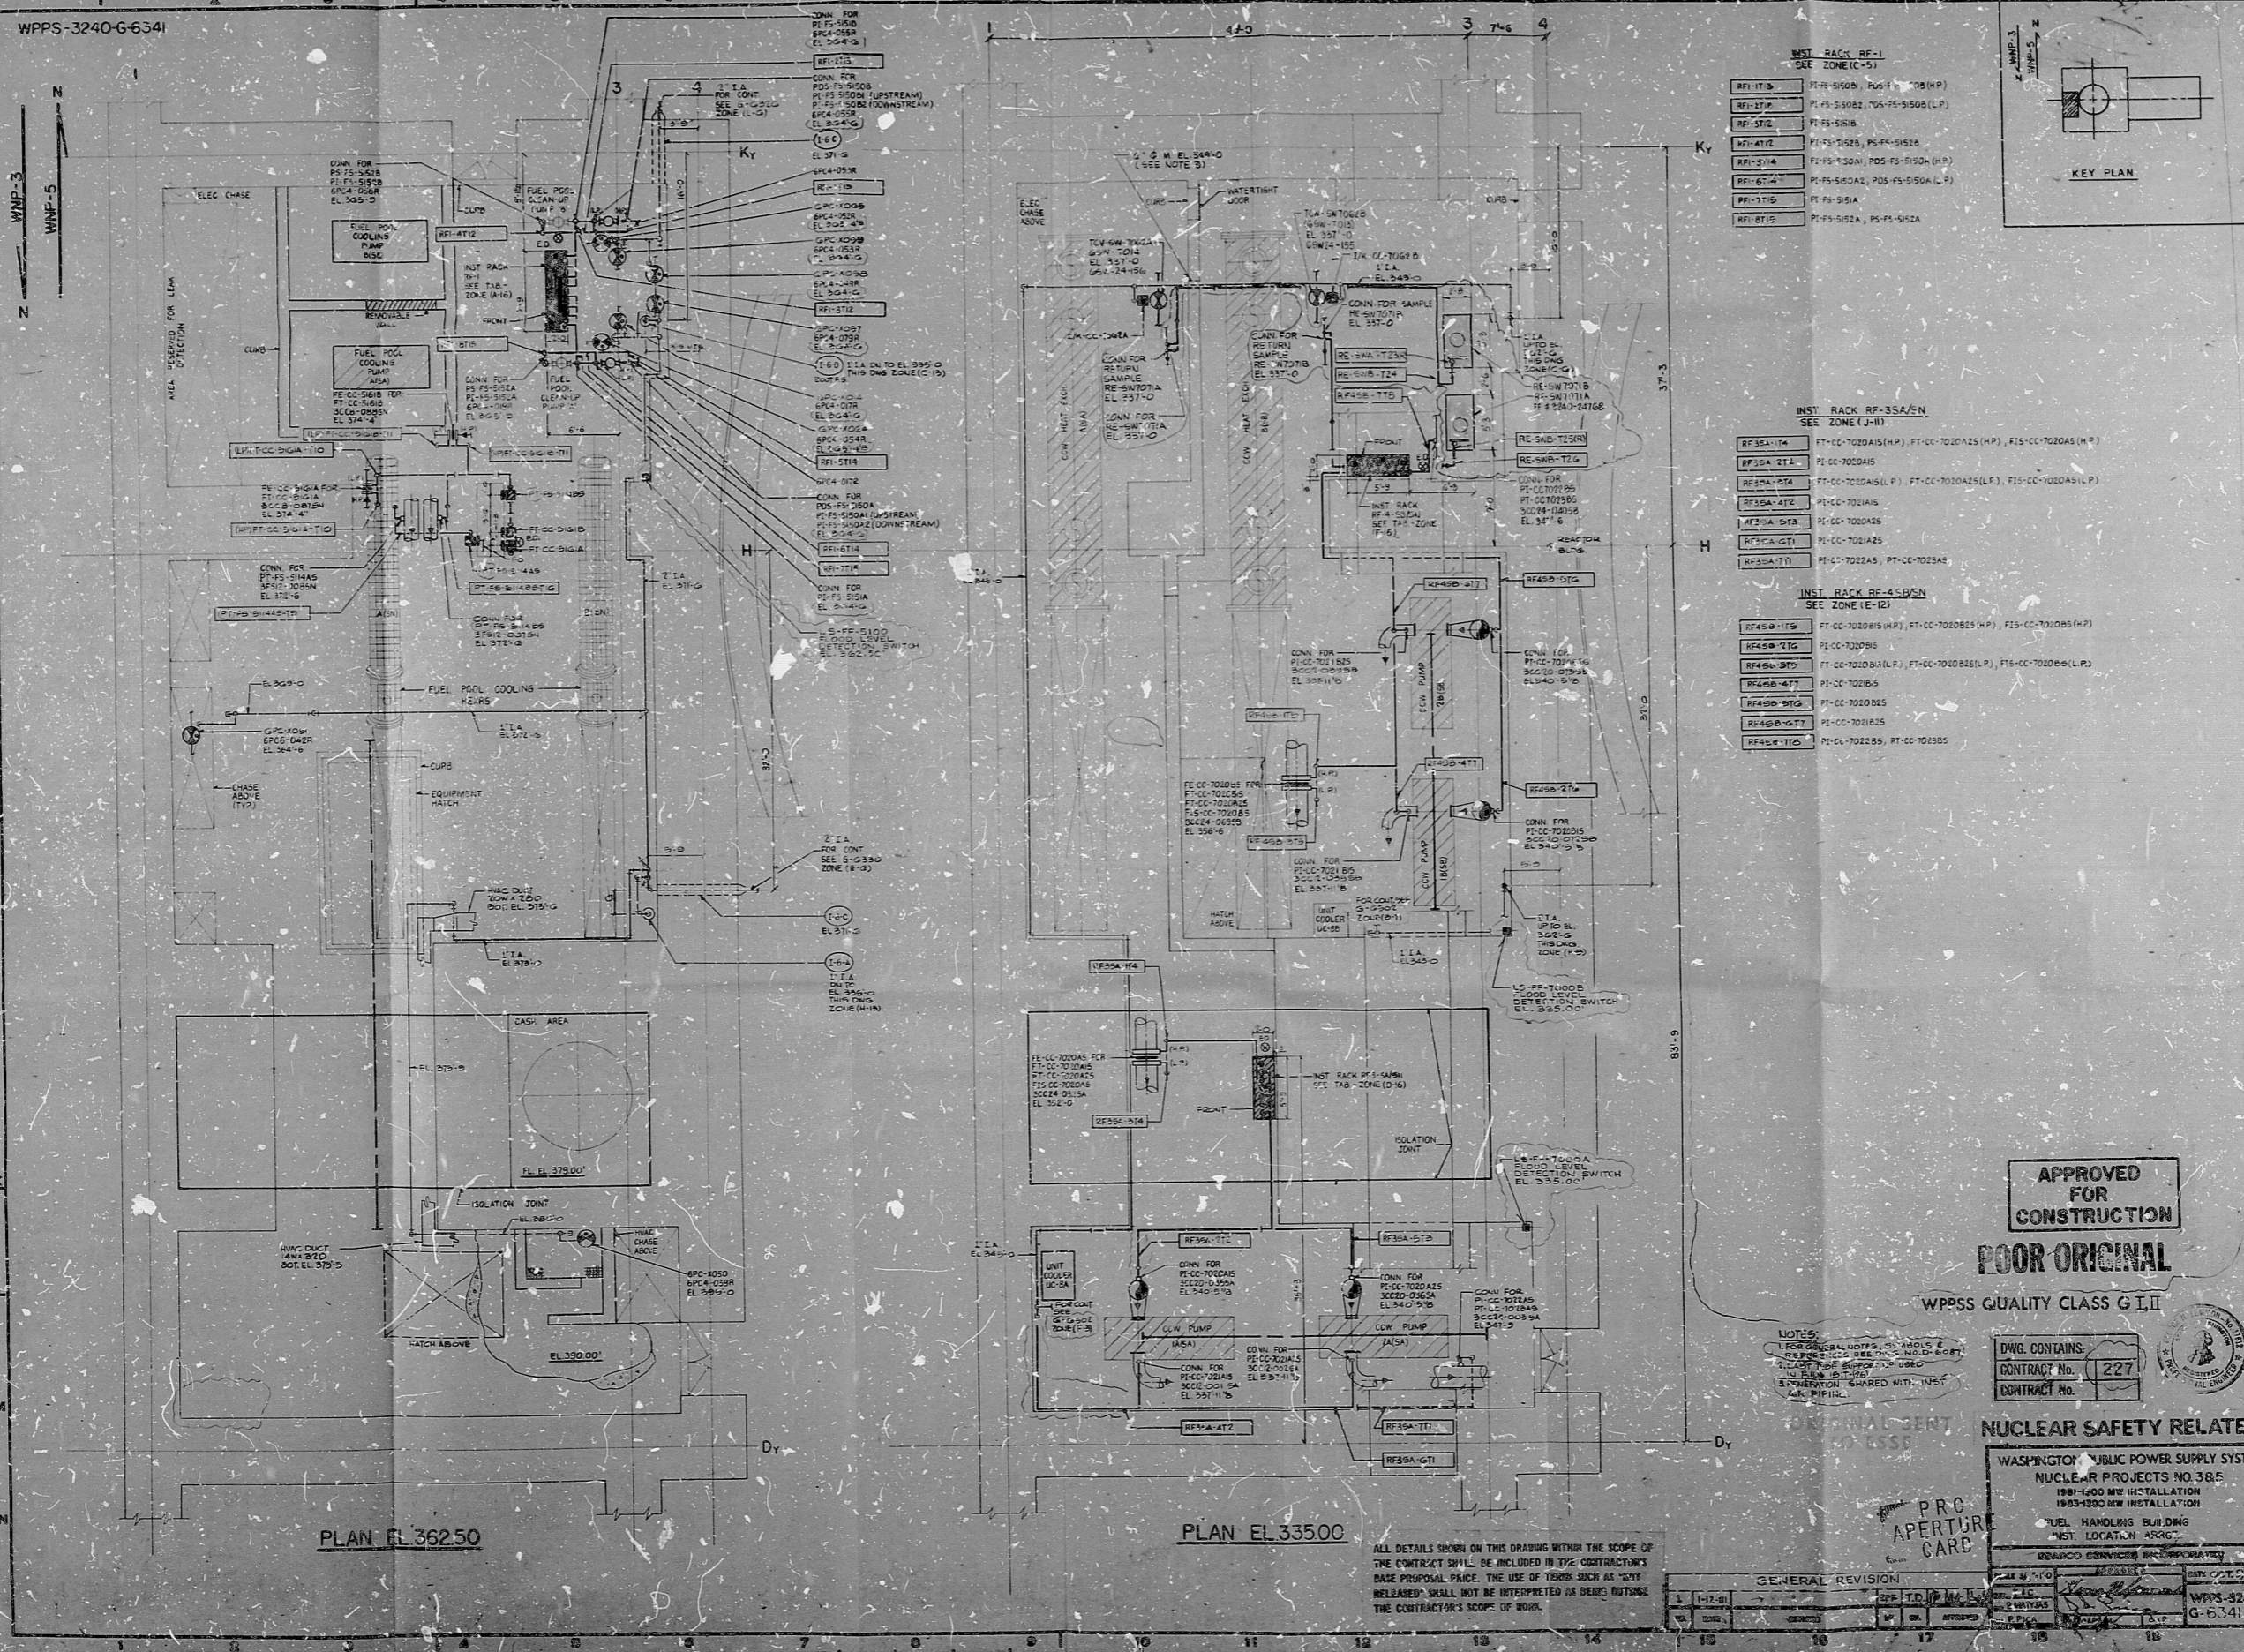

PLAN EL 36250

PLAN EL 33500

INST RACK RF-1
SEE ZONE (C-3)



INST RACK RF-33A/N
SEE ZONE (J-1)

RF-33A-T1	RF-CC-7020A15 (HP), RF-CC-7020A25 (HP), FIS-CC-7020A5 (HP)
RF-33A-T2	RF-CC-7020A5
RF-33A-T3	RF-CC-7020A5 (LP), RF-CC-7020A25 (LP), FIS-CC-7020A5 (LP)

INST RACK RF-41B/N
SEE ZONE (E-12)

RF-41B-T1	RF-CC-7020B15 (HP), RF-CC-7020B25 (HP), FIS-CC-7020B5 (HP)
RF-41B-T2	RF-CC-7020B5
RF-41B-T3	RF-CC-7020B15 (LP), RF-CC-7020B25 (LP), FIS-CC-7020B5 (LP)

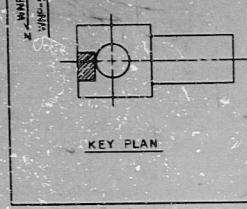

APPROVED FOR CONSTRUCTION
POOR ORIGINAL

WPPSS QUALITY CLASS G II

DWG. CONTAINS
CONTRACT No. 227
CONTRACT No.

NUCLEAR SAFETY RELATED

WASHINGTON PUBLIC POWER SUPPLY SYSTEM
NUCLEAR PROJECTS NO. 38.5
FUEL HANDLING BUILDING
INST. LOCATION AREA

PRC APERTURE CARD

ALL DETAILS SHOWN ON THIS DRAWING WITHIN THE SCOPE OF THE CONTRACT SHALL BE INCLUDED IN THE CONTRACTOR'S BASE PROPOSAL PRICE. THE USE OF TERMS SUCH AS "NOT RELEASED" SHALL NOT BE INTERPRETED AS BEING OUTSIDE THE CONTRACTOR'S SCOPE OF WORK.

GENERAL REVISION

NO.	DATE	DESCRIPTION	BY	APP'D
1	11-1-81			
2	11-1-81			
RIDS

8303010182

