


34

34

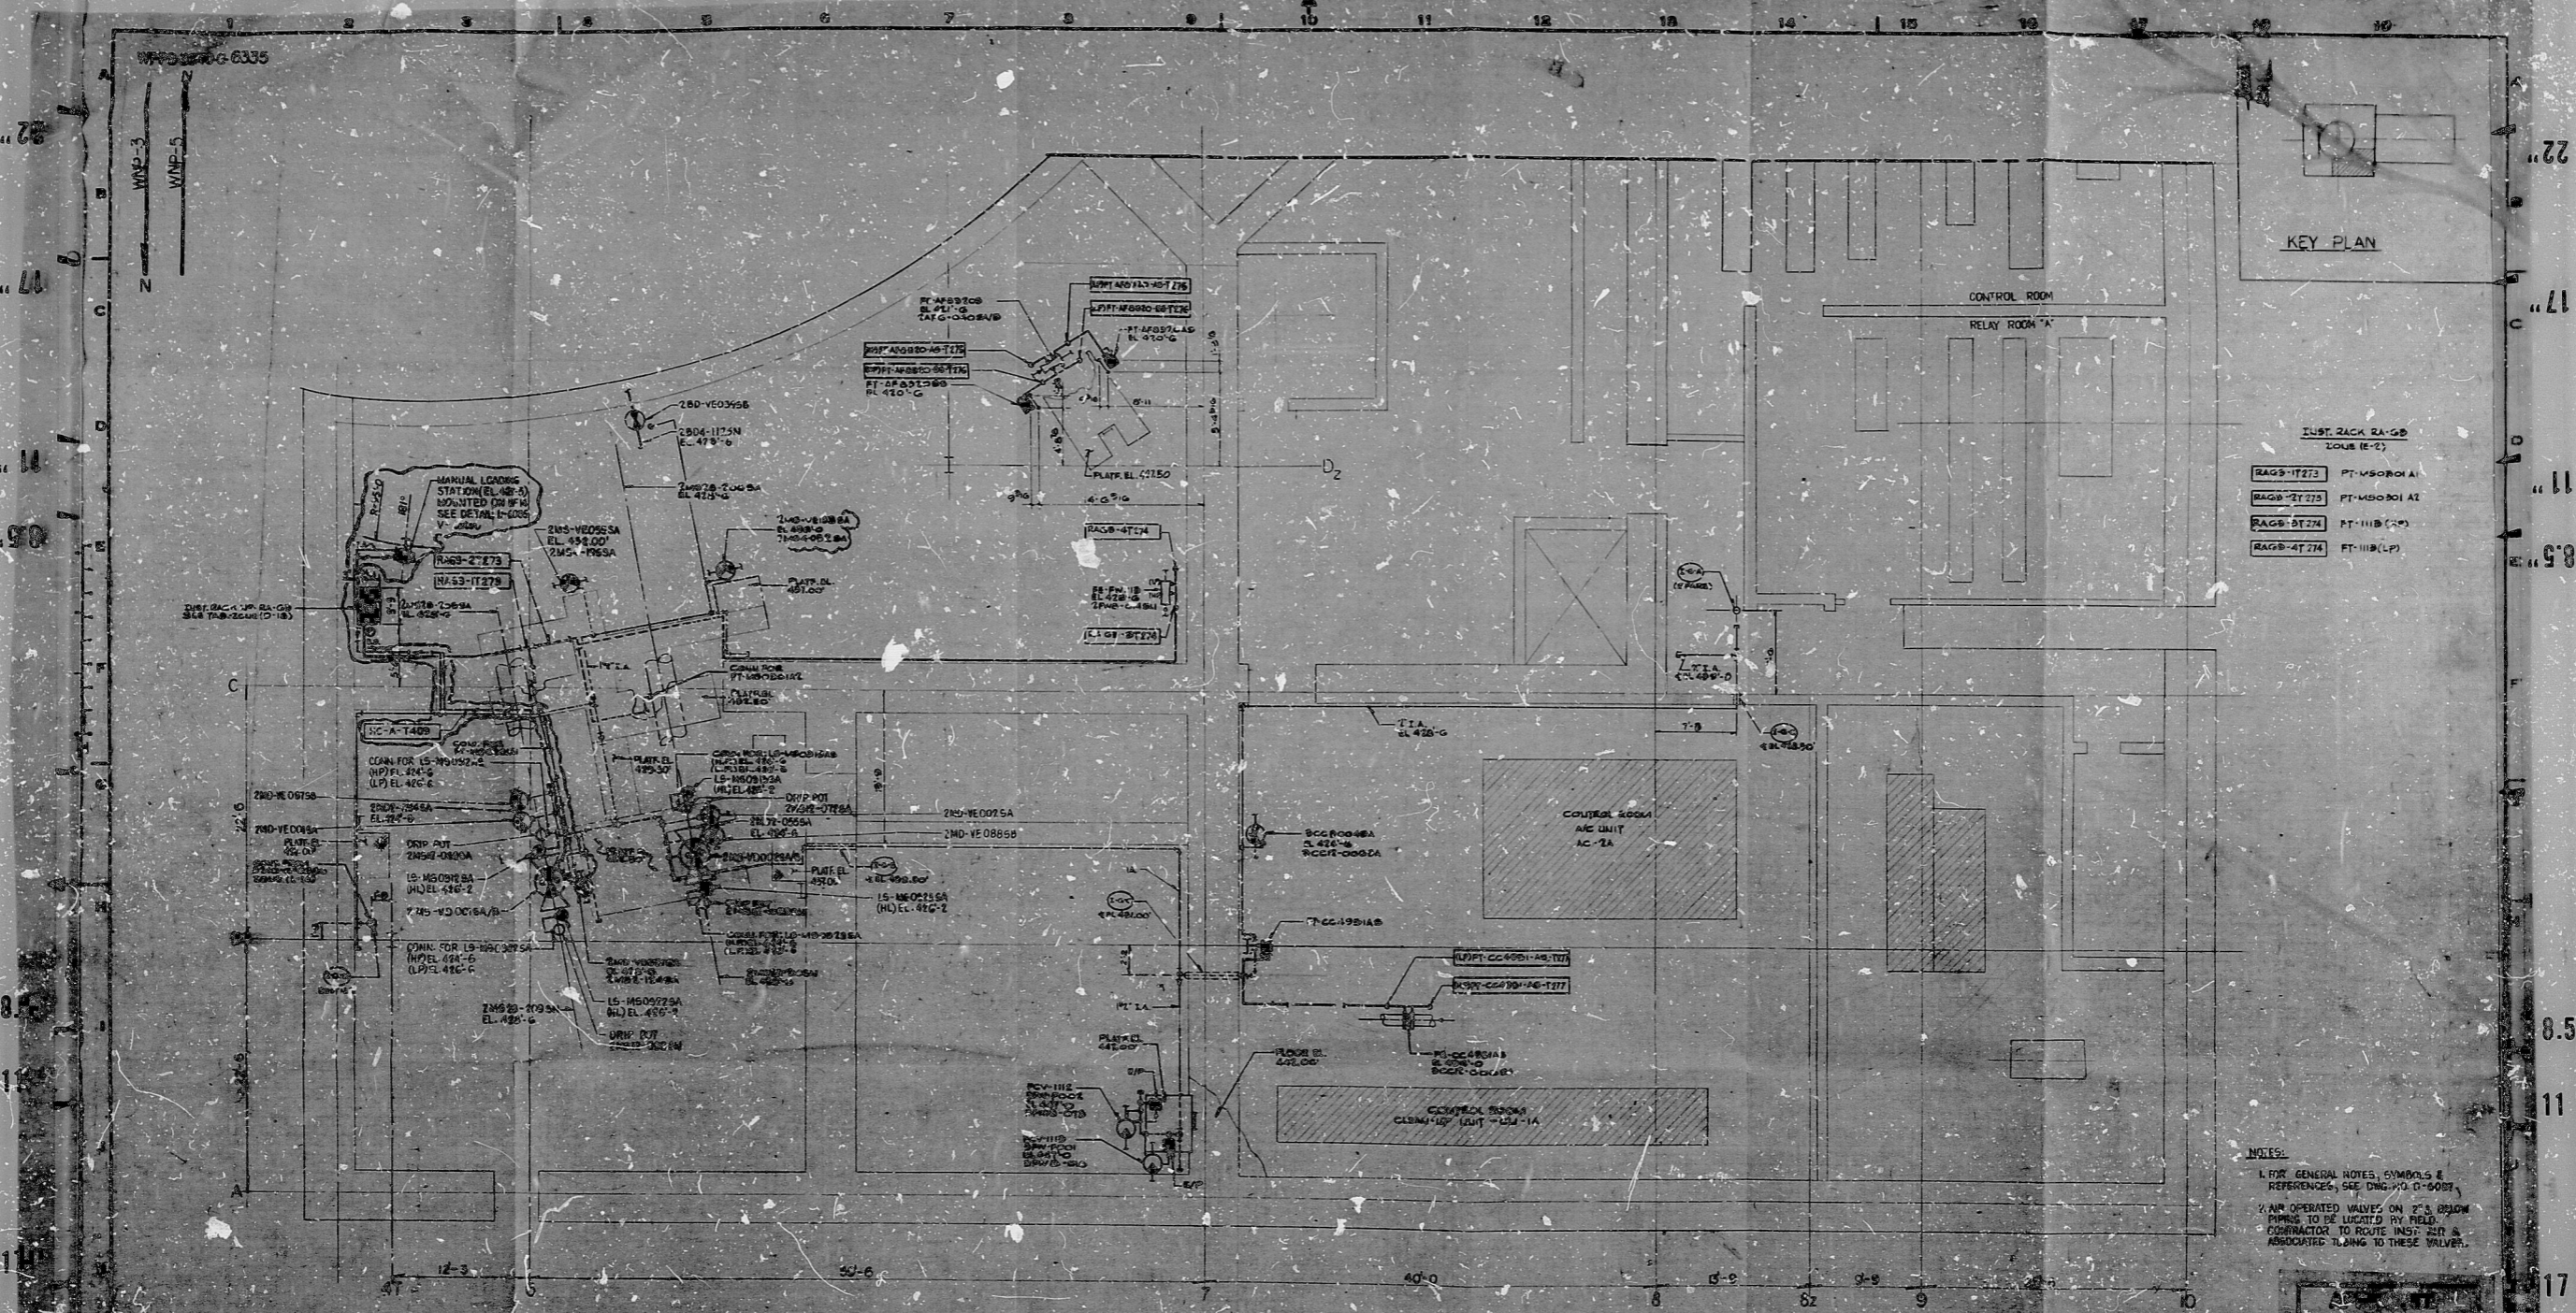

KEY PLAN

JUST RACK RANG  
ZONE (E-2)

- RAGS-1T273 FT-M50R01A1
- RAGS-2T273 FT-M50R01A2
- RAGS-3T274 FT-111B(C)2
- RAGS-4T274 FT-111B(L)P

NOTES:

1. FOR GENERAL NOTES, SYMBOLS & REFERENCES, SEE DWG. NO. D-5007
2. AIR OPERATED VALVES ON 2" & BELOW PIPING TO BE LIFTED BY FIELD CONTRACTOR TO ROUTE INSULATION & ASSOCIATED PIPING TO THESE VALVES.

PARTIAL PLAN EL. 417.50

3

34

RIDS

8303010187

