


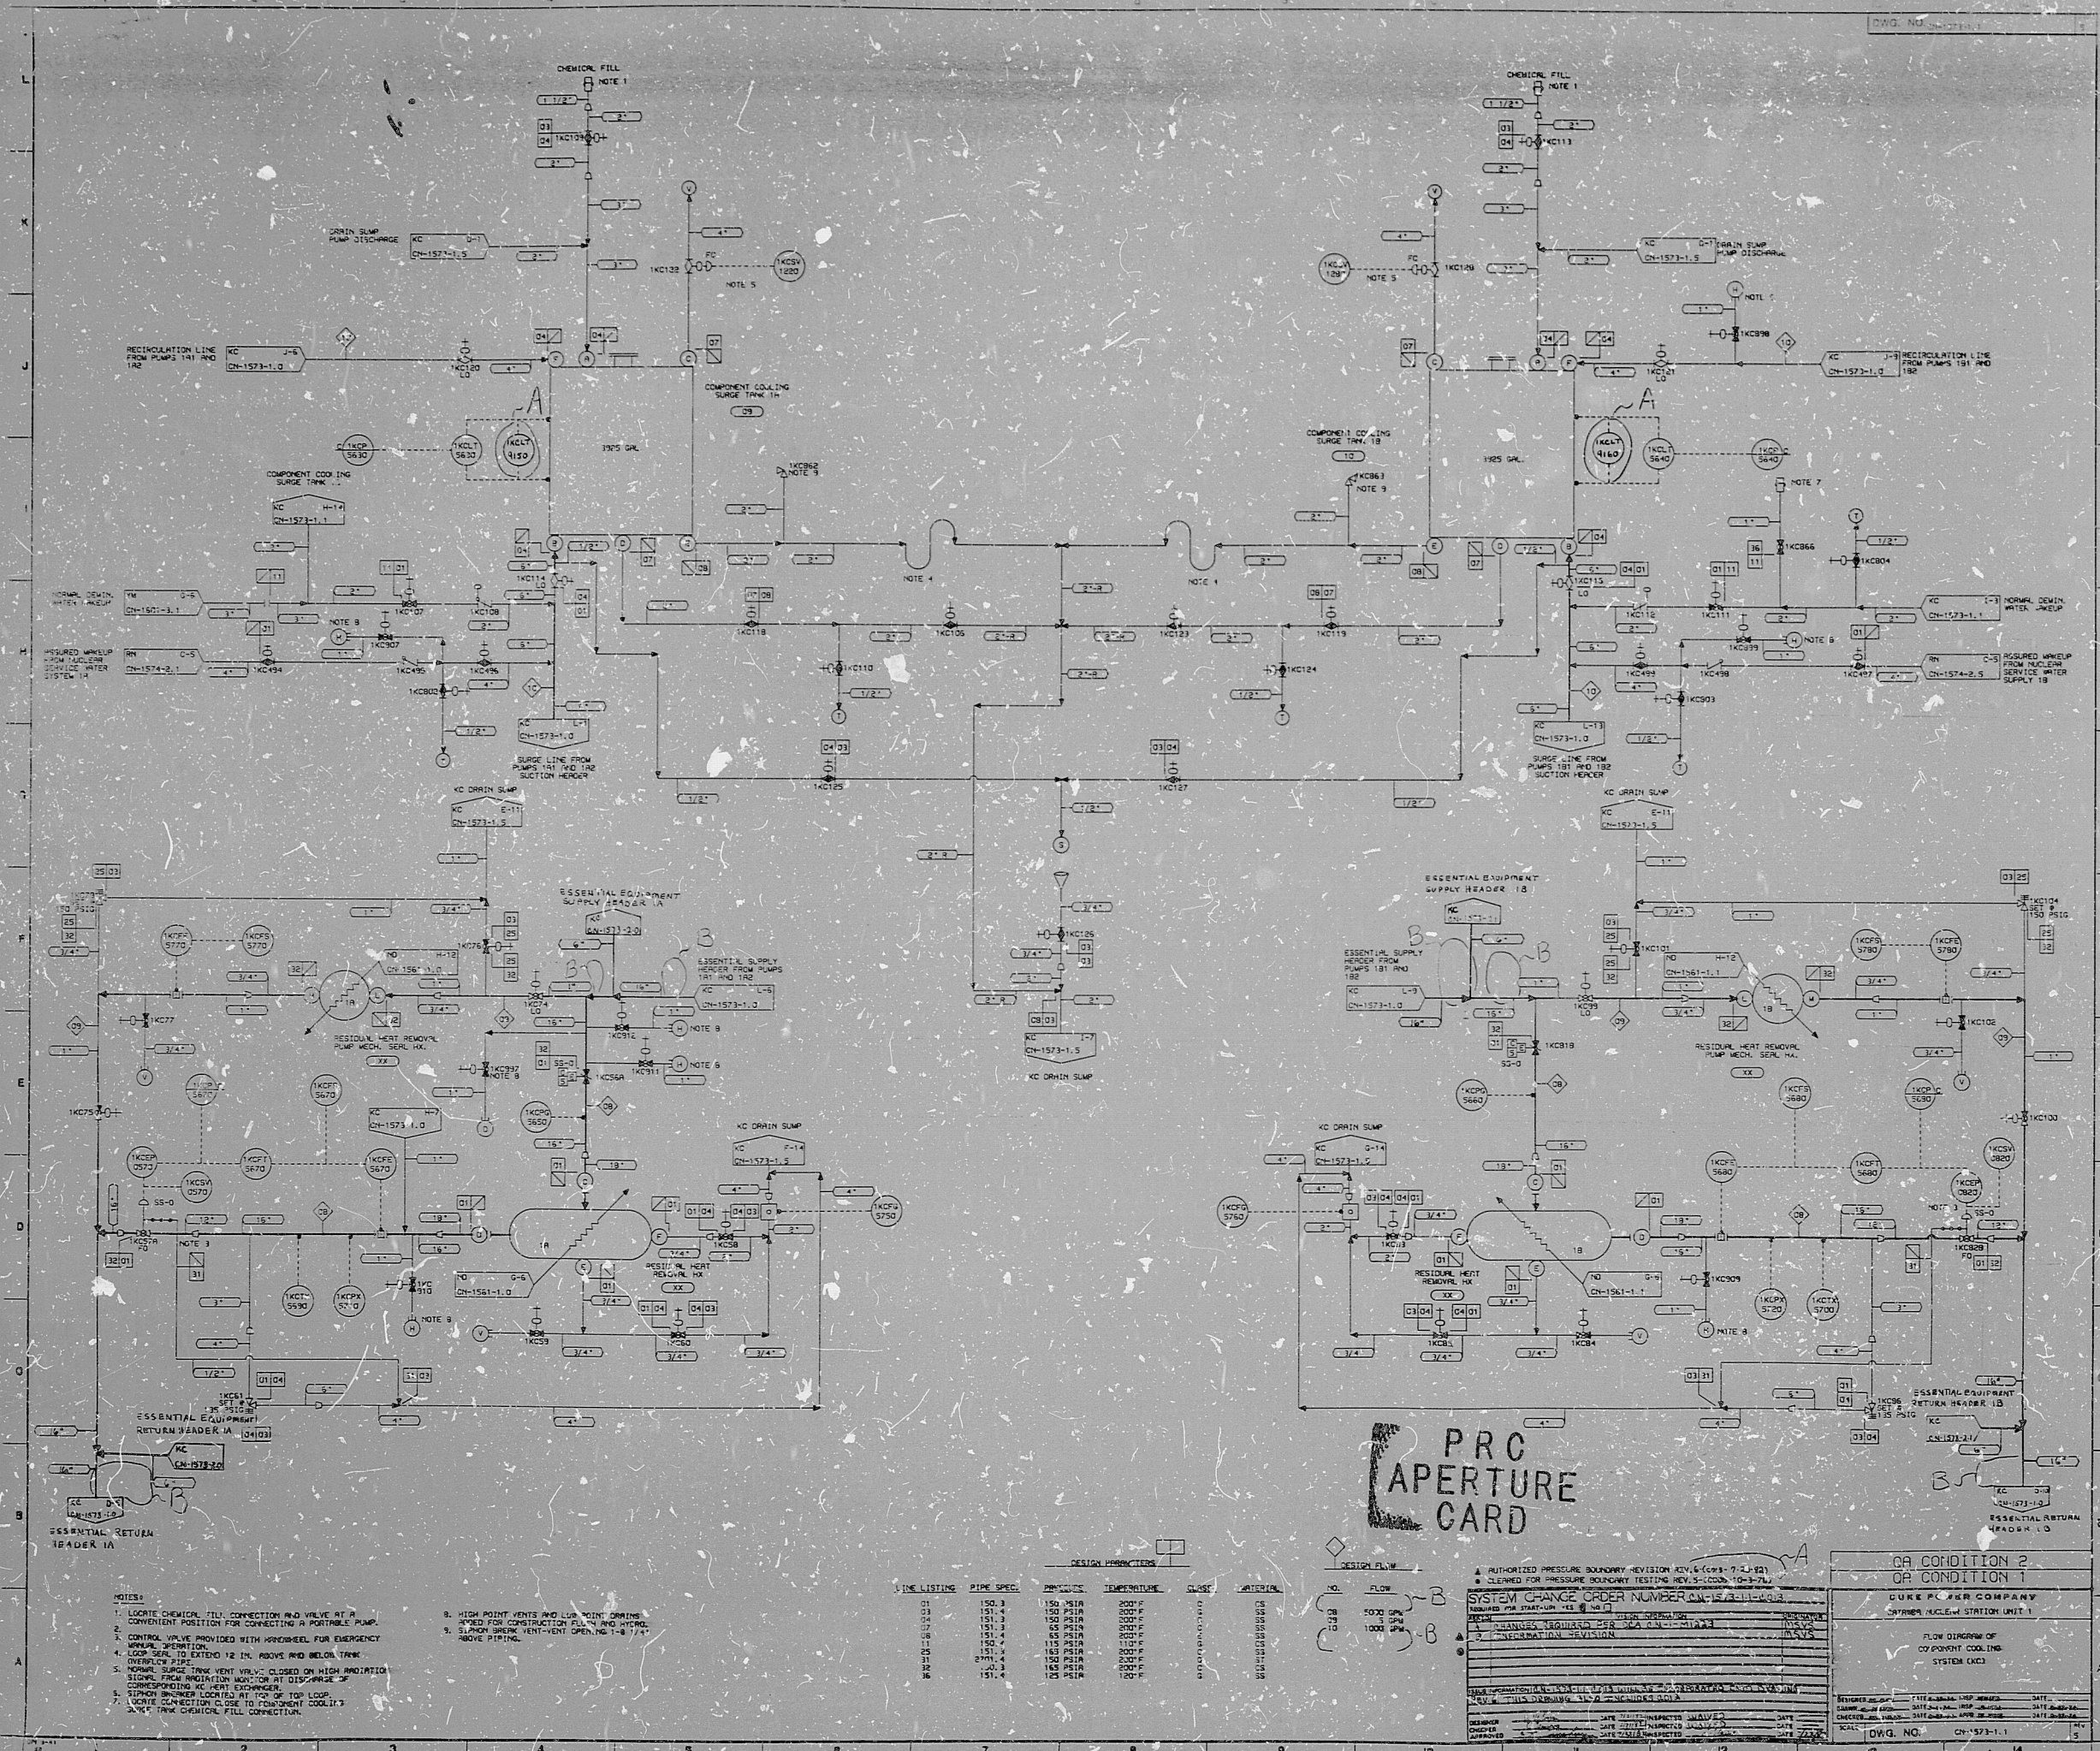

8303020354

RID3

