


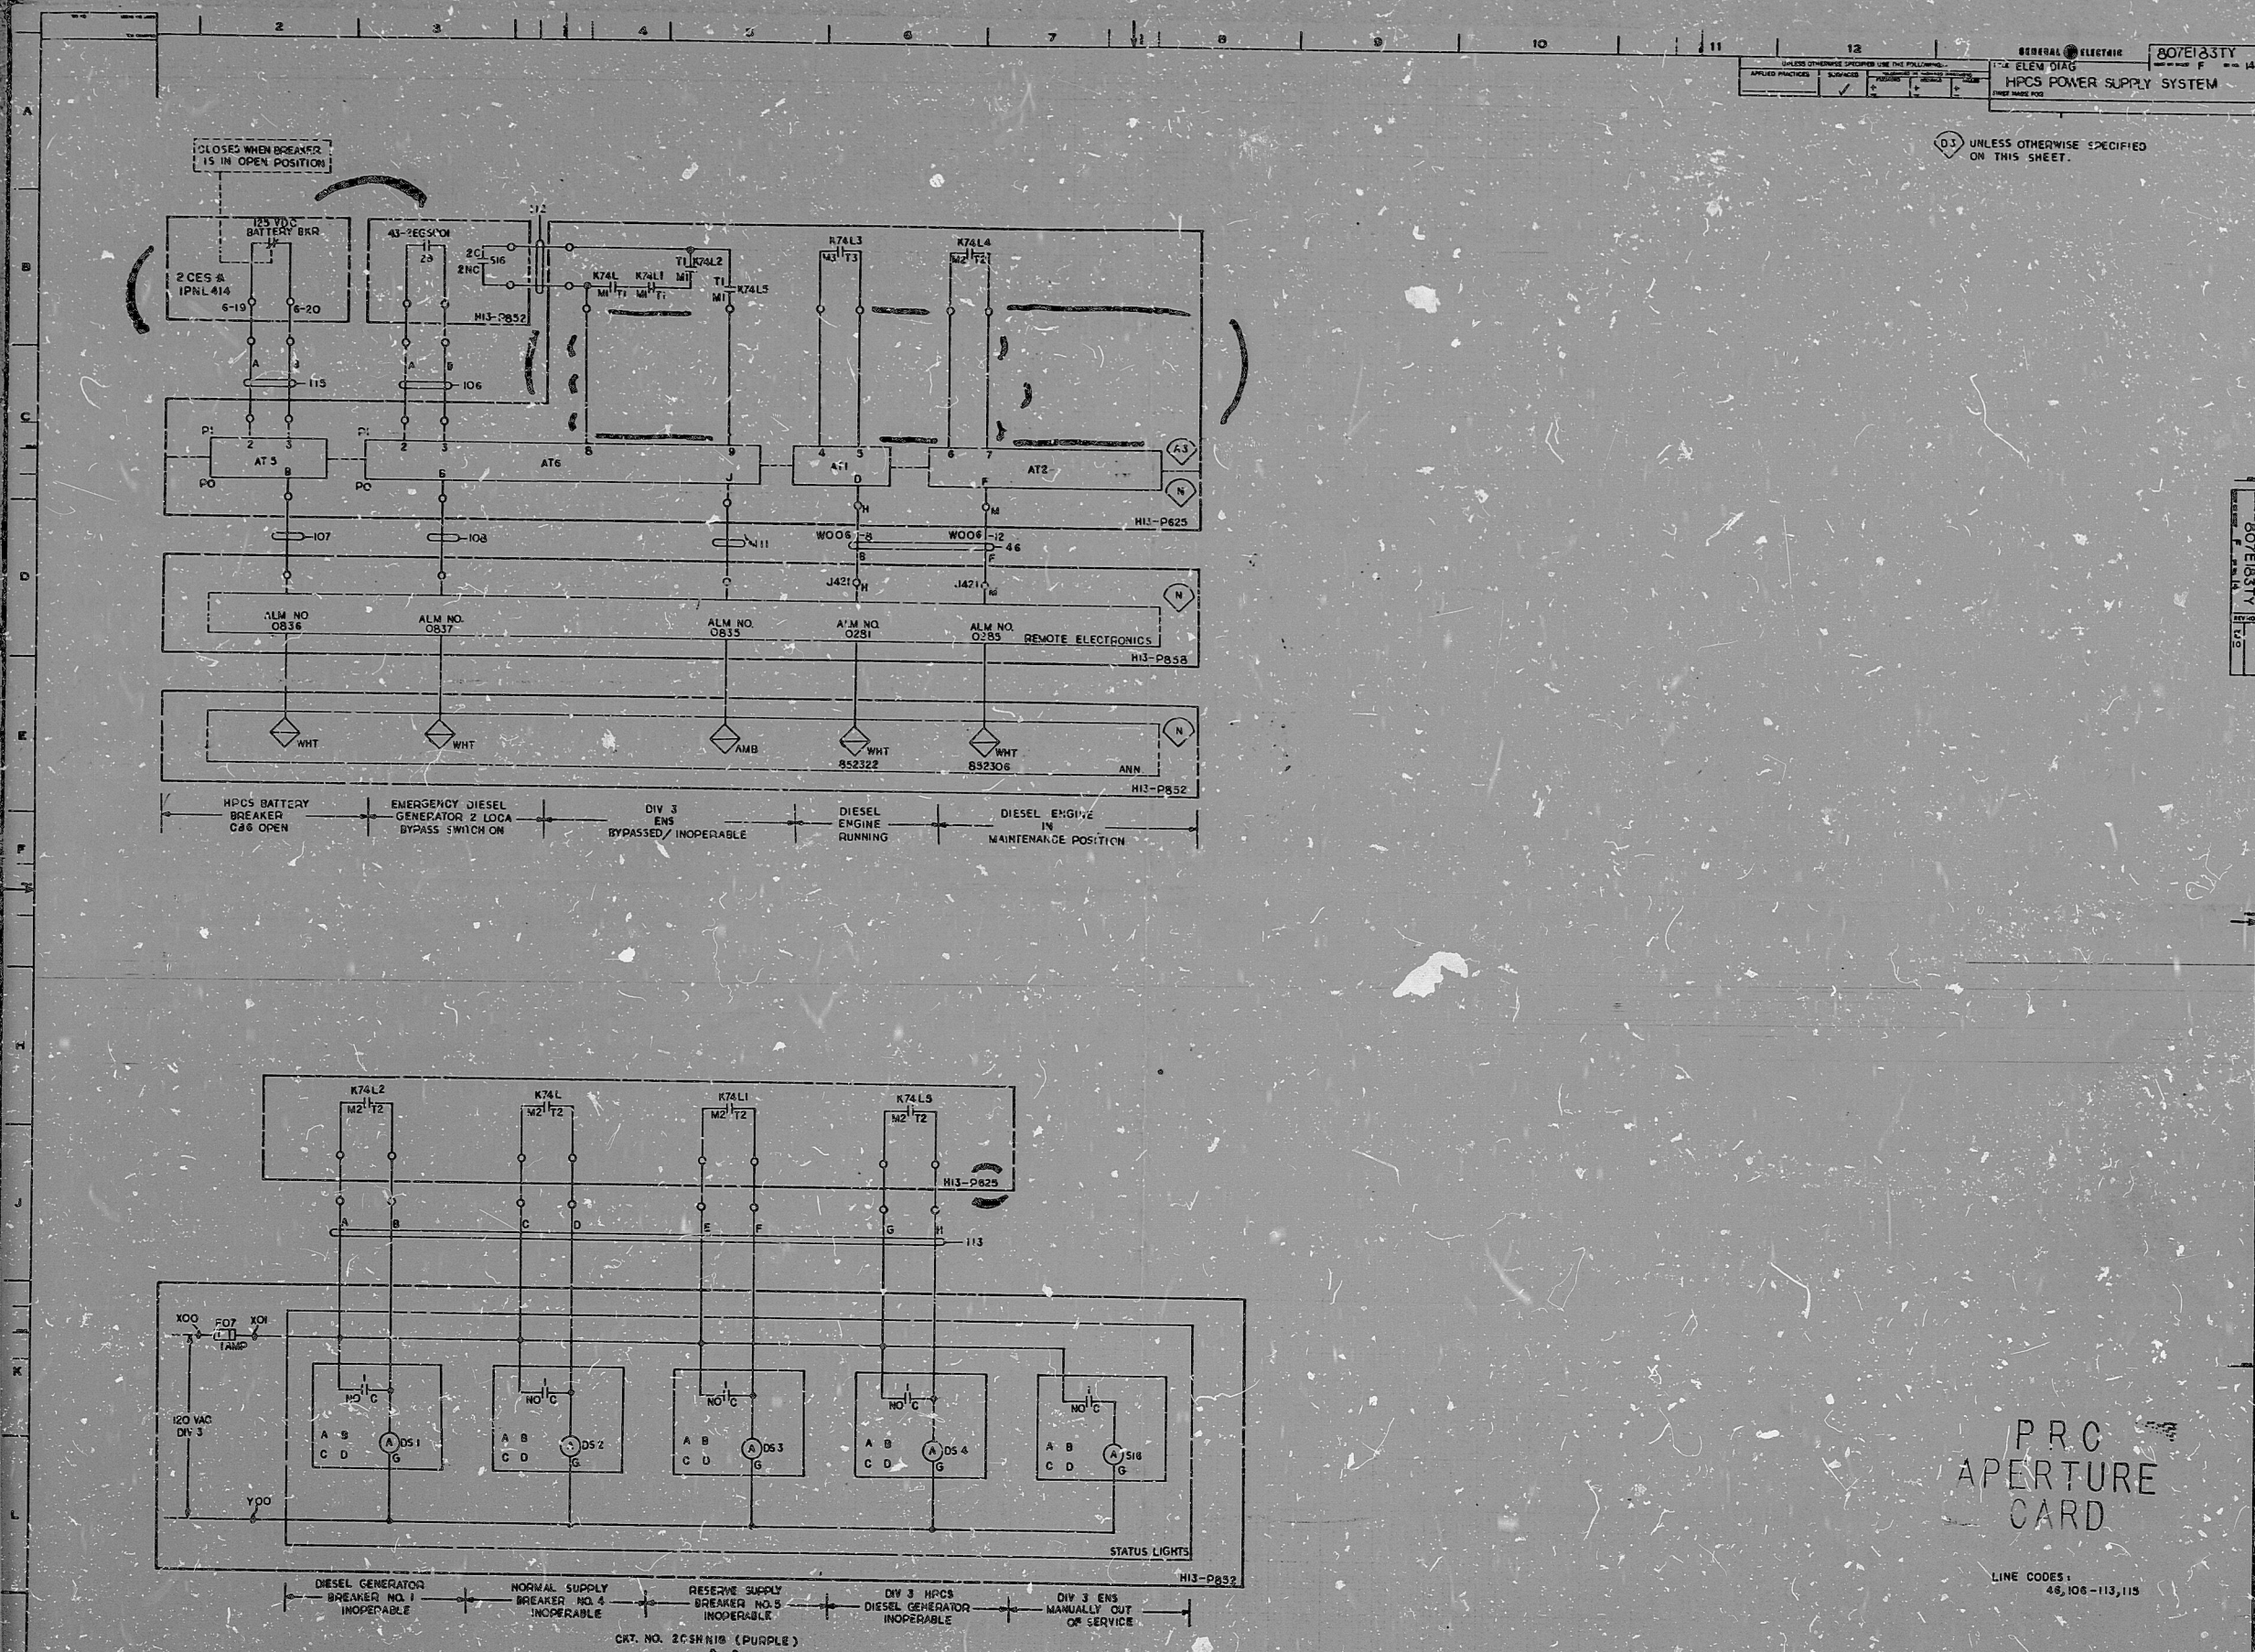

PRC
APERTURE
CARD

LINE CODES:
48, 106-113, 115



PDR RIDS

8401310266

