


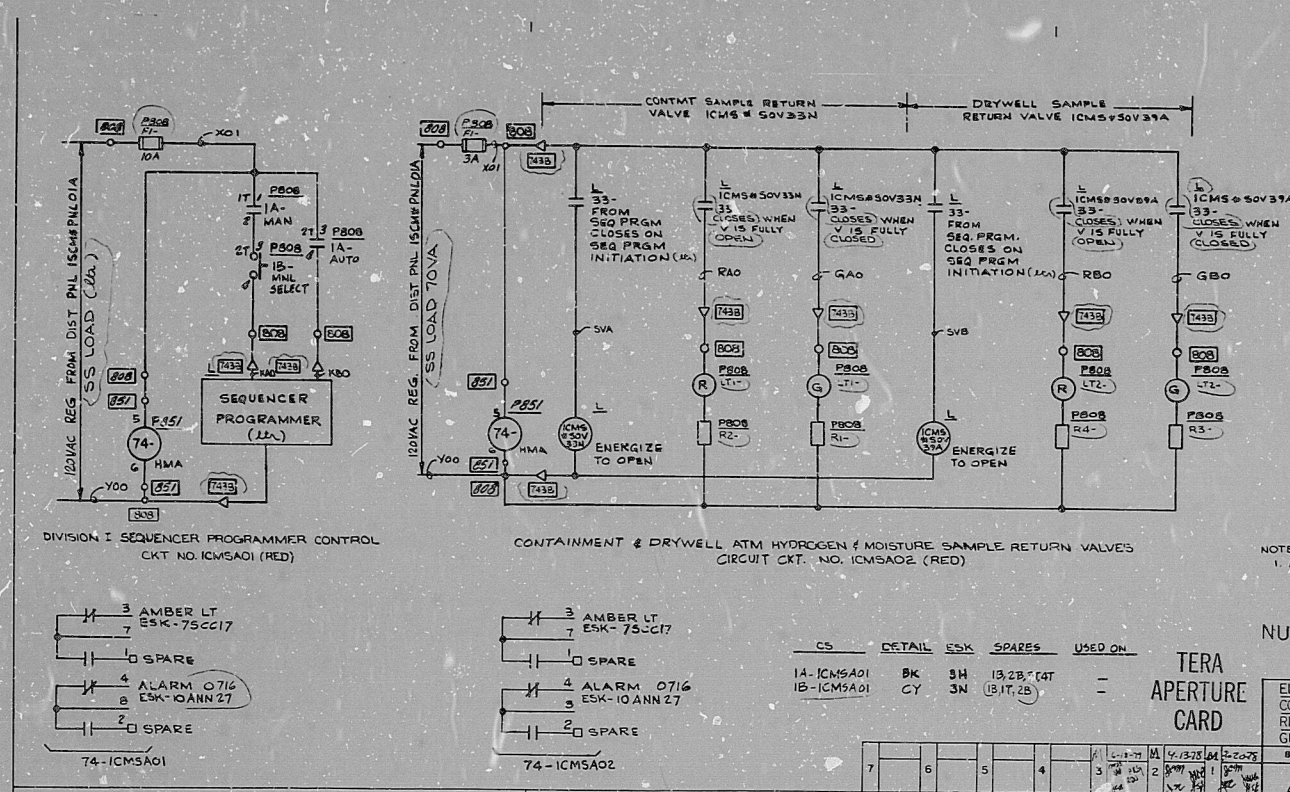

DESIGN CHANGE IN PROGRESS
REISSUE REQUIRED FOR FSAR

SEPIA COPY

RIDS

8109250055

